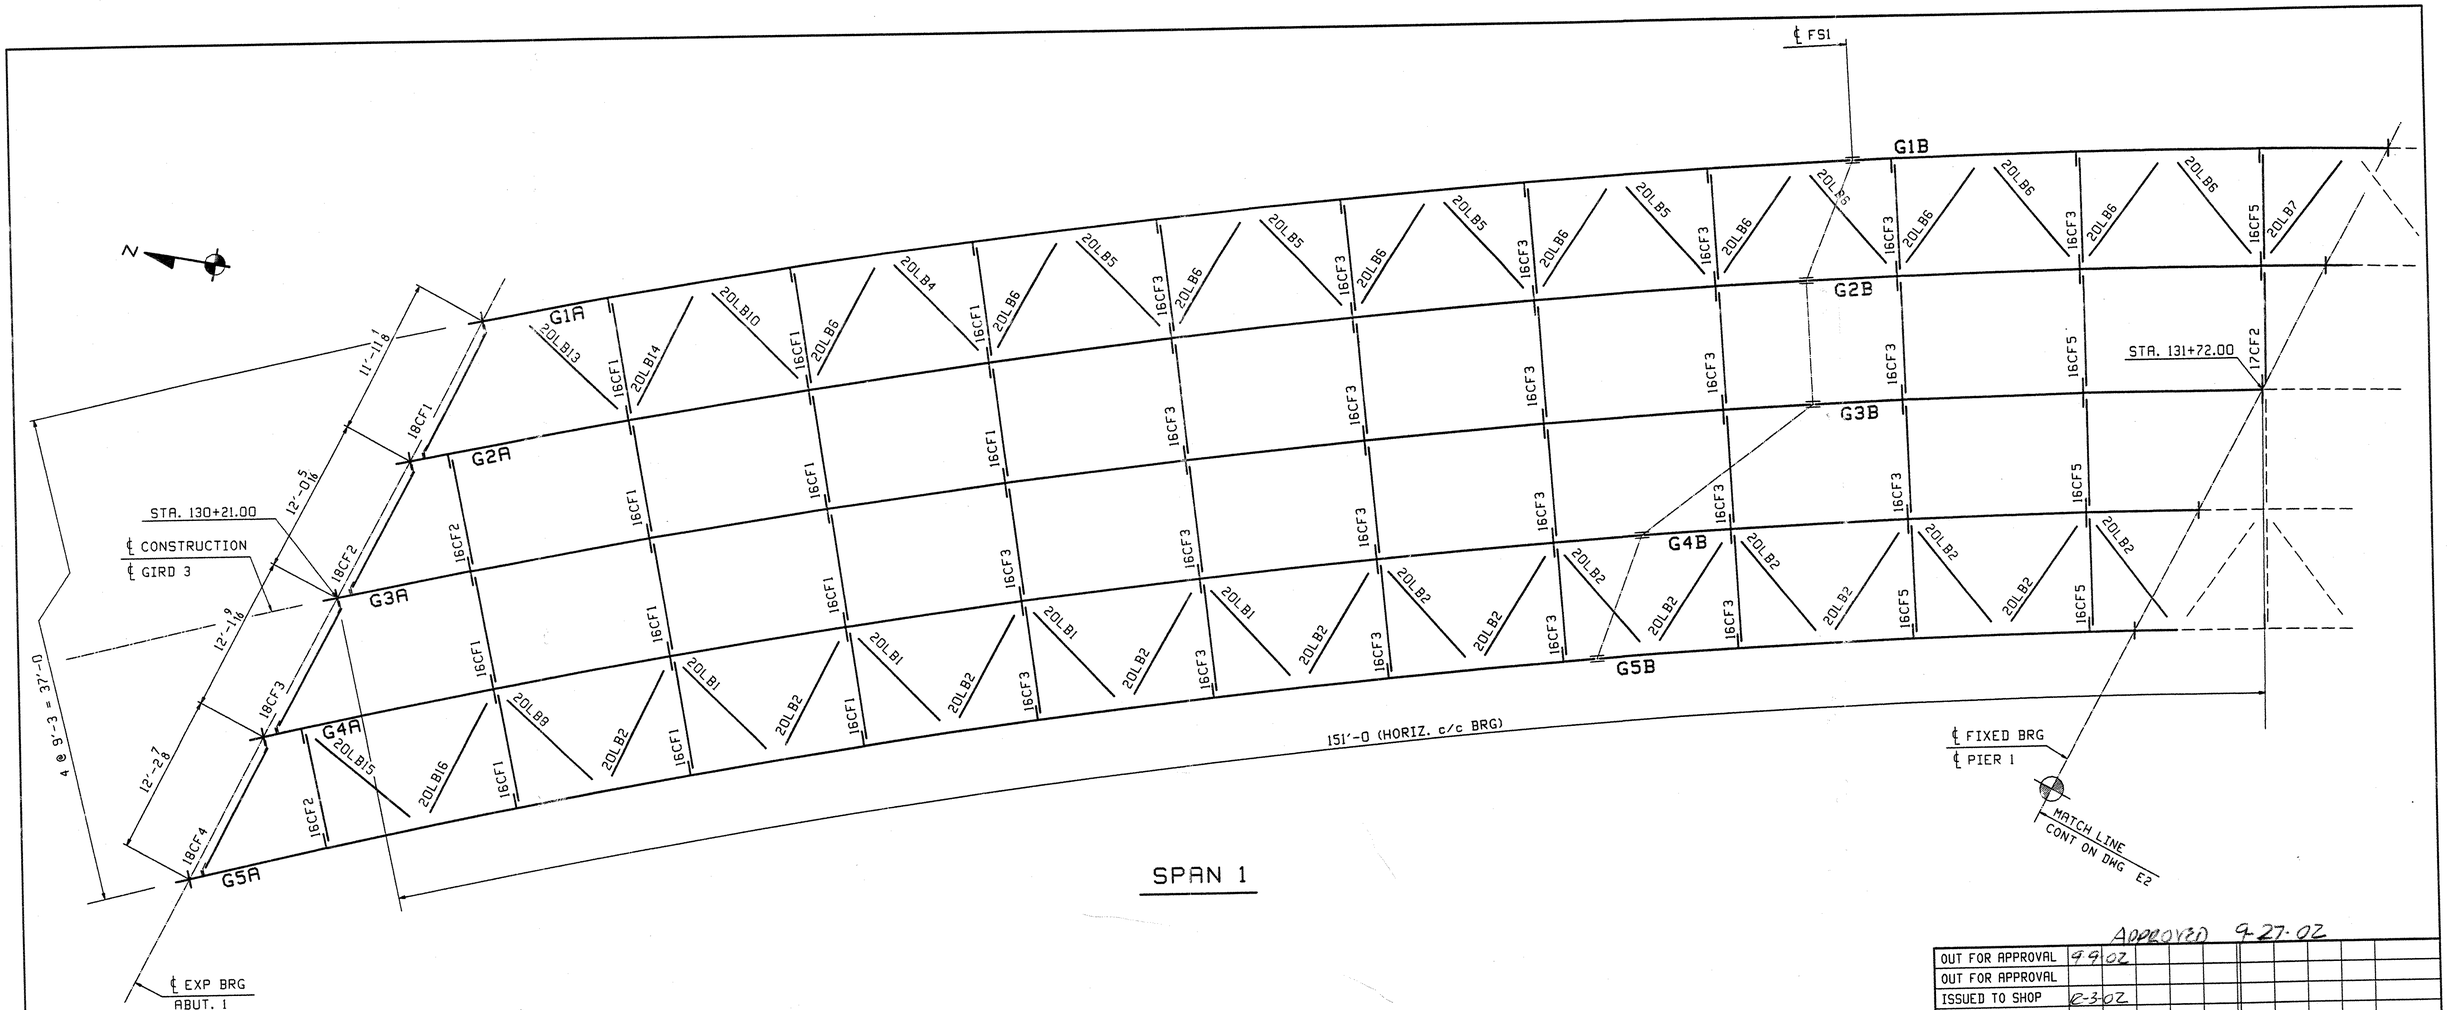

SPAN 1

RECEIVED
CK'D BY _____ OK'D BY _____
MAR 06 2003
RESUBMIT _____ APPROVED ✓
BY RPW DATE 3-6-03

APPROVED 9-27-02

REV.	REMARKS	DATE	DWN	CHK	APP	Q.A.
	OUT FOR APPROVAL	9-9-02				
	OUT FOR APPROVAL					
	ISSUED TO SHOP	12-3-02				
	FIELD & OFFICE					
1	CORRECTED ALL LAT MARKS	02/28/03	VWJ	DO		

NO.	DIA.	LGT	TYPE	WASHER

MATERIAL:	ELECTRODES:	HOLES:	SHOP BOLTS:
M270-50W			

SURFACE PREP. & PAINT:
-STEEL WITHIN 10'-0 ENDS OF GIRDERS SHALL BE PAINTED (SEE GN1)
-ALL OTHER STEEL SHALL BE BLAST CLEANED AND LEFT UNPAINTED.

DESCRIPTION: FRAMING PLAN

JOB: VT RTE 9 OVER THE DEERFIELD RIVER
BRIDGE NO. 25A
SEARSBURG, VERMONT
CONTRACTOR: J.A. McDONALD

TENSOR 2242

PROJ NO. PROJ. NHF 010-1(18)

CUSTOMER: VERMONT AGENCY OF TRANSPORTATION

DRAWN BY	DATE		
VWJ	08/14		
CHKD BY			
DO	08/29		
APPROV BY			
SUPERVISOR	W. J. GATTI		
Q.A.			

CASCO BAY STEEL STRUCTURES, INC.
75 SPRING HILL ROAD SACO, MAINE 04072
PHONE (207) 282-7360 FAX. (207) 282-1179

JOB NO.	DRG. NO.
166	E1
	REV. 1

WORK WITH E2 & E3.

635-BR25A-E-1

Fri Feb 28 16:08:34 EST 2003 /users/jobs/2242/E1.dwg DO