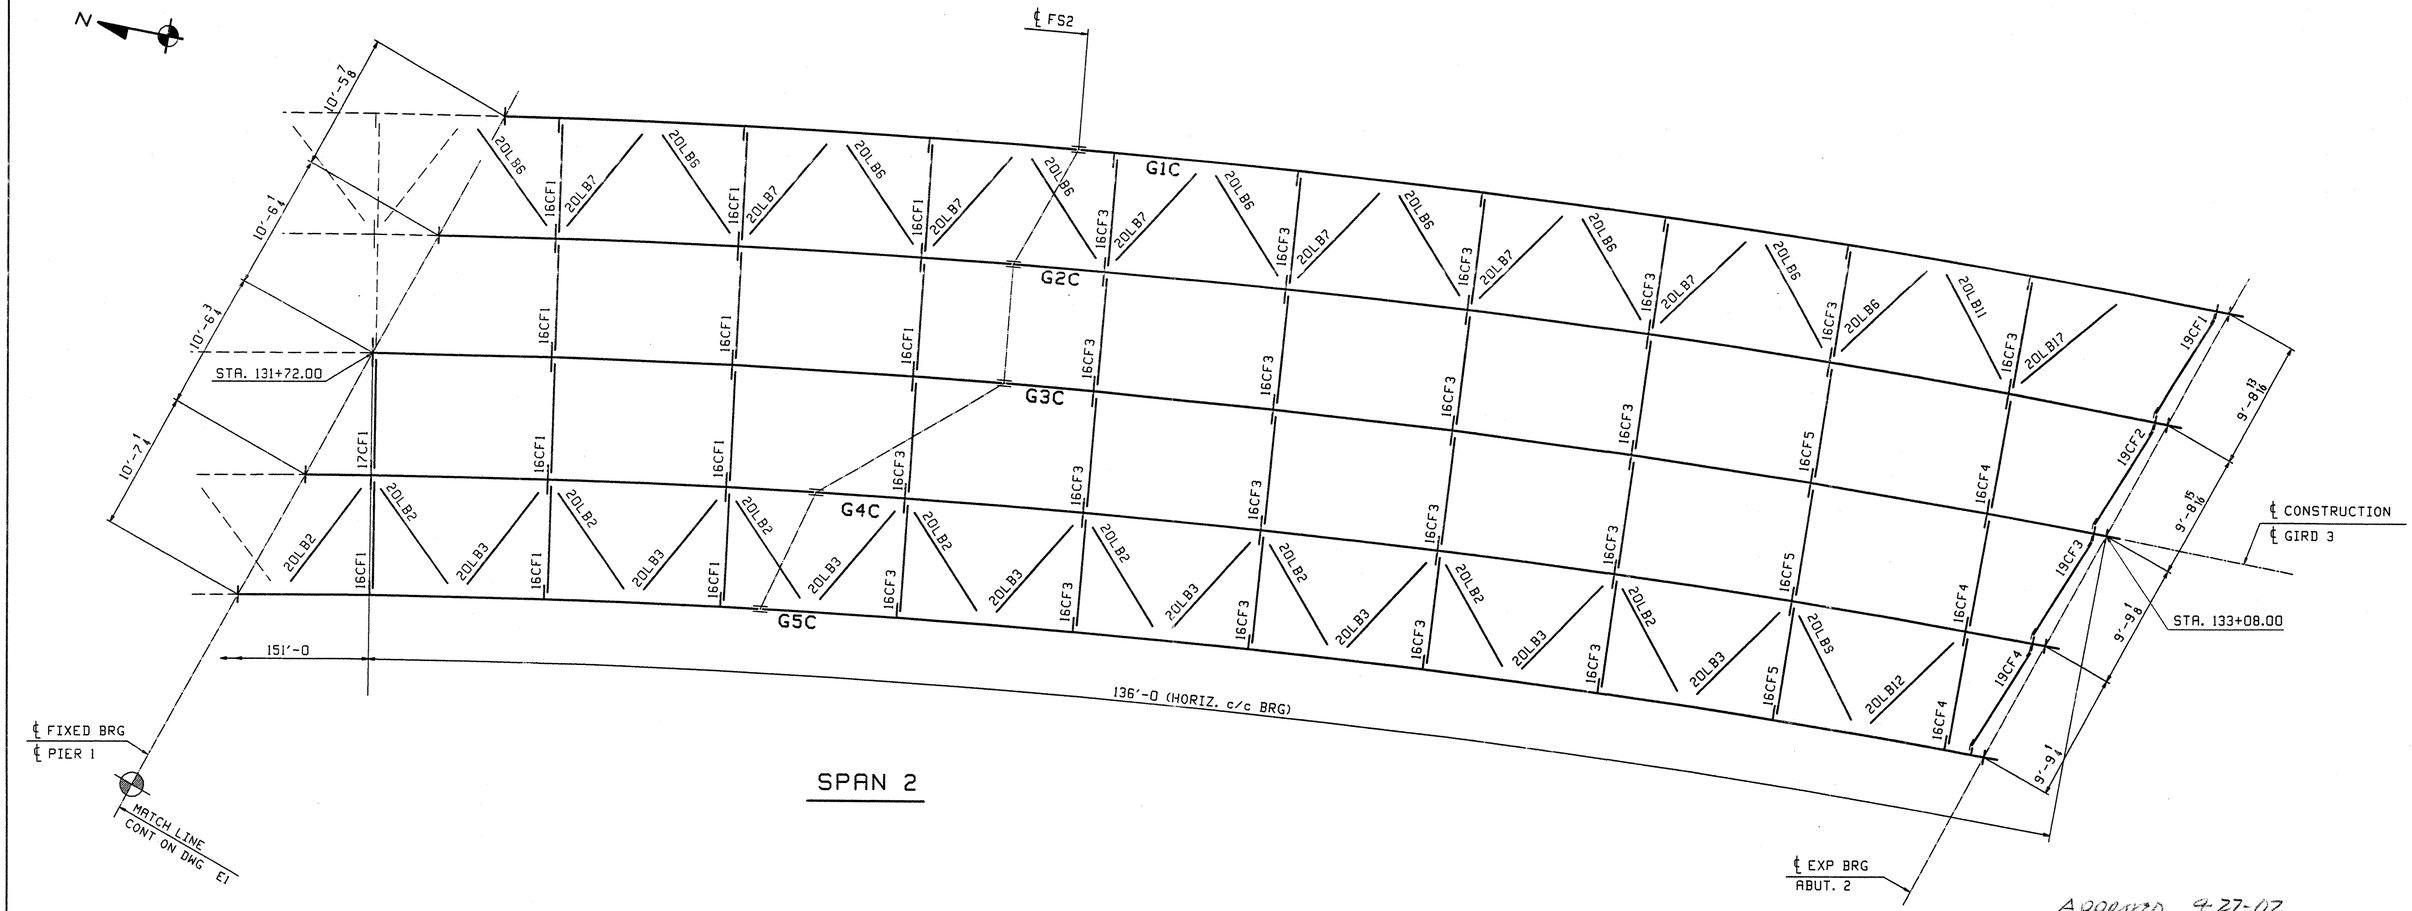

SPAN 2

ADDENDUM 9-27-02

REV.	REMARKS	DATE	DWN	CHK	APP	Q.A.	NO.	DIA.	LGT	TYPE	WASHER
	OUT FOR APPROVAL	7-9-02									
	OUT FOR APPROVAL										
	ISSUED TO SHOP	12-3-02									
	FIELD & OFFICE										
1	CORRECTED ALL LAT MARKS	02/28/03	VWJ	DO							

MATERIAL:	ELECTRODES:	HOLES:	SHOP BOLTS:
M270-50W			

SURFACE PREP. & PAINT:
-STEEL WITHIN 10'-0 ENDS OF GIRDERS SHALL BE PAINTED (SEE GN1)
-ALL OTHER STEEL SHALL BE BLAST CLEANED AND LEFT UNPAINTED.

RECEIVED
MAR 0 6 2003
RESUBMIT ____ APPROVED ✓
BY RRW DATE 3-6-03

WORK WITH E1 & E3.

DESCRIPTION: FRAMING PLAN		DRAWN BY	DATE
JOB: VT RTE 9 OVER THE DEERFIELD RIVER		VWJ	08/14
BRIDGE NO. 25A		CHKD BY	
SEARSBURG, VERMONT		DO	08/29
TENSOR 2242 CONTRACTOR: J.A. McDONALD		APPROV BY	
		SUPERVISOR	W. J. GATTI
PROJ NO. PROJ. NHF 010-1(18)		Q.A.	
CUSTOMER: VERMONT AGENCY OF TRANSPORTATION			

CASCO BAY STEEL STRUCTURES, INC.
75 SPRING HILL ROAD SACO, MAINE 04072
PHONE (207) 282-7360 FAX. (207) 282-1179

JOB NO.	DRG. NO.
166	E2
	REV. 1

636-BR25A E2

DO Fri Feb 28 16:16:45 EST 2003 /users/jobs/2242/E2.dwg