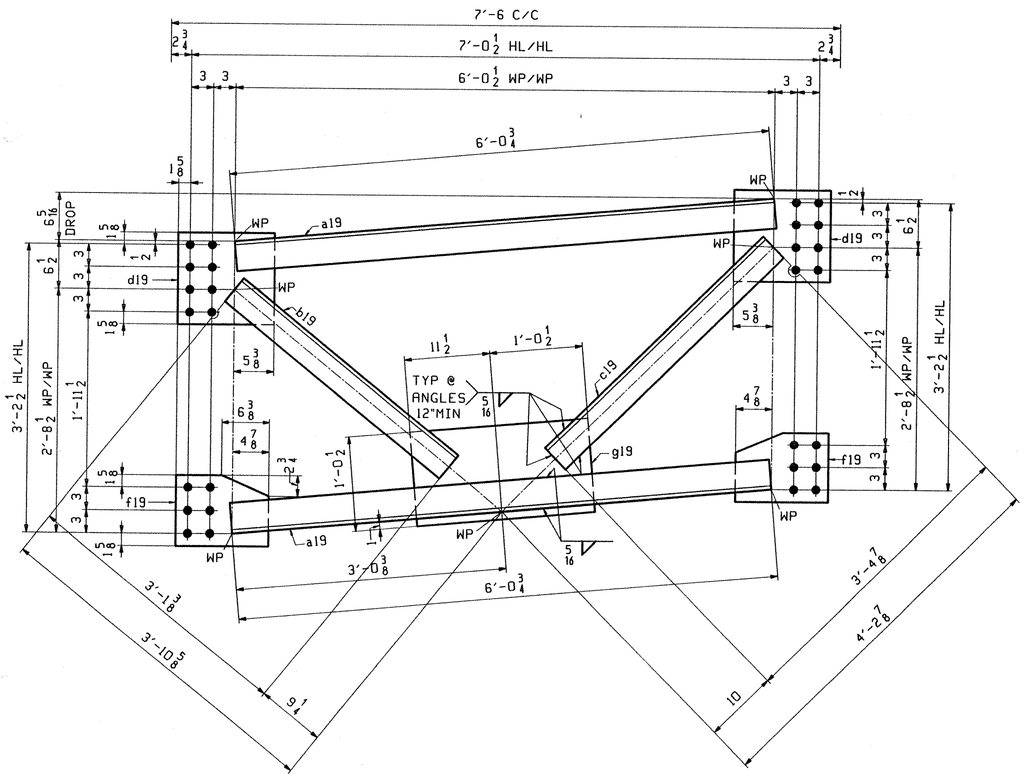

66 ~ INTERMEDIATE CROSSFRAMES ~ 19CF1 (UNPAINTED)

6 ~ INTERMEDIATE CROSSFRAMES ~ 19CF2 (PAINTED)

ABM INFO		SHIP	BILL OF MATERIAL					JOB NO.	DRAWING NO.		REV.
									19		
PAGE	LINE	MARK	QTY	MARK	MATERIAL	LENGTH FT	LENGTH INCHES	REMARKS	WT	PROCUREMENT NOTES	
		19CF1	66		CROSSFRAME				413		
6	B		132	a19	L 4x4x5/8	6	0 3/4	(M270-50WT2) (H2-3)			
6	C		66	b19	L 4x4x5/8	3	1 3/8	(M270-50WT2) (H2-3)			
6	C		66	c19	L 4x4x5/8	3	4 7/8	(M270-50WT2) (H2-3)			
6	D		132	d19	PL 1/2x12 1/4	1	1	(M270-50WT2) (H2-3)			
6	E		132	f19	PL 1/2x9 1/4	1	0 1/2	(M270-50WT2) (H2-3)			
6	F		66	g19	PL 1/2x12 1/2	2	0	(M270-50WT2) (H2-3)			
		19CF2	6		CROSSFRAME				413		
6	B		12	a19	L 4x4x5/8	6	0 3/4	(M270-50WT2) (H2-3)			
6	C		6	b19	L 4x4x5/8	3	1 3/8	(M270-50WT2) (H2-3)			
6	C		6	c19	L 4x4x5/8	3	4 7/8	(M270-50WT2) (H2-3)			
6	D		12	d19	PL 1/2x12 1/4	1	1	(M270-50WT2) (H2-3)			
6	E		12	f19	PL 1/2x9 1/4	1	0 1/2	(M270-50WT2) (H2-3)			
6	F		6	g19	PL 1/2x12 1/2	2	0	(M270-50WT2) (H2-3)			

REV.	REMARKS	DATE	DWN	CHK	APP	Q.A.
	OUT FOR APPROVAL	9/13/02				
	OUT FOR APPROVAL					
	ISSUED TO SHOP					
	FIELD & OFFICE					

NO.	DIA.	LGT	TYPE	WASHER

MATERIAL:

ELECTRODES:

HOLES: 15/16Ø

SHOP BOLTS:

SURFACE PREP. & PAINT:

RECEIVED
OK'D BY RJV OK'D BY
SEP 16 2002
RESUBMIT APPROVED ✓
BY RRW DATE 10-3-02

DESCRIPTION: CROSSFRAMES

JOB: VT. ROUTE 9 OVER DEERFIELD RIVER
BRIDGE 258
SEARSBURG, VERMONT
CONTRACTOR: J.A. McDONALD

TENSOR 2243

PROJ NO. NHF-010-1(18)

CUSTOMER: VERMONT AGENCY OF TRANSPORTATION

DRAWN BY	DATE
VWJ	08/19
CHKD BY	
DO	09/04
APPROV BY	
SUPERVISOR	W. J. GATTI
Q.A.	

CASCO BAY STEEL STRUCTURES, INC.
75 SPRING HILL ROAD SACO, MAINE 04072
PHONE (207) 282-7360 FAX. (207) 282-1179

JOB NO.	DRG. NO.
167	19
	REV. △

409-BR 258-S&R

VWJ Fri Sep 13 08:08:59 EDT 2002 /users/jobs/2243/19.dwg