TOWN HIGHWAY TYPICAL SECTIONS

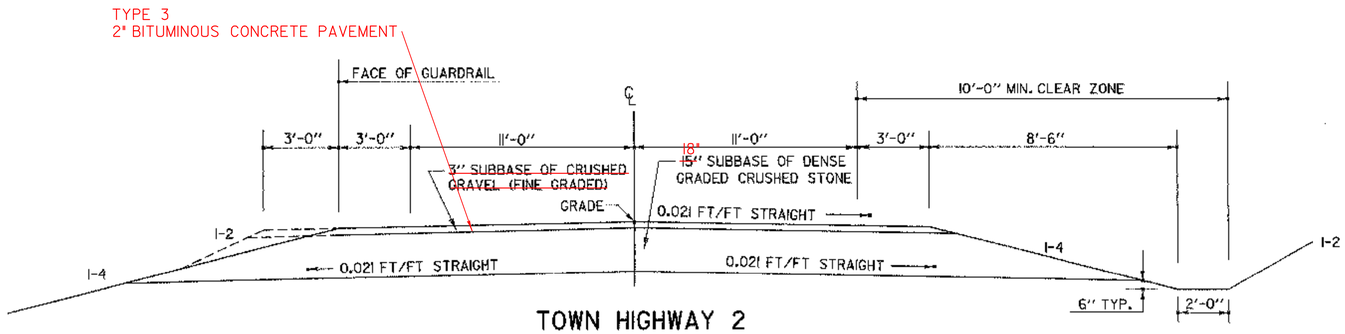

TOWN HIGHWAY 2

NORMAL SECTION

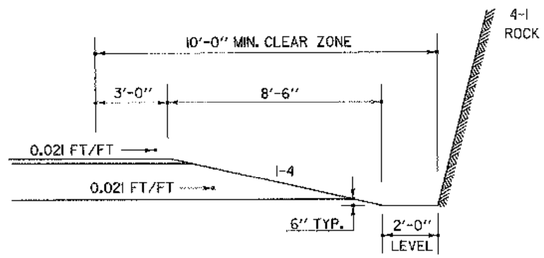

NORMAL SECTION IN ROCK CUT
(TOWN HIGHWAY 2)

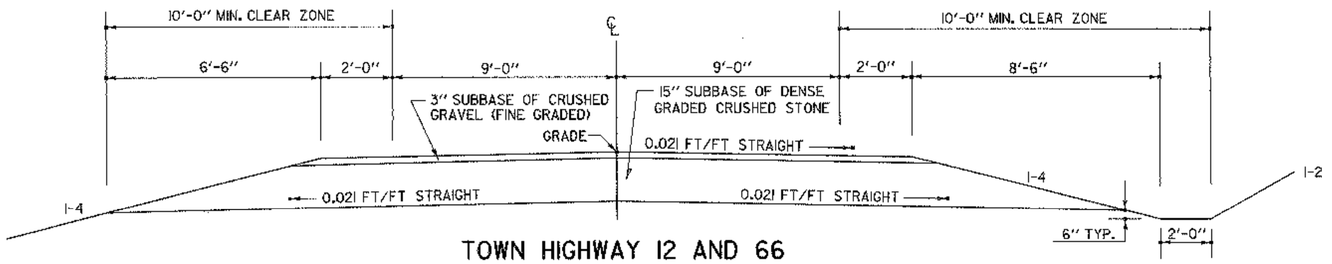

TOWN HIGHWAY 12 AND 66

NORMAL SECTION

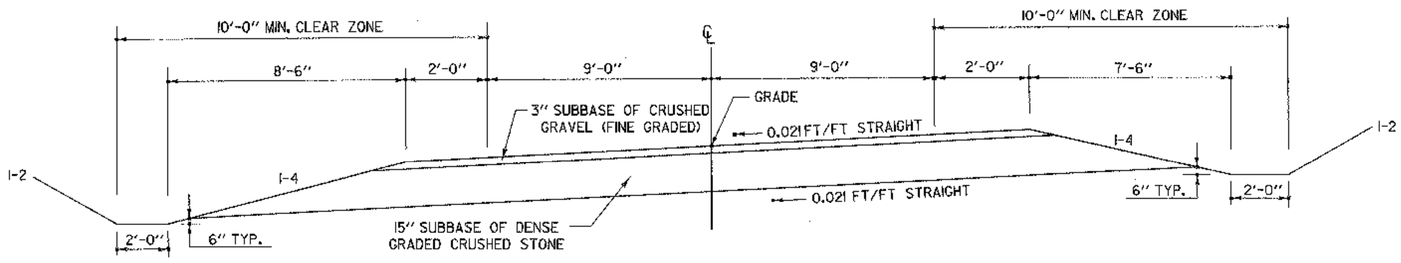

MAXIMUM BANKED SECTION 0.021 FT/FT

FOR GENERAL NOTES:
SEE SHEET 9

NOT TO SCALE

DATUM
VERTICAL _____
HORIZONTAL _____

SURVEYED BY	NYE	DATE	3/85
DRAWN BY	SQUADB	DATE	11/93 RE
SQUAD LEADER	DELLA SANTA		
DESIGN FILE NO.	/SQDB/84E058/DE058FRM.DGN		
IPARM FILE	DEI32TY2	DATE PLOTTED	04-NOV-1999
PROJ. NAME	MORETOWN		
PROJ. NO.	RSEGC-RS 0167(9)		
SHEET	11 OF 243 SHEETS		