


NOTE: ACTUAL LOCATION OF PROPOSED ACCESS FOR DAM TO BE DETERMINED BY THE ENGINEER UPON CONSTRUCTION

MATCH LINE TO SHEET 15 OF 20

SHEET 18 OF 20

MATCH LINE TO SHEET 19 OF 20

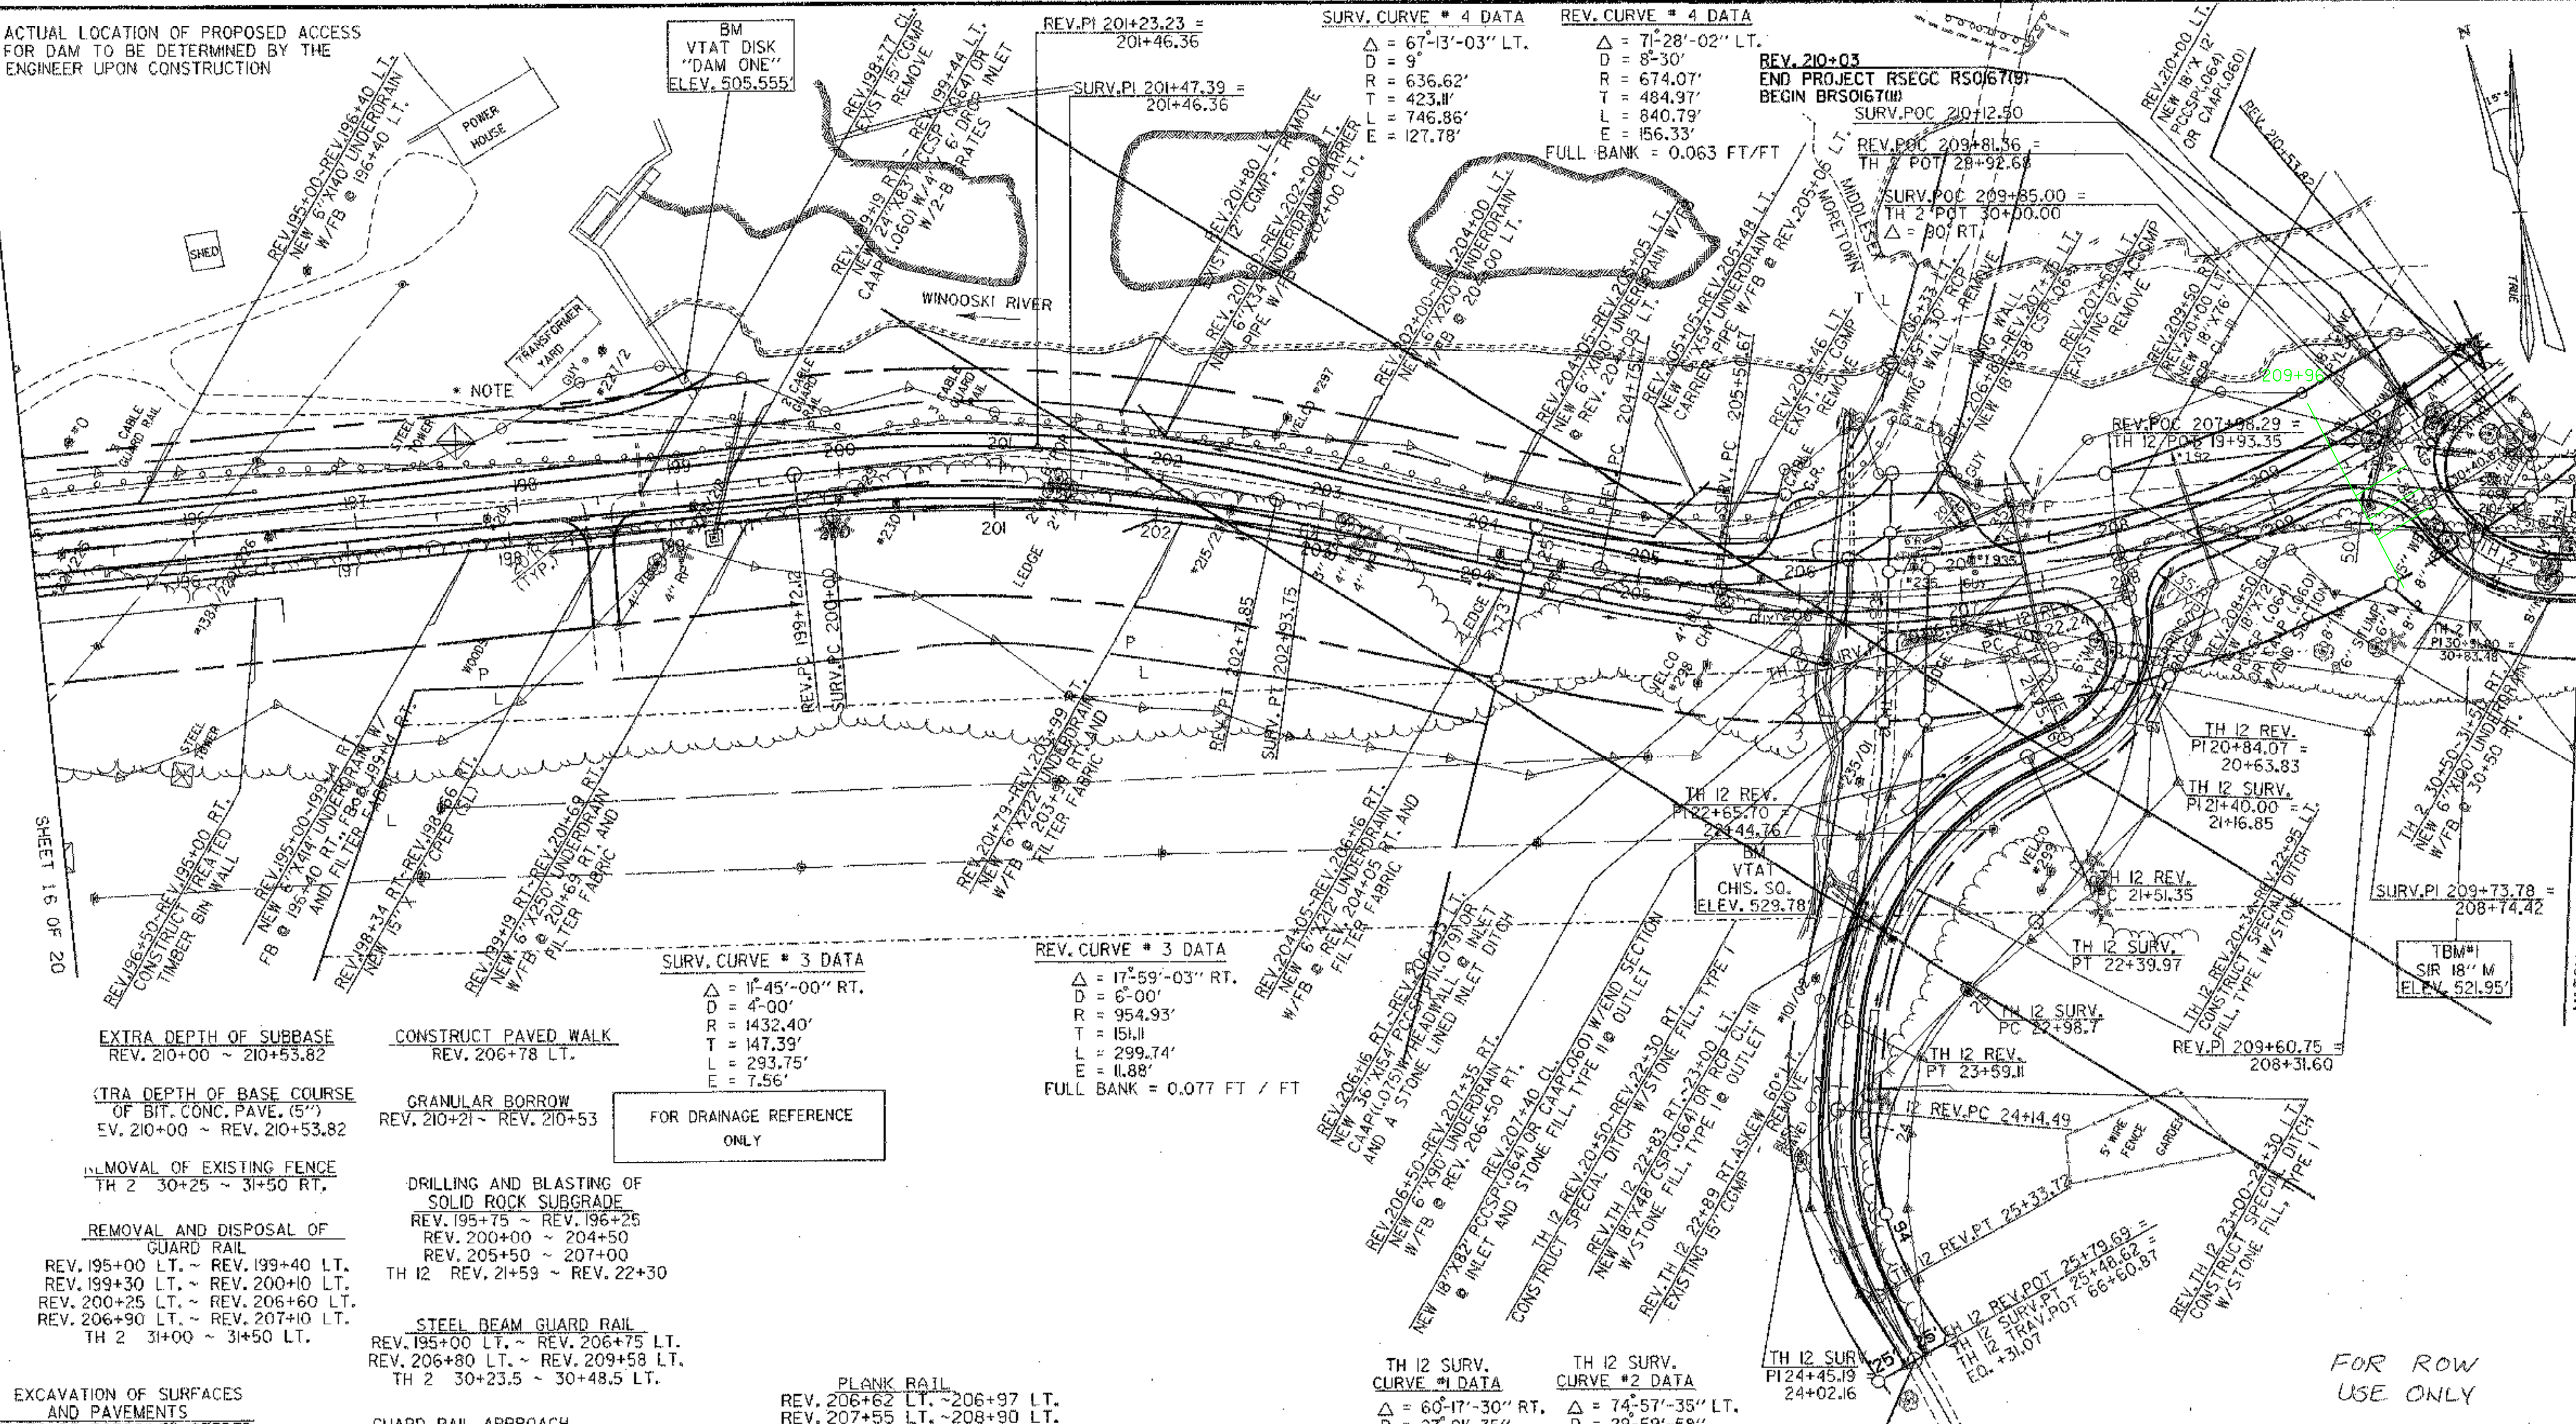

BM
VTAT DISK
"DAM ONE"
ELEV. 505.555'

SURV. CURVE # 4 DATA
 $\Delta = 67^{\circ}13'03''$ LT.
 $D = 9'$
 $R = 636.62'$
 $T = 423.11'$
 $L = 746.86'$
 $E = 127.78'$

REV. CURVE # 4 DATA
 $\Delta = 71^{\circ}28'02''$ LT.
 $D = 8^{\circ}30'$
 $R = 674.07'$
 $T = 484.97'$
 $L = 840.79'$
 $E = 156.33'$

REV. 210+03
 END PROJECT RSECC RSO167(9)
 BEGIN BRSO167(10)
 SURV. POC 210+12.50

SURV. CURVE # 3 DATA
 $\Delta = 11^{\circ}45'00''$ RT.
 $D = 4^{\circ}00'$
 $R = 1432.40'$
 $T = 147.39'$
 $L = 293.75'$
 $E = 7.56'$

REV. CURVE # 3 DATA
 $\Delta = 17^{\circ}59'03''$ RT.
 $D = 6^{\circ}00'$
 $R = 954.93'$
 $T = 151.11'$
 $L = 299.74'$
 $E = 11.88'$
 FULL BANK = 0.077 FT / FT

TH 12 SURV. CURVE #1 DATA
 $\Delta = 60^{\circ}17'30''$ RT.
 $D = 27^{\circ}01'35''$
 $R = 212.00'$
 $T = 123.12'$
 $L = 223.09'$
 $E = 33.16'$

TH 12 SURV. CURVE #2 DATA
 $\Delta = 74^{\circ}57'35''$ LT.
 $D = 29^{\circ}59'58''$
 $R = 190.99'$
 $T = 146.45'$
 $L = 249.87'$
 $E = 49.68'$

REV. 25+79.69
 END TH 12 APPROACH
 CONSTRUCTION

TH 12 REV. CURVE #1 DATA
 $\Delta = 79^{\circ}00'21''$ RT.
 $D = 76^{\circ}23'40''$
 $R = 75.00'$
 $T = 61.83'$
 $L = 103.42'$
 $E = 22.20'$

TH 12 REV. CURVE #2 DATA
 $\Delta = 59^{\circ}31'08''$ LT.
 $D = 28^{\circ}38'52''$
 $R = 200.00'$
 $T = 114.35'$
 $L = 207.76'$
 $E = 30.38'$



SCALE IN FEET

○ DENOTES REMOVAL OF TREE OR STUMP

EXTRA DEPTH OF SUBBASE
 REV. 210+00 ~ 210+53.82

CONSTRUCT PAVED WALK
 REV. 206+78 LT.

EXTRA DEPTH OF BASE COURSE
 OF BIT. CONC. PAVE. (5")
 REV. 210+00 ~ REV. 210+53.82

GRANULAR BORROW
 REV. 210+21 ~ REV. 210+53

REMOVAL OF EXISTING FENCE
 TH 2 30+25 ~ 31+50 RT.

DRILLING AND BLASTING OF
 SOLID ROCK SUBGRADE
 REV. 195+75 ~ REV. 196+25
 REV. 200+00 ~ 204+50
 REV. 205+50 ~ 207+00
 TH 12 REV. 21+59 ~ REV. 22+30

REMOVAL AND DISPOSAL OF
 GUARD RAIL
 REV. 195+00 LT. ~ REV. 199+40 LT.
 REV. 199+30 LT. ~ REV. 200+10 LT.
 REV. 200+25 LT. ~ REV. 206+60 LT.
 REV. 206+90 LT. ~ REV. 207+10 LT.
 TH 2 31+00 ~ 31+50 LT.

STEEL BEAM GUARD RAIL
 REV. 195+00 LT. ~ REV. 206+75 LT.
 REV. 206+80 LT. ~ REV. 209+58 LT.
 TH 2 30+23.5 ~ 30+48.5 LT.

EXCAVATION OF SURFACES
 AND PAVEMENTS
 AREA TO BE TOPSOILED, SEEDED
 AND MULCHED
 REV. 205+50 LT. ~ REV. 207+00 LT.
 TH 2 30+50 ~ 31+50 LT.

GUARD RAIL APPROACH
 SECTION TYPE I
 REV. 209+58 LT. ~ REV. 210+08 LT.
 TH 2 30+23.5 LT. ~ 210+53.82 RT.

PLANK RAIL
 REV. 206+62 LT. ~ 206+97 LT.
 REV. 207+55 LT. ~ 208+90 LT.

PLANK RAIL @ MIDDLESEX END
 OF BRIDGE IS BRS-0167(10)
 QUANTITY

STONE FILL TYPE II
 (FOR SLOPE STABILIZATION)
 REV. 195+00 RT. ~ REV. 197+50 RT.
 REV. 205+00 RT. ~ REV. 205+50 RT.

DATUM
 VERTICAL _____
 HORIZONTAL _____

CONSTRUCT PARKING AREA
 REV. 205+90 LT. ~ REV. 207+05 LT.

TREATED TIMBER CURB
 REV. 207+30 LT. ~ REV. 210+08 LT.

CONSTRUCT DRIVE
 REV. STA. 198+50 RT. (16' GRAVEL)
 REV. TH 12 25+75 RT. (GRAVEL)

FOR ROW
 USE ONLY

12-02-93	REVISION 23	03-8053	1805	78E132	J. D. P.
06-16-93	REVISION 14 & 15	SURVEYED BY	NYE	DATE	12/84
		DRAWN BY	MCCLURE	DATE	5/90
		SQUAD LEADER	BRUCE BOYD		
		DESIGN FILE NO.	z:\fast170.70378\132zzz.dgn		
		IPARM FILE	T8e132dr.3.1	DATE	PLOTTED 16-DEC-1993

MORE TOWN
 RS EGC RW 0167(9)
 ROW SHEET 17 OF 20 SHEETS