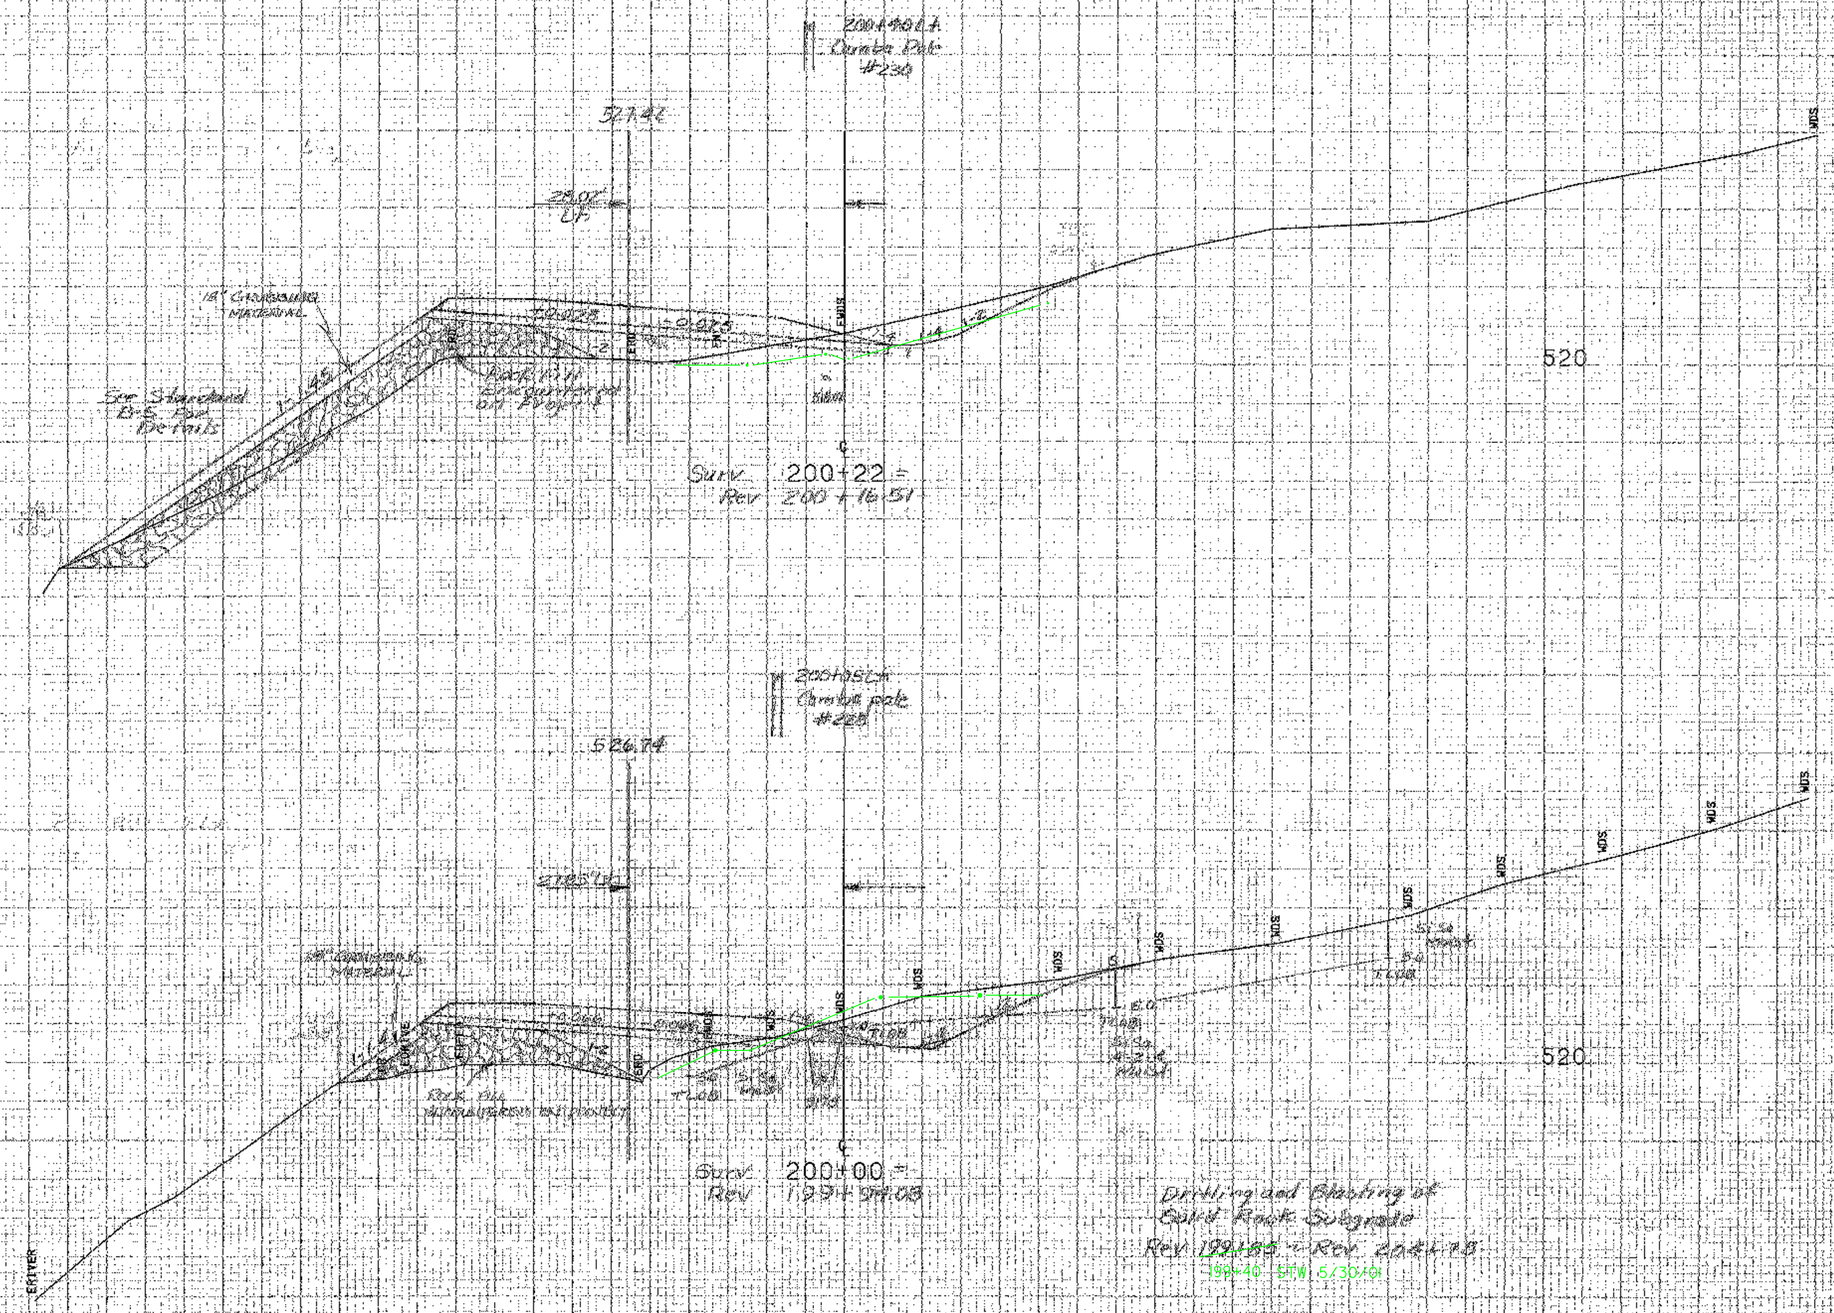

FROM STA. 200+00 TO STA. 200+22
PROJECT NAME MORETOWN-MIDDLESEX
NO. RS0157(9) PLOTTED 02/29/88
SURVEYED BY NYE 01/85 0103
SCALE 10 FEET SHEET 02 OF 2 SHEETS