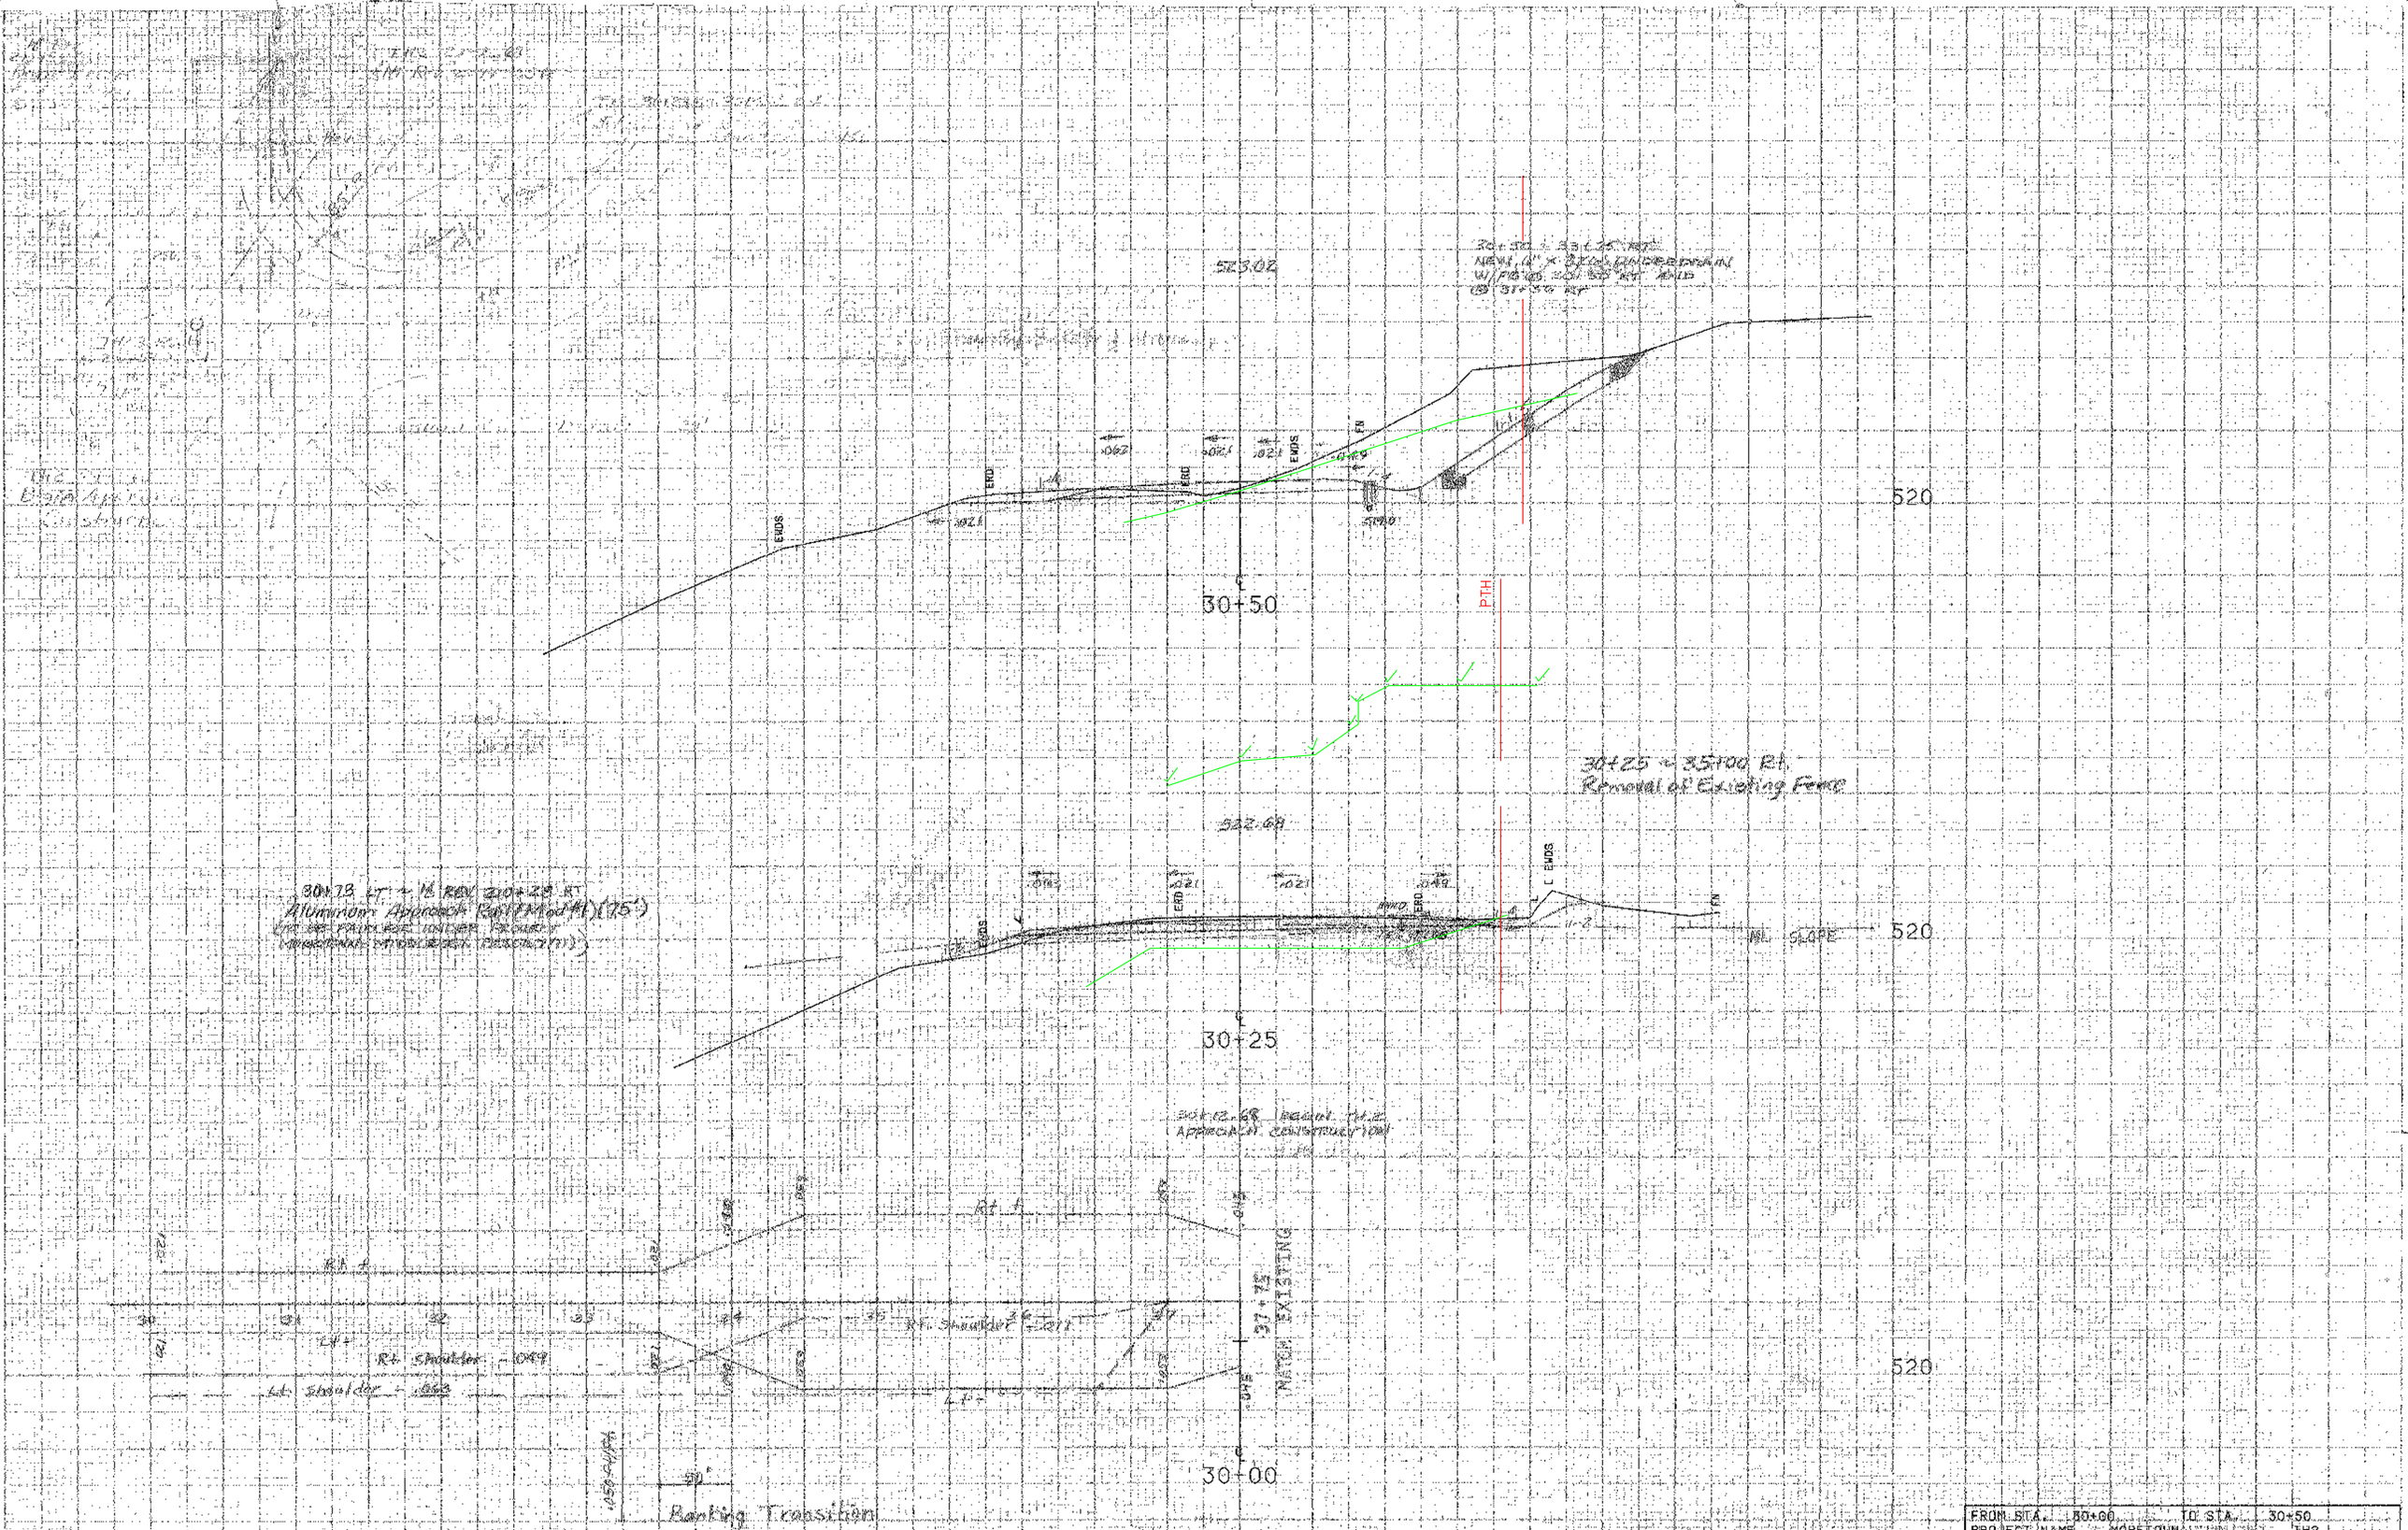
30+50
30+25
30+00
520
520
520
PTH
EXDS
EXD
EN
L EXDS
ML SLOPE
30+25 ~ 35+00 Rt.
Removal of Existing Fence
Rt. shoulder
Lt. shoulder
Rt. shoulder
NATIVE EXISTING
Ranking Transition
FROM STA. 30+00 TO STA. 30+50
PROJECT NAME MORETOWN TH2
NO. RS0167(9)
SURVEYED BY NYE
SHEET 1 OF 2 SHEETS
PLOTTED 06/09/86
JAN 1985
SCALE 10 FEET