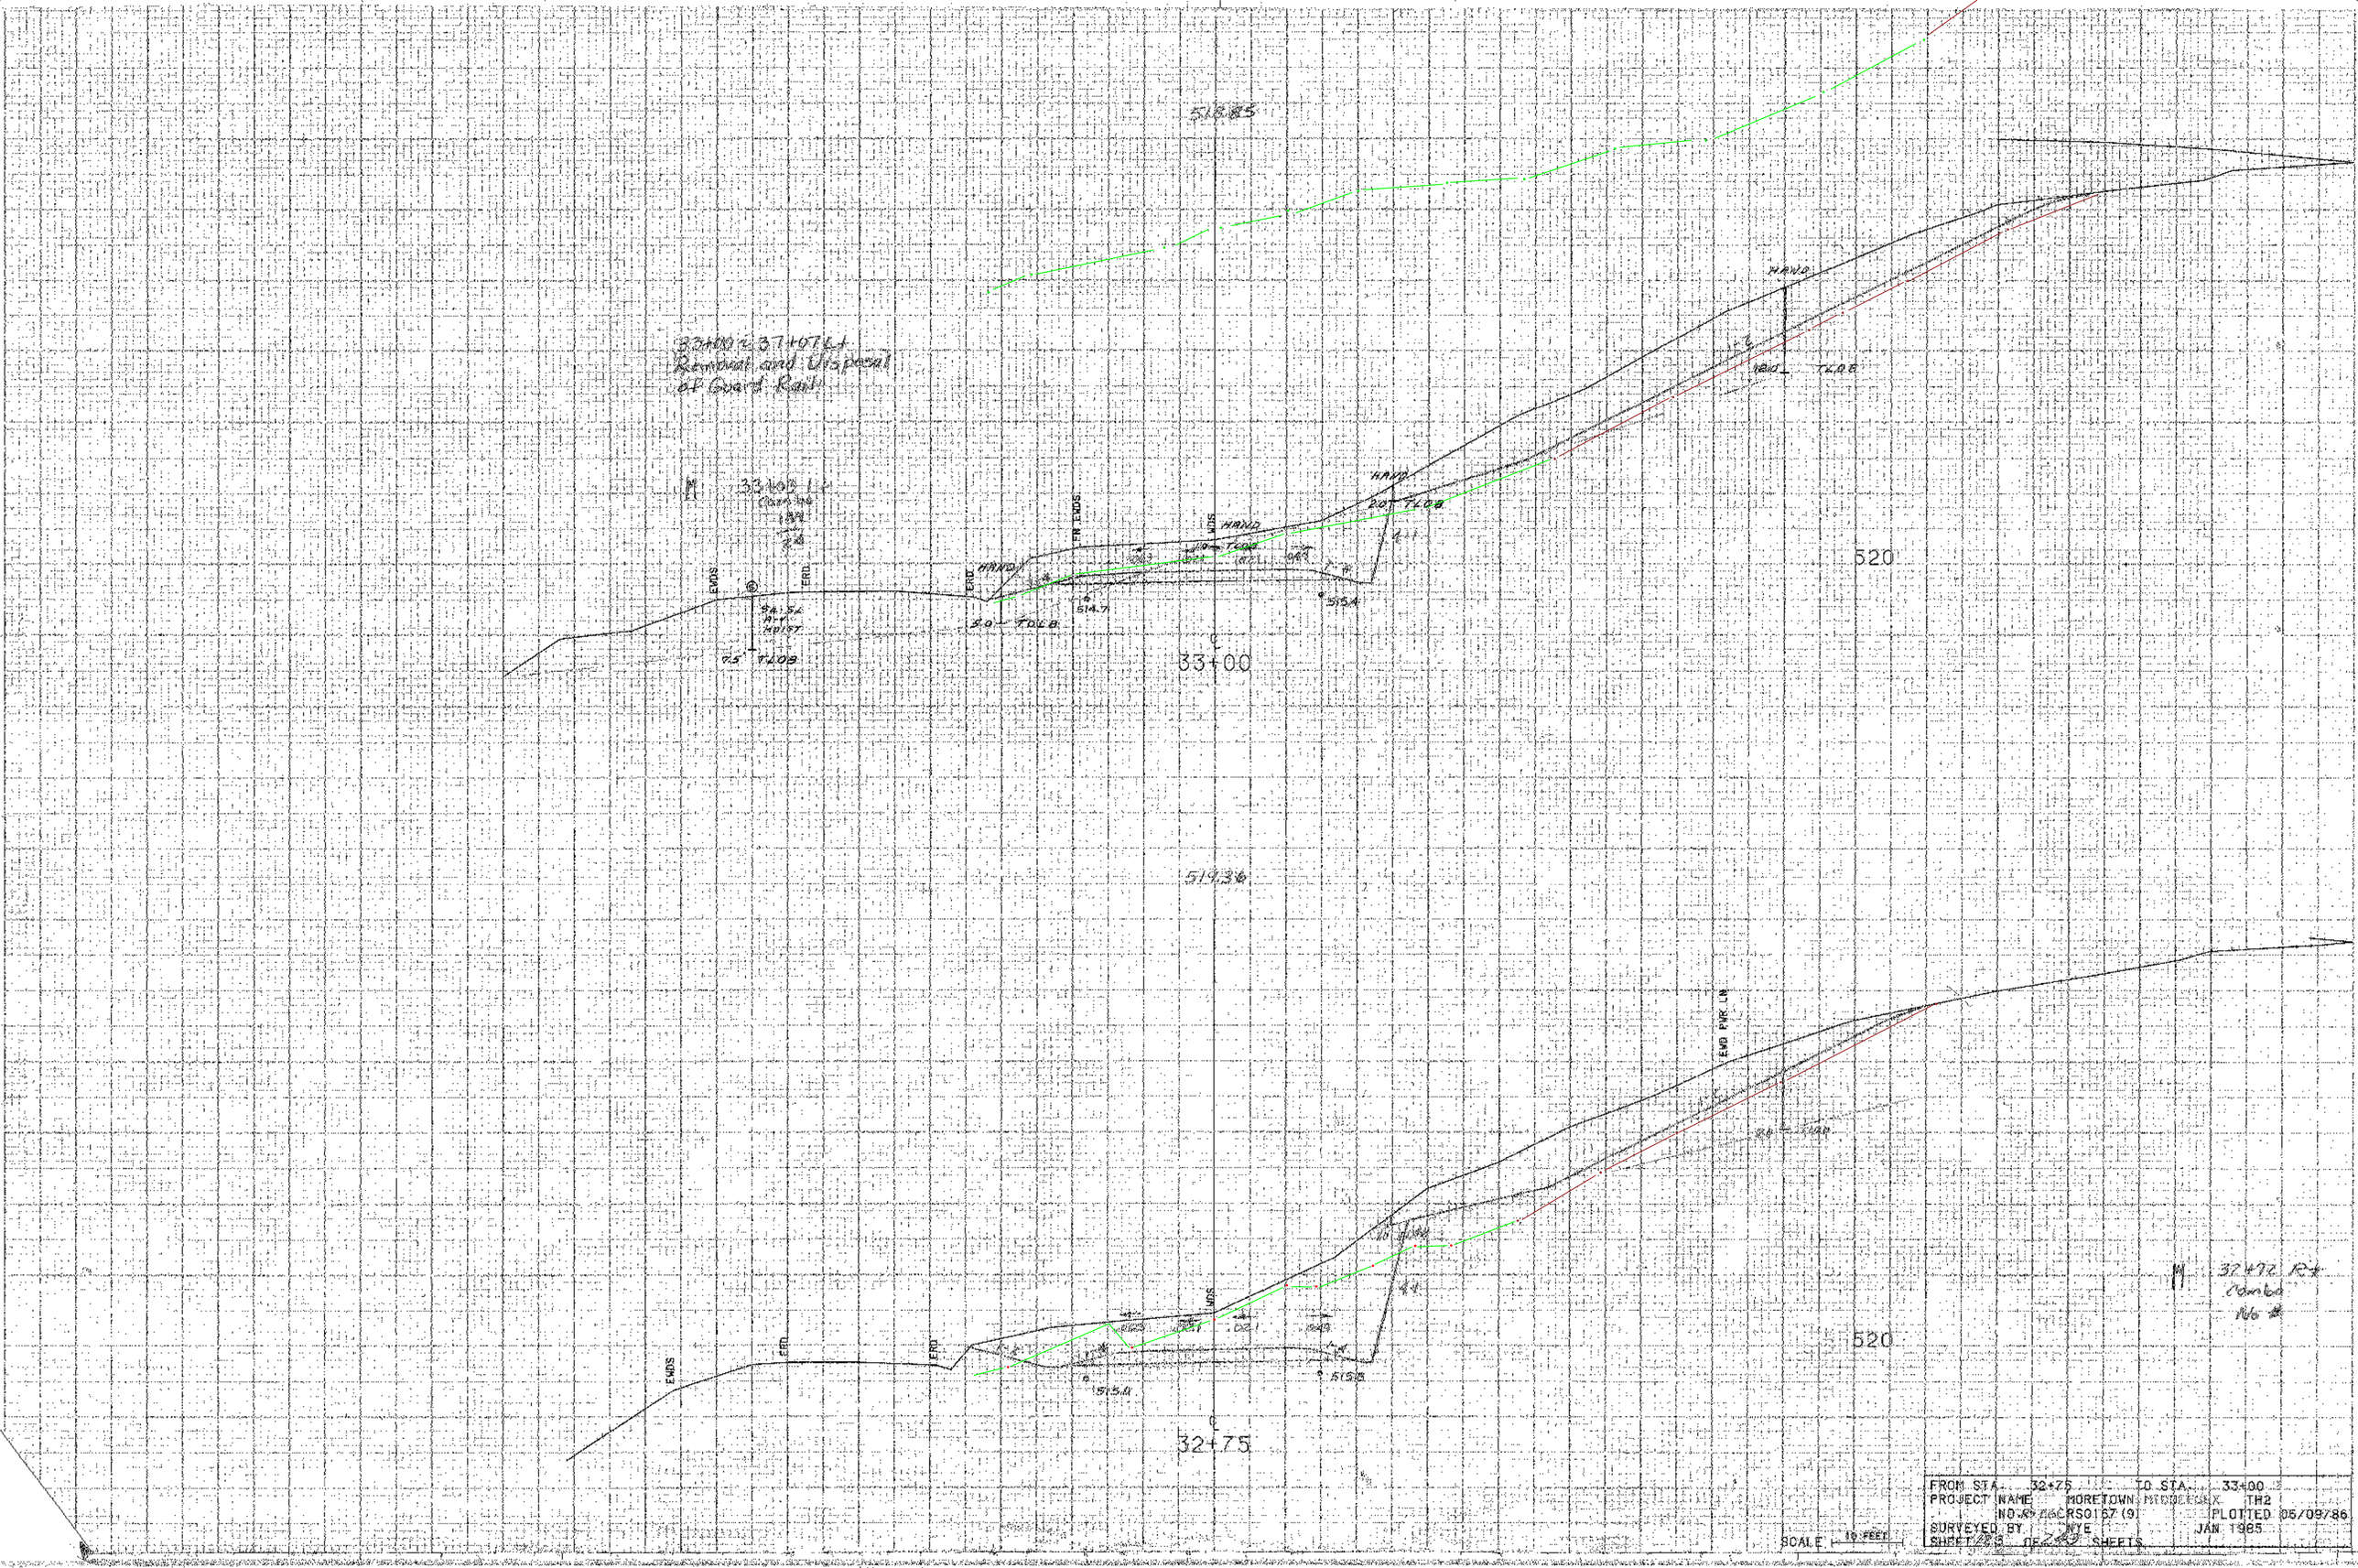

FROM STA. 32+75 TO STA. 33+00
PROJECT NAME MORETOWN MIDDLESEX TH2
NO. 29 ACRS0167(9) PLOTTED 05/09/86
SURVEYED BY NYE JAN 1985
SHEET 23 OF 29 SHEETS
SCALE 10 FEET