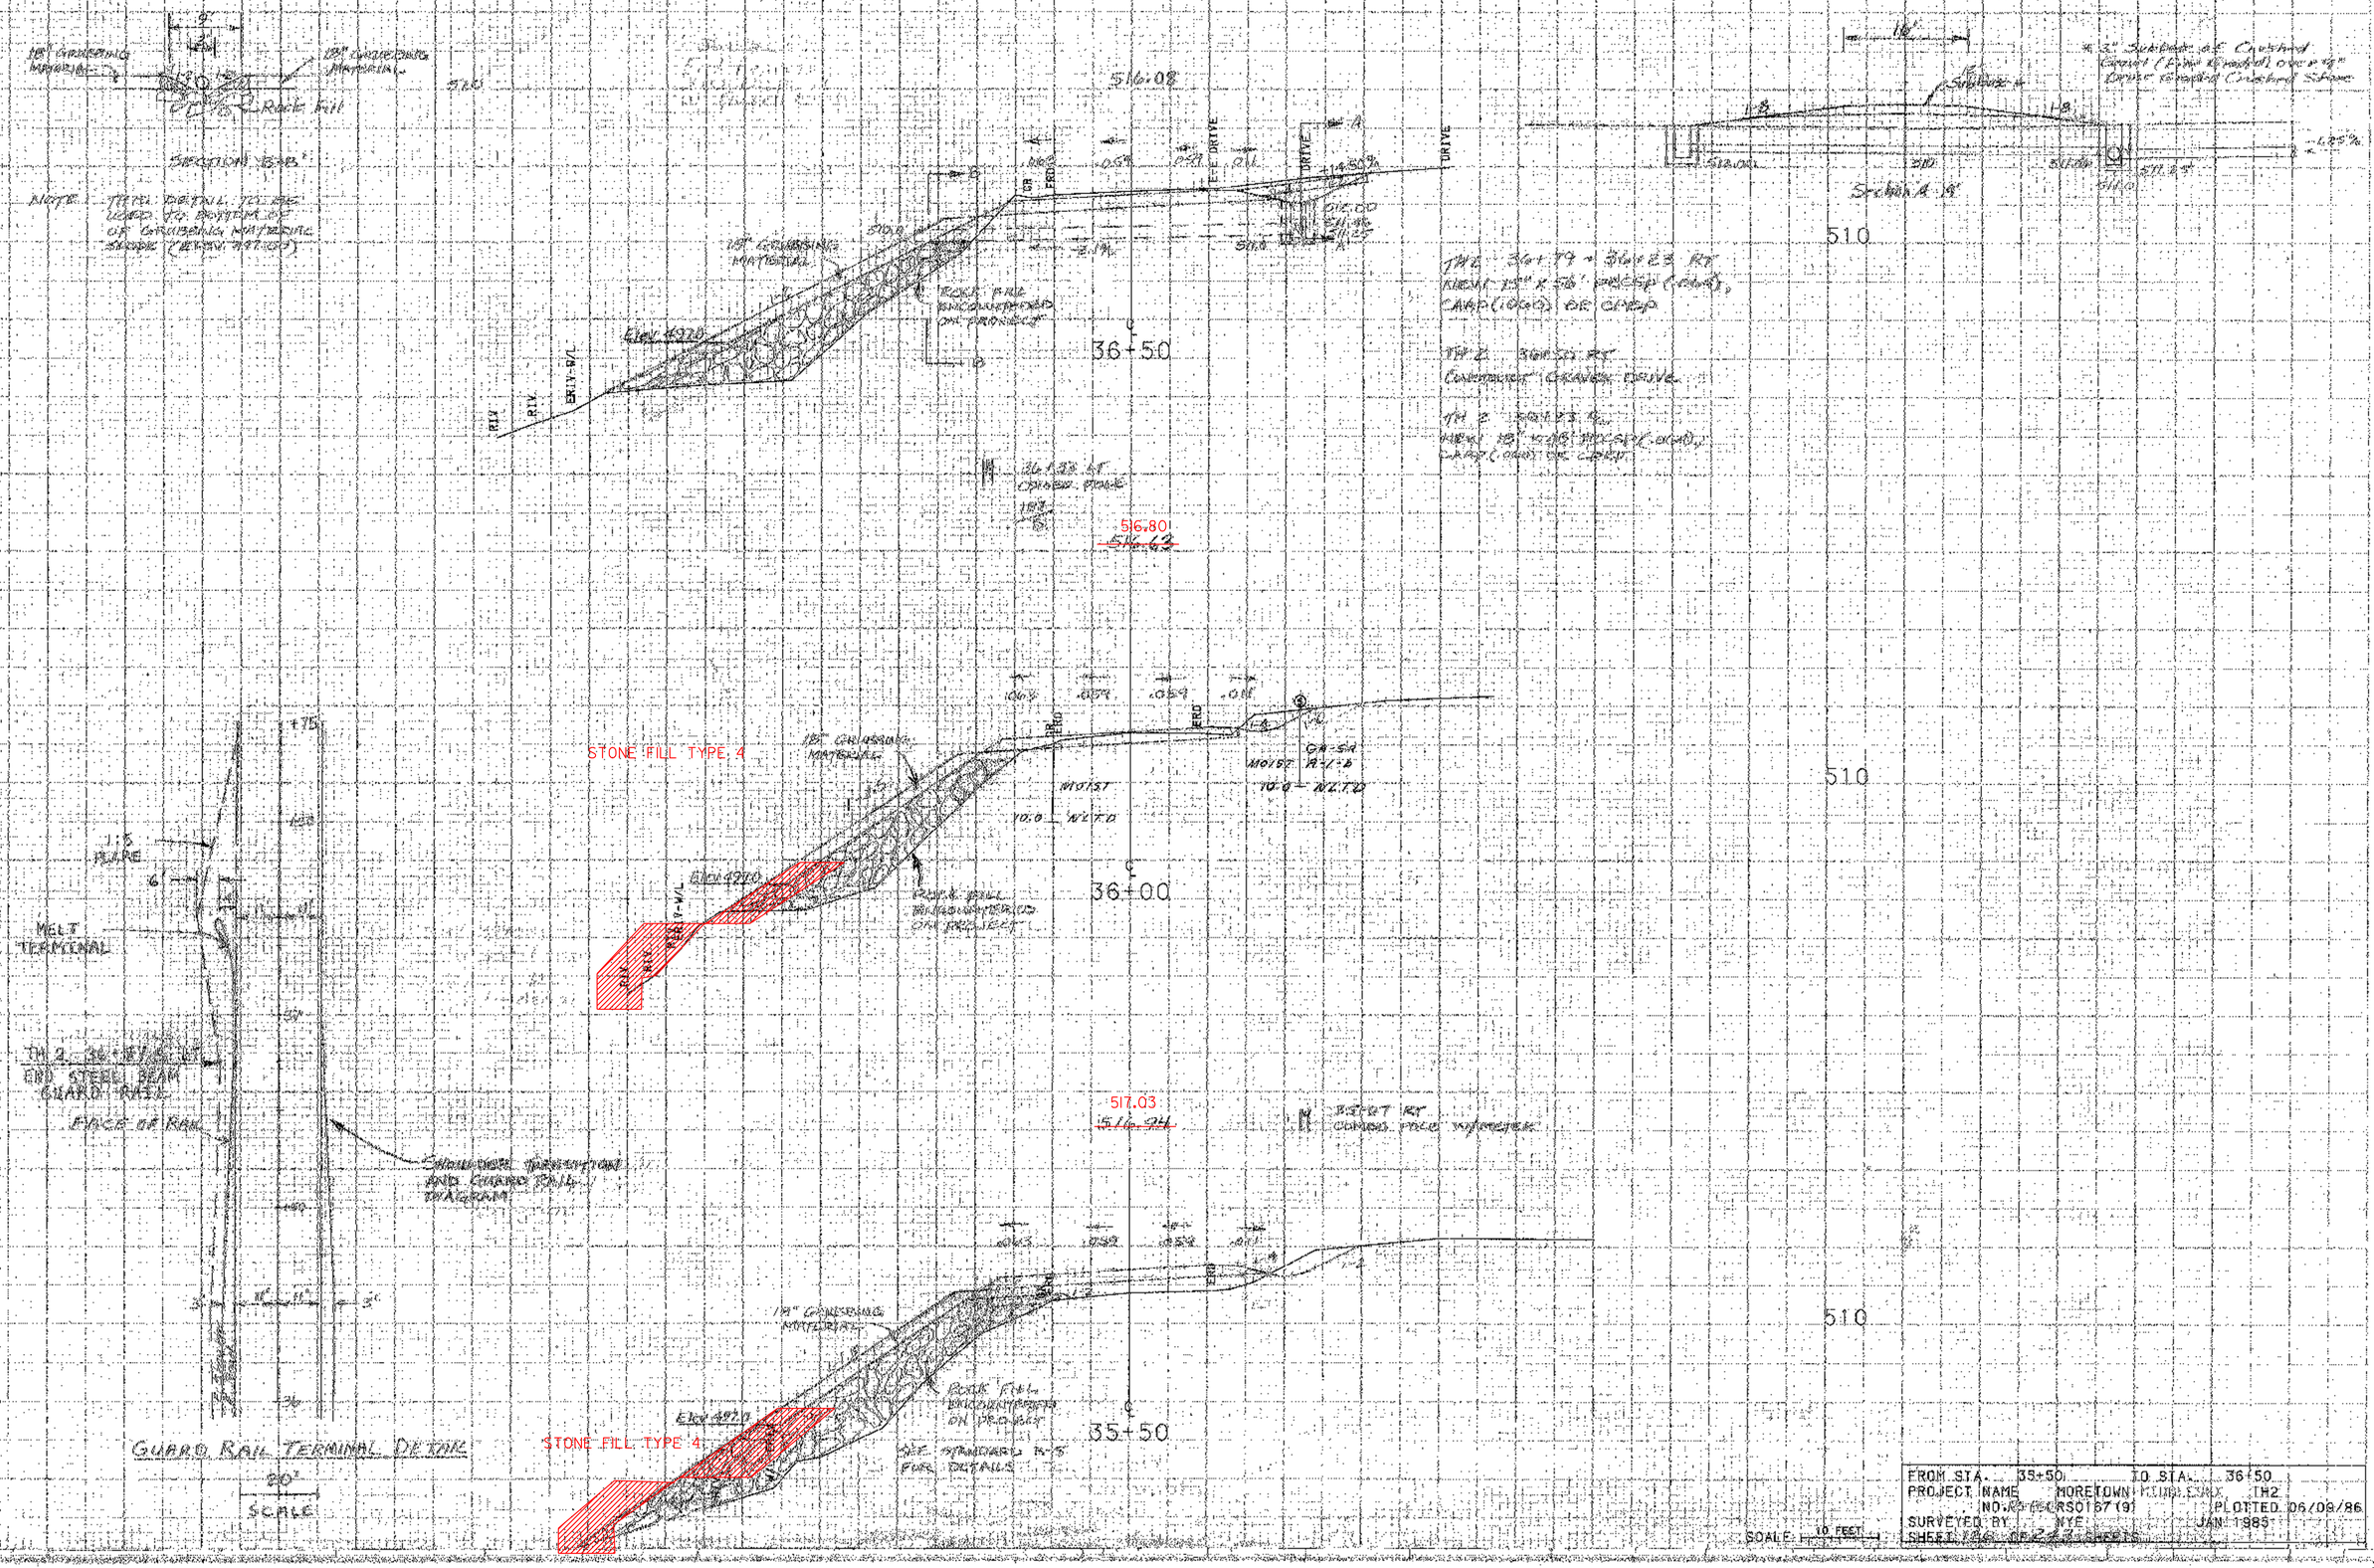

FROM STA. 35+50 TO STA. 36+50
PROJECT NAME MORETOWN MIDDLESEX TH2
NO. RS0187(9) PLOTTED 06/09/86
SURVEYED BY NYE JAN 1985
SHEET OF SHEETS