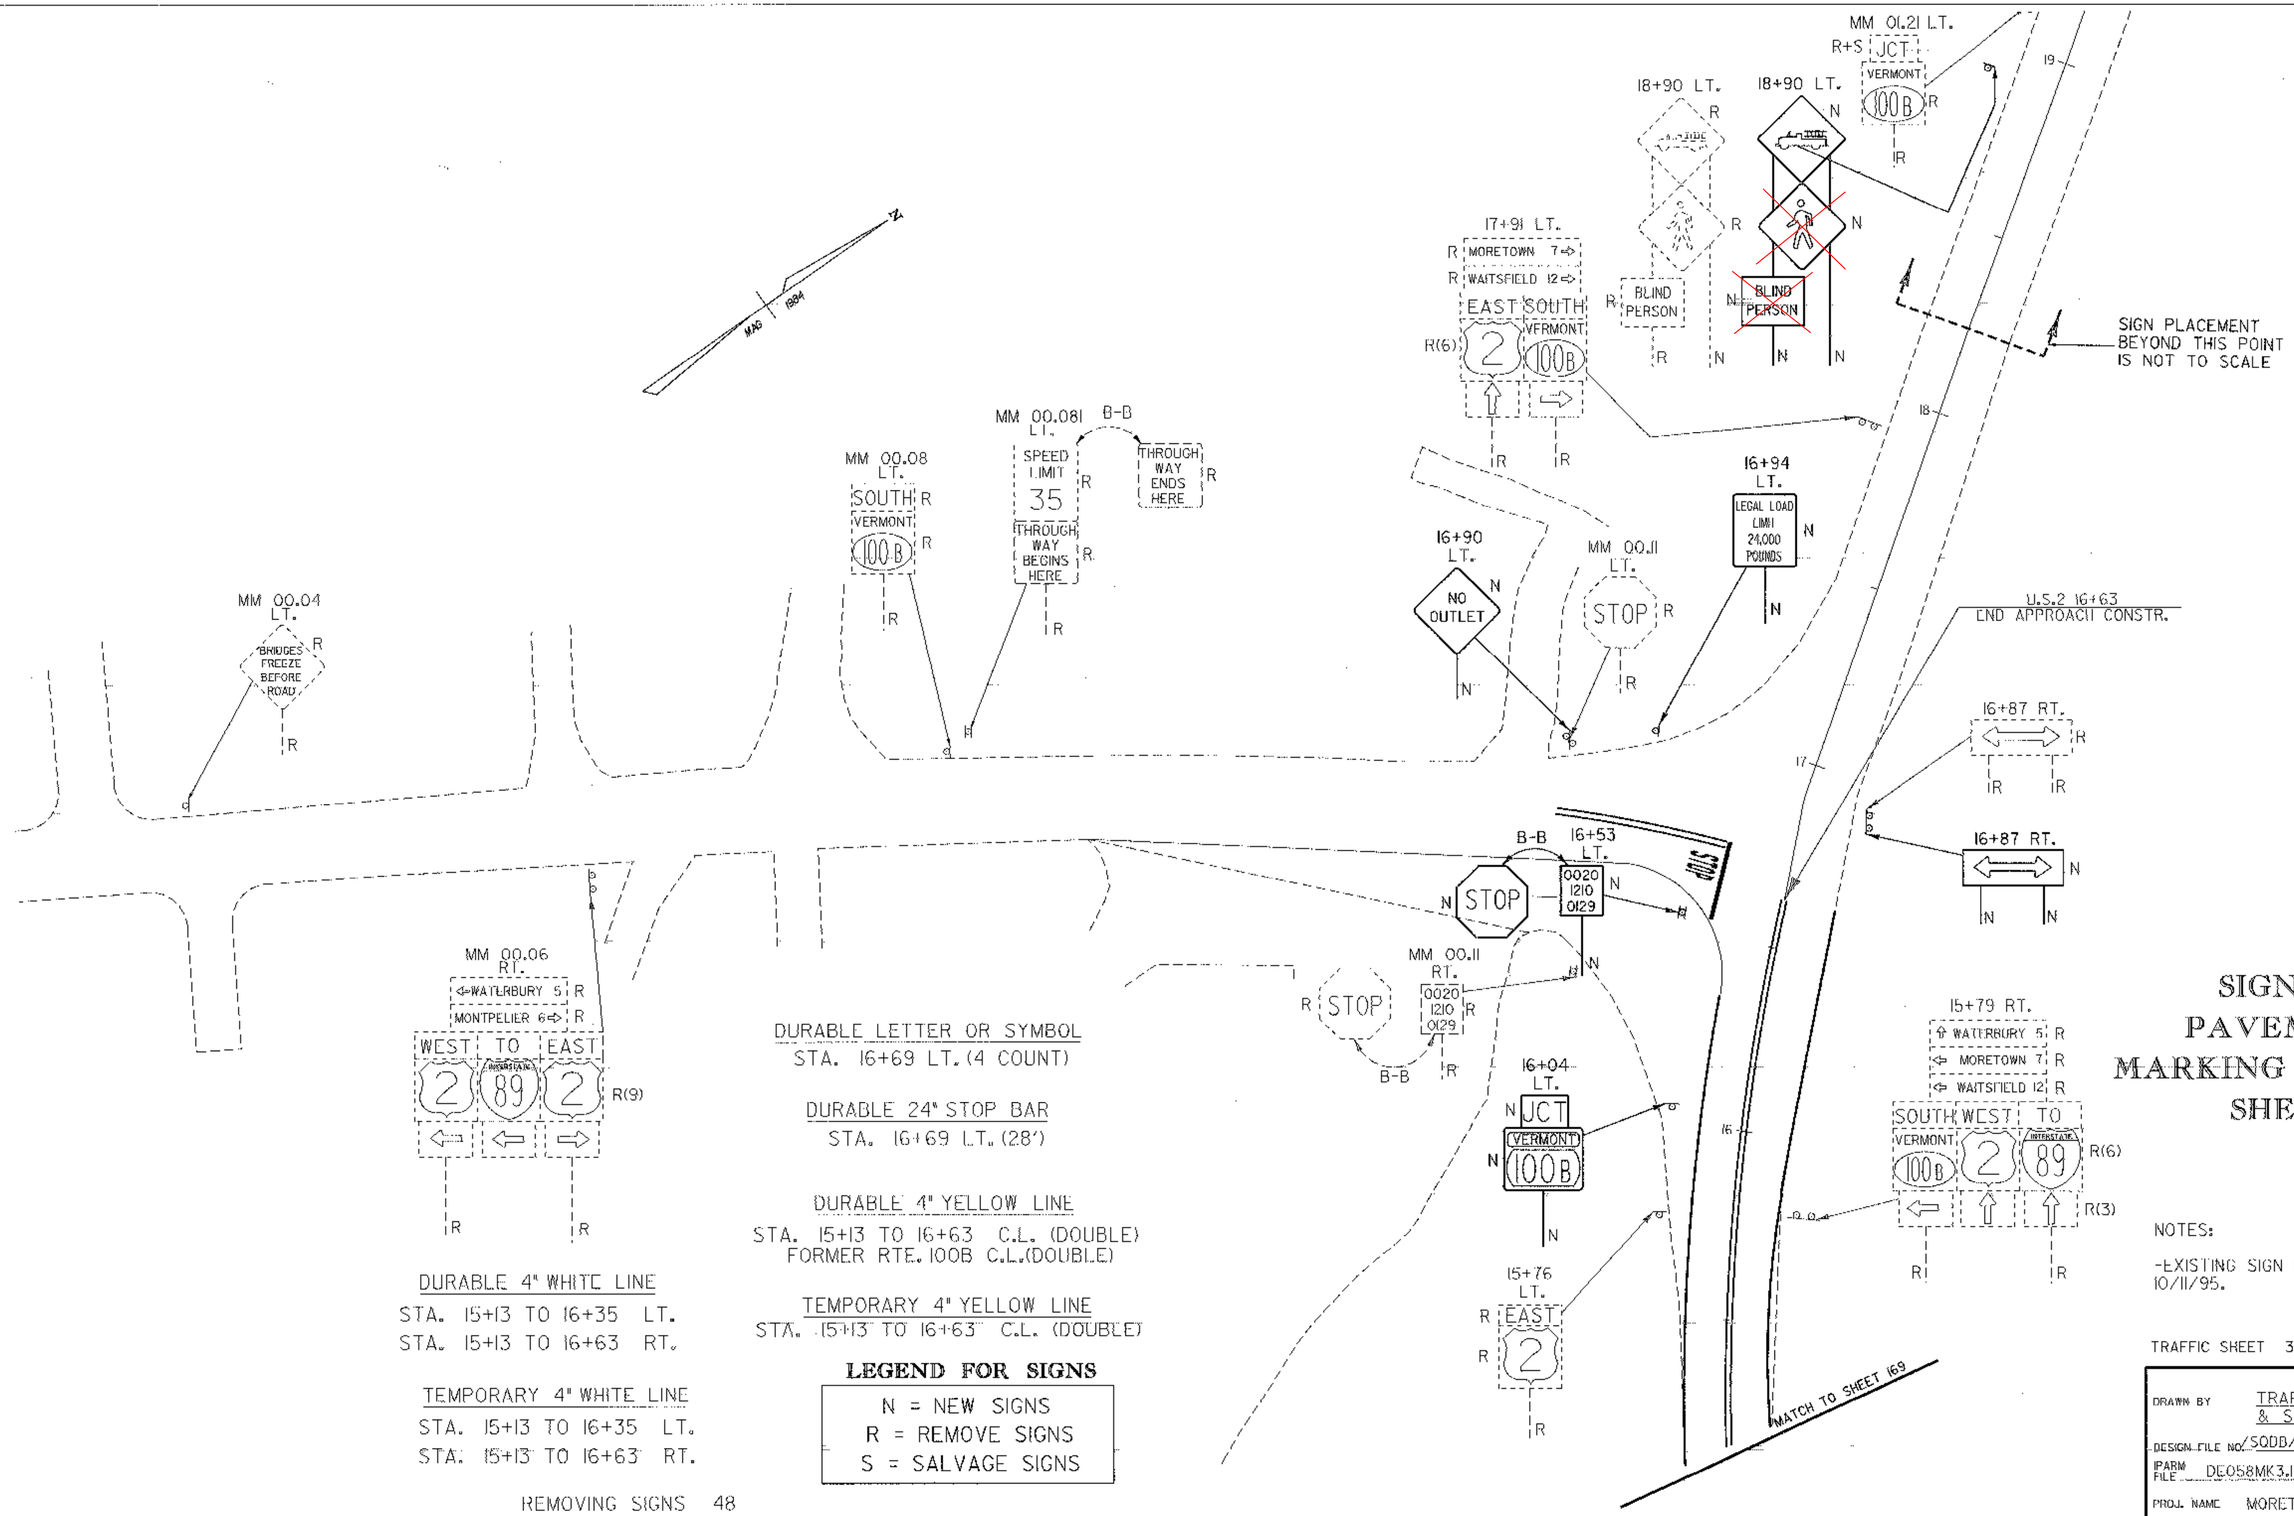

DURABLE LETTER OR SYMBOL
STA. 16+69 LT. (4 COUNT)

DURABLE 24" STOP BAR
STA. 16+69 LT. (28')

DURABLE 4" YELLOW LINE
STA. 15+13 TO 16+63 C.L. (DOUBLE)
FORMER RTE. 100B C.L. (DOUBLE)

TEMPORARY 4" YELLOW LINE
STA. 15+13 TO 16+63 C.L. (DOUBLE)

DURABLE 4" WHITE LINE
STA. 15+13 TO 16+35 LT.
STA. 15+13 TO 16+63 RT.

TEMPORARY 4" WHITE LINE
STA. 15+13 TO 16+35 LT.
STA. 15+13 TO 16+63 RT.

LEGEND FOR SIGNS

N = NEW SIGNS
R = REMOVE SIGNS
S = SALVAGE SIGNS

REMOVING SIGNS 48
SALVAGE SIGNS 0

NOTE : DASHED SIGNS AND POSTS ARE EXISTING

SIGN & PAVEMENT MARKING LAYOUT SHEET

NOTES:

-EXISTING SIGN INVENTORY AS OF 10/11/95.

TRAFFIC SHEET 3 OF 10 SHEETS

DRAWN BY TRAFFIC & SAFETY DATE 03/06/95
DESIGN FILE NO. SQDB/84E058/DE058tbr.DGN
IPARM FILE DE058MK3.I DATE PLOTTED 25-APR-2000
PROJ. NAME MORETOWN MIDDLESEX
PROJ. NO. BRS 0167(11)
SHEET 170 OF 243 SHEETS