END R.O.W. PROJECT
REV. STA. 211+22 80' RT.

MATCH A — TH 2 CURVE # 2 DATA — MATCH A

Δ = 21°49'-45" LT.
D = 10°
R = 572.958'
T = 110.486'
L = 218.292'
E = 10.55'

37+75
END TH 2 APPROACH CONSTRUCTION

TH 2 POT 38+33.80

TH 2 37+70
28' LT. PLACED IN LEDGES

TH 2 38+35
11' LT.

TH 2 37+88
214' LT.

DRILLING AND BL SOLID ROCK SU
TH 2 31+75 ~ 3
MATCH A — MATCH A

FOR DRAINAGE NOTES SEE ROW SHEET 18 OF 20 SHEETS

END RELINQUISHMENT NO. II
STA. T.H. 2 37+68 2' RT.

GRUBBING MATERIAL
2 34+00 LT. ~ 37+25 LT.

ODFIED ECCENTRIC
DER TERRMINAL(MELT)
33+25 ~ 33+62.5 LT.
36+87.5 ~ 37+25 LT.

EXCAVATION OF SURFACES AND PAVEMENTS
((AREA TO BE TOPSOILED, SEEDED AND MULCHED))
OLD TH 2 : SURV. 31+50 ~ 33+75 LT.

CONSTRUCT DRIVE
TH 2 34+88 RT. (GRAVEL)
TH 2 36+50 RT. (GRAVEL)

DRIVE GATE FOR WOVEN WIRE FENCE
TH 2 34+88 RT. (16' WIDE)
(2 - 8' GATES W/ OPENING IN MIDDLE)

REMOVAL AND DISPOSAL OF GUARD RAIL
TH 2 31+50 ~ 32+54 LT.
TH 2 33+00 ~ 37+07 LT.

REMOVAL OF EXISTING FENCE
TH 2 31+50 ~ 35+00 RT.

STEEL BEAM GUARD RAIL
TH 2 33+62.5 ~ 36+87.5 LT.

09-15-94	REVISION 32		
12-17-93	REVISION 26		
12-02-93	REVISION 23	01-19-96	REVISION 36

FOR R.O.W. USE ONLY

0 50 100
SCALE IN FEET

TH 2 PC 34+03.12 | TH 2 PI 35+13.603 = 35+10.923 | TH 2 POT 38+33.80

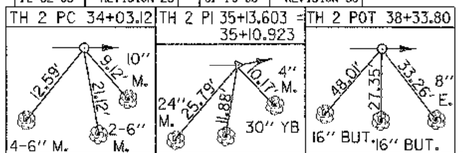

MATCH LINE TO SHEET 13 OF 20

NOT PLACED LEDGE

NOT PLACED LEDGE

GREEN MOUNTAIN POWER CORP.

BIGELOW, PAUL W. - TRUST
BIGELOW, PAUL W. &
SMITH, FRED G. - TRUSTEES

WINOOSKI RIVER

APPROACH (T)

EXISTING R.O.W.

APPROXIMATE MATERIAL RELOC. ROUTE

DRIVE (T)

BARN

HO. TRAILER

DRILLED WELL

GRANITE FENCE POST

METER BOX POLE

SCRIBNER, STANLEY R., SR. & CATHERINE J.

TH 2 34+44
32' LT.

TH 2 34+48
65' LT.

TH 2 34+35
7' LT.

TH 2 33+75
50' RT.

TH 2 35+82
25' RT.

TH 2 35+82
50' RT.

TH 2 35+82

PI 35+13.603 = 35+10.923

TH 2 37+65
27' RT.

TH 2 33+00
125' RT.

TH 2 32+50
82' RT.

TH 2 31+50
105' RT.

TH 2 30+00
75' RT.

BIGELOW, PAUL W. - TRUST
BIGELOW, PAUL W. &
SMITH, FRED G. - TRUSTEES

EQ. = +31.07'

DATUM
VERTICAL NGVD 1929
HORIZONTAL N/A

○ DENOTES REMOVAL OF TREE OR STUMP

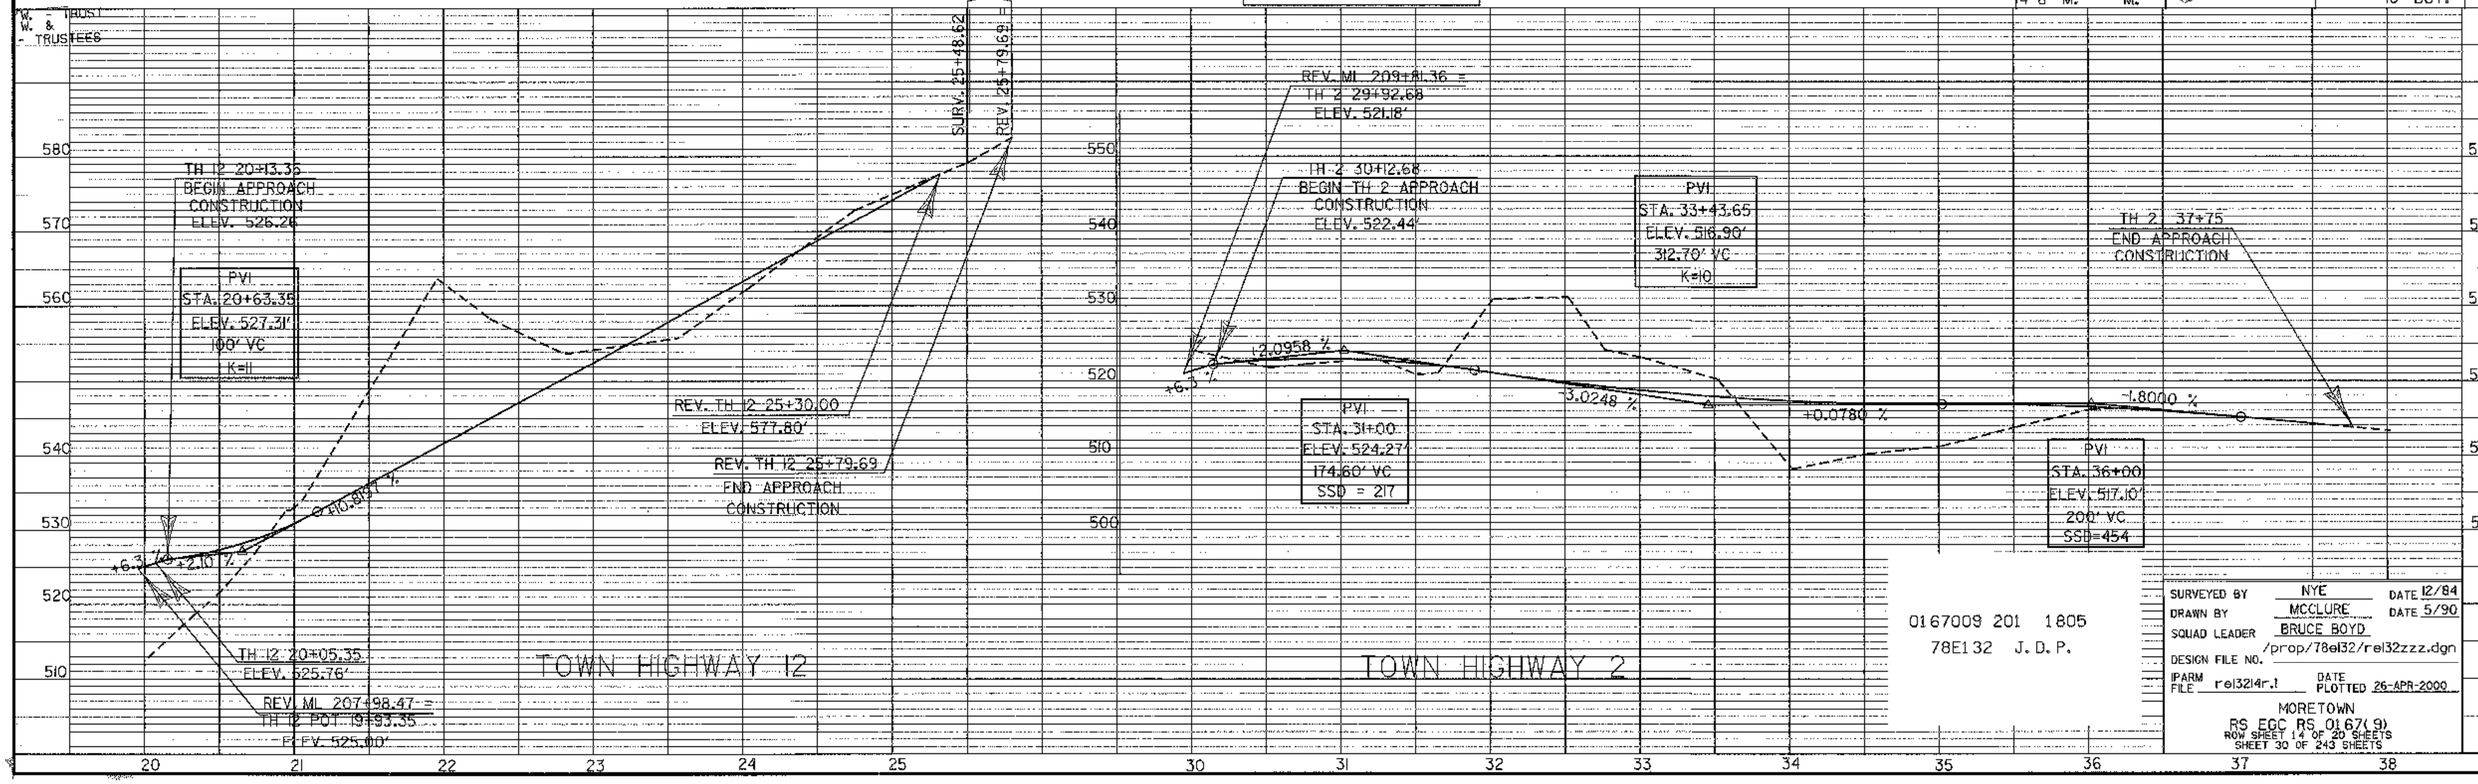

0167009 201 1805
78E132 J. D. P.

SURVEYED BY	NYE	DATE	12/84
DRAWN BY	MCCLURE	DATE	5/90
SQUAD LEADER	BRUCE BOYD		
DESIGN FILE NO.	/prop/78el32/rel32zzz.dgn		
IPARM FILE	rel3214r.!	DATE PLOTTED	26-APR-2000

MORETOWN
RS EGC RS 0167(9)
ROW SHEET 14 OF 20 SHEETS
SHEET 30 OF 243 SHEETS