


NOTE: ACTUAL LOCATION OF PROPOSED ACCESS FOR DAM TO BE DETERMINED BY THE ENGINEER UPON CONSTRUCTION

MATCH LINE TO

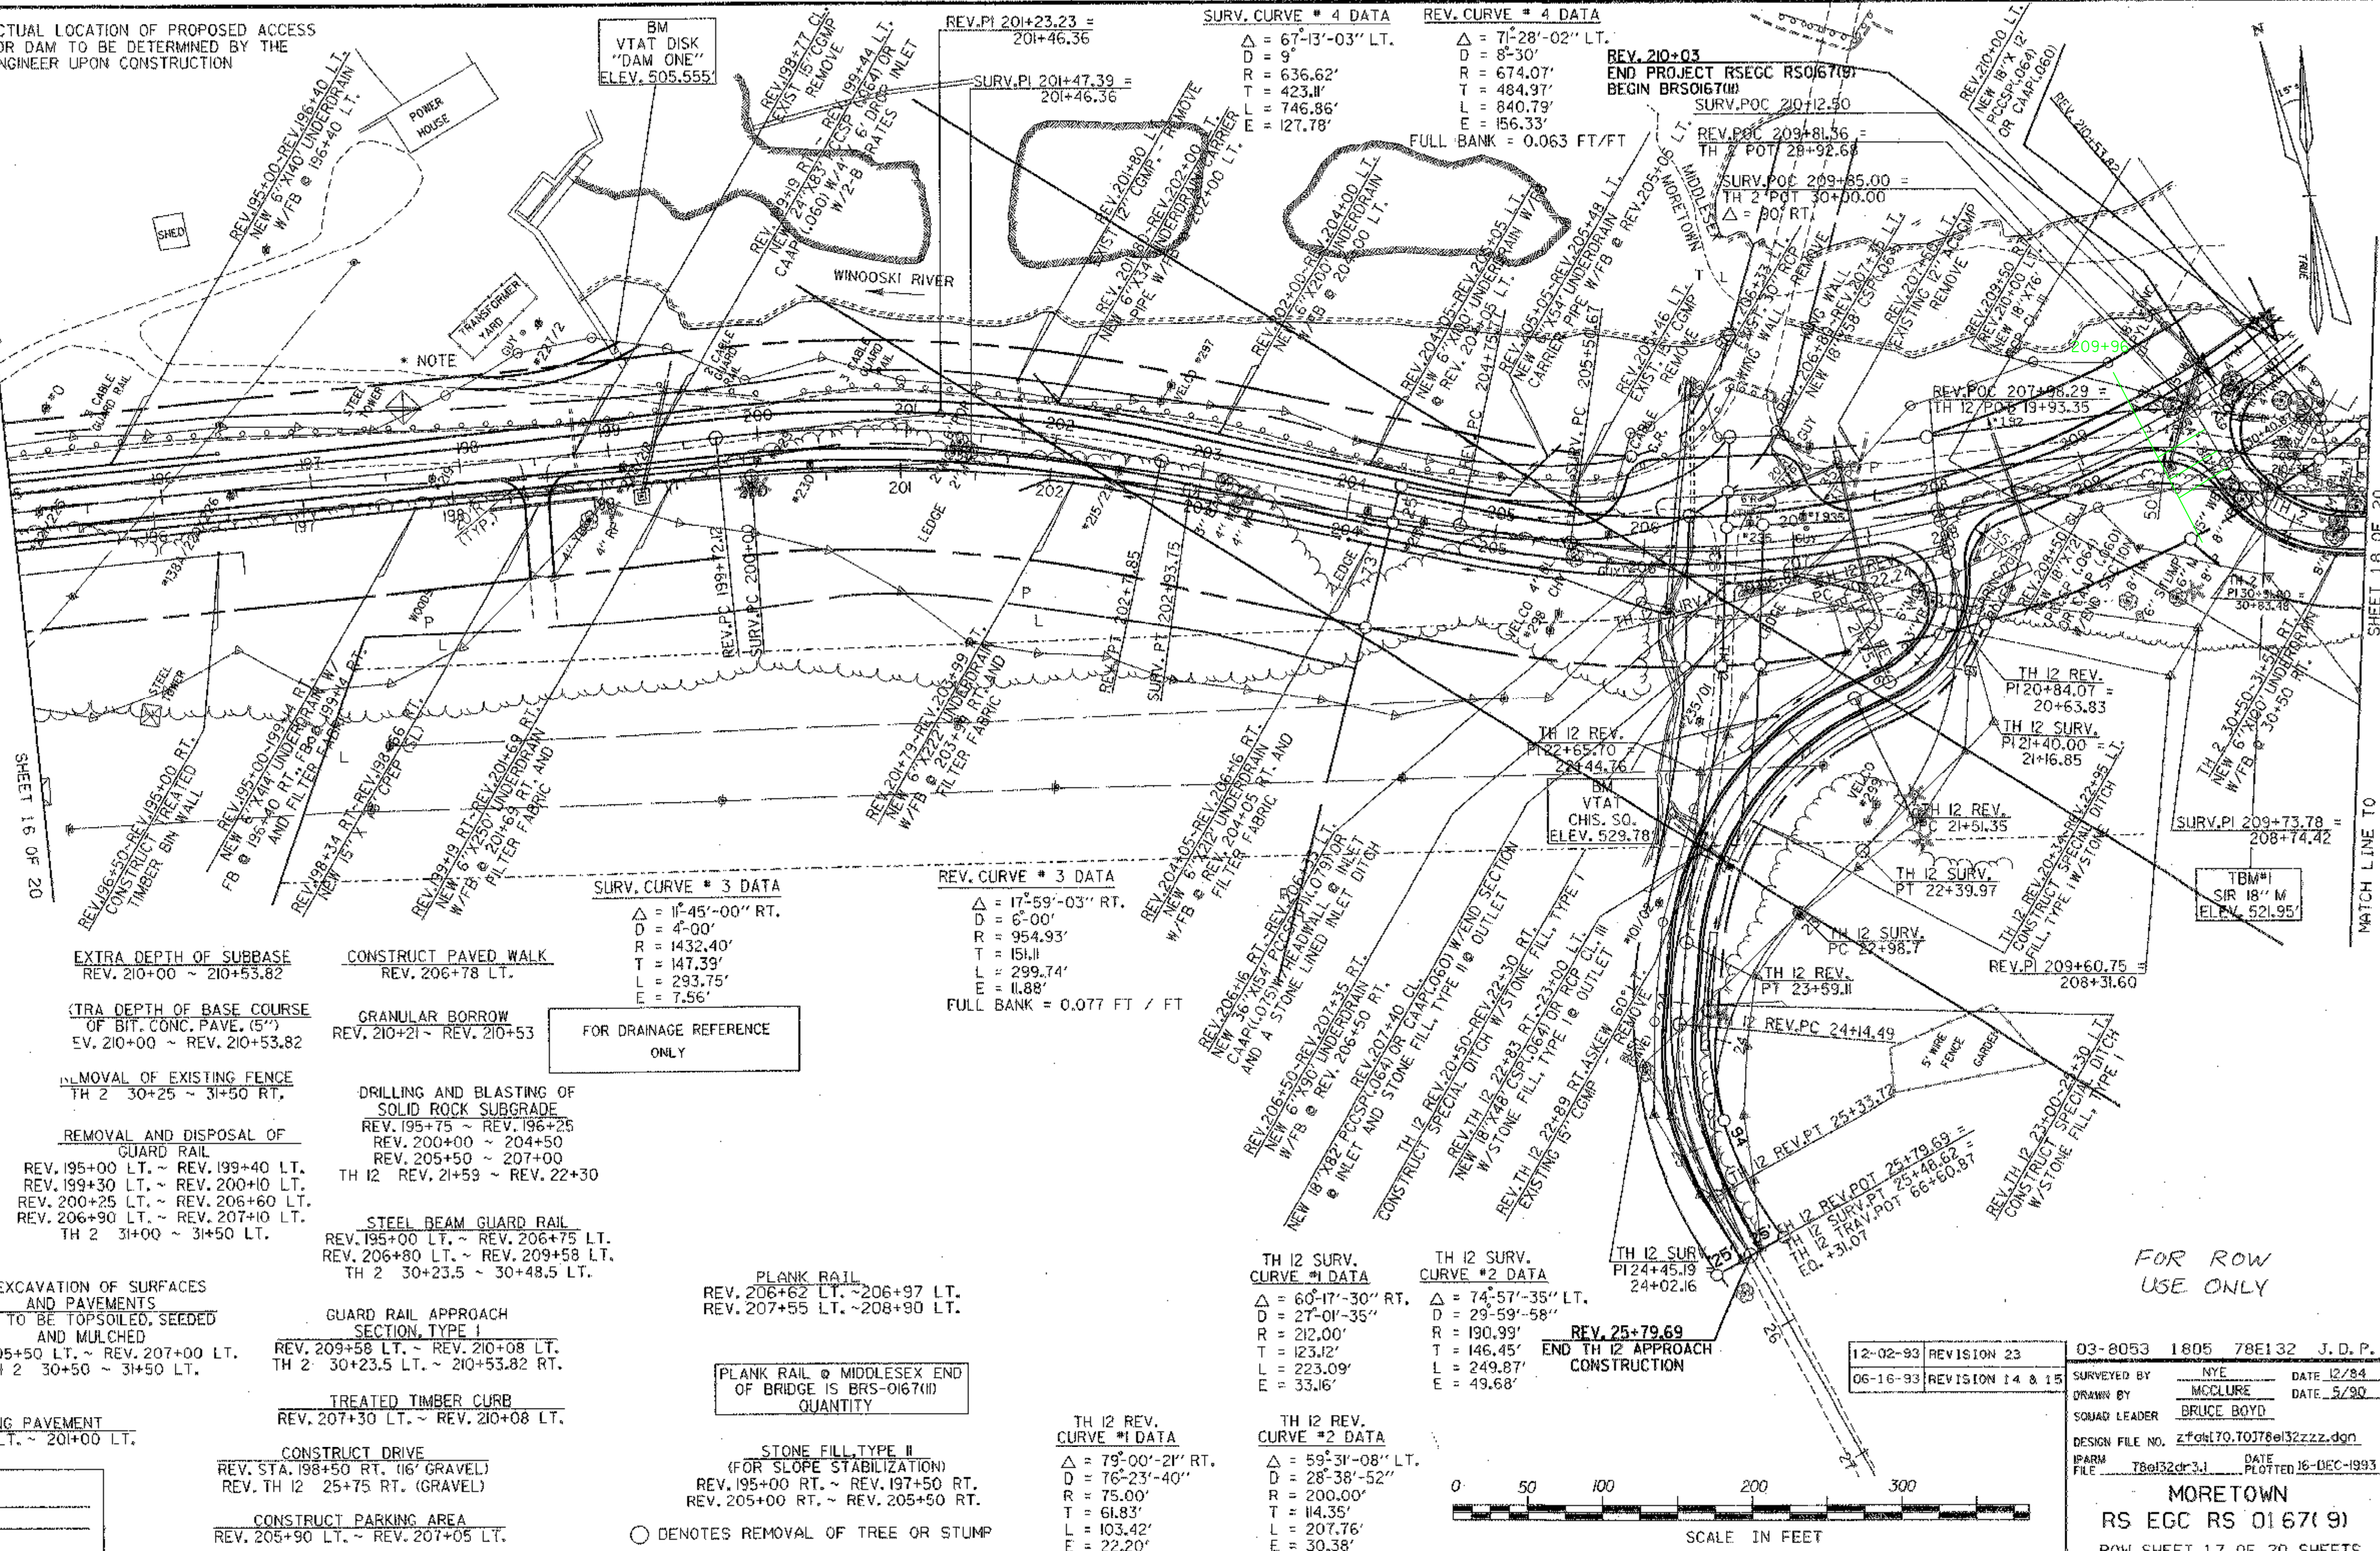

SHEET 18 OF 20

MATCH LINE TO

FOR ROW
USE ONLY

03-8053	1805	78E132	J.D.P.
SURVEYED BY	NYE	DATE	12/84
DRAWN BY	MCCLURE	DATE	5/90
SQUAD LEADER	BRUCE BOYD		
DESIGN FILE NO.	zfcsl70.70378el32zzz.dgn		
IPARM	FILE	DATE	16-DEC-1993
FILE	T8el32dr3.1		
MORETOWN			
RS EGC RS 0167(9)			
ROW SHEET 17 OF 20 SHEETS			

Sheet 33 of 243