EROSION CONTROL PLANS

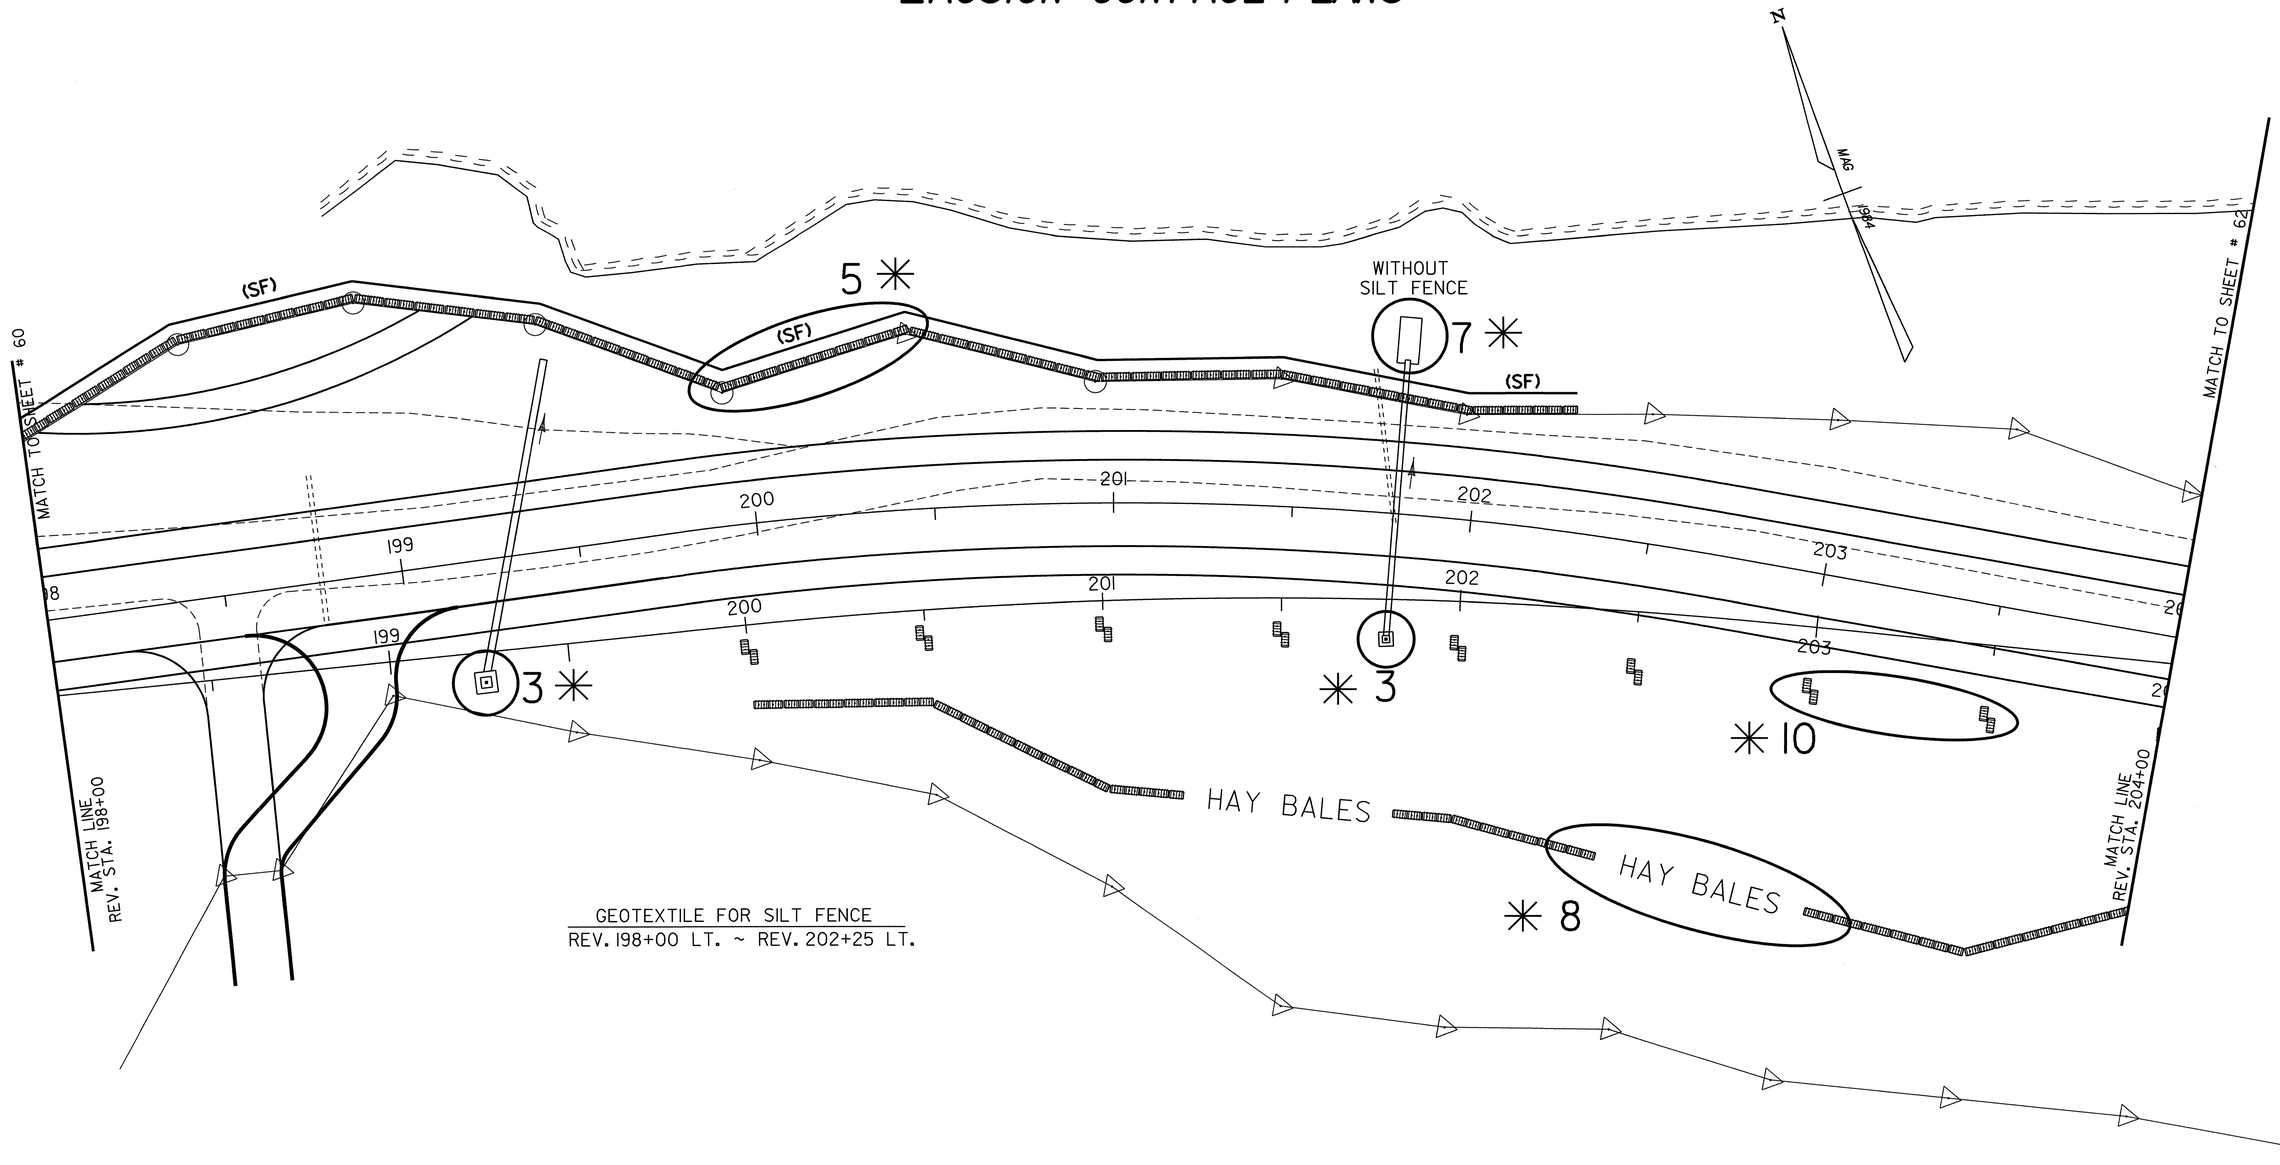

✳ SEE EROSION CONTROL PLANS TYPICAL SHEET

(SF) DENOTES GEOTEXTILE FOR SILT FENCE

THIS SHEET IS FOR EROSION CONTROL USE ONLY

0 20 40
SCALE IN FEET

SURVEYED BY	FANTONI — DATE 1/87
DRAWN BY	SQUAD B — DATE 8/87
SQUAD LEADER	DELLA SANTA
DESIGN FILE NO.	/SQDB/84E058/DE058ER0.DGN
IPARM FILE	DE132ER7 — DATE PLOTTED 05-NOV-1999
PROJ. NAME	MORETOWN
PROJ. NO.	RSEGC-RS 0167(9)
SHEET	61 OF 243 SHEETS

DATUM	
VERTICAL	NGVD 1929
HORIZONTAL	N/A