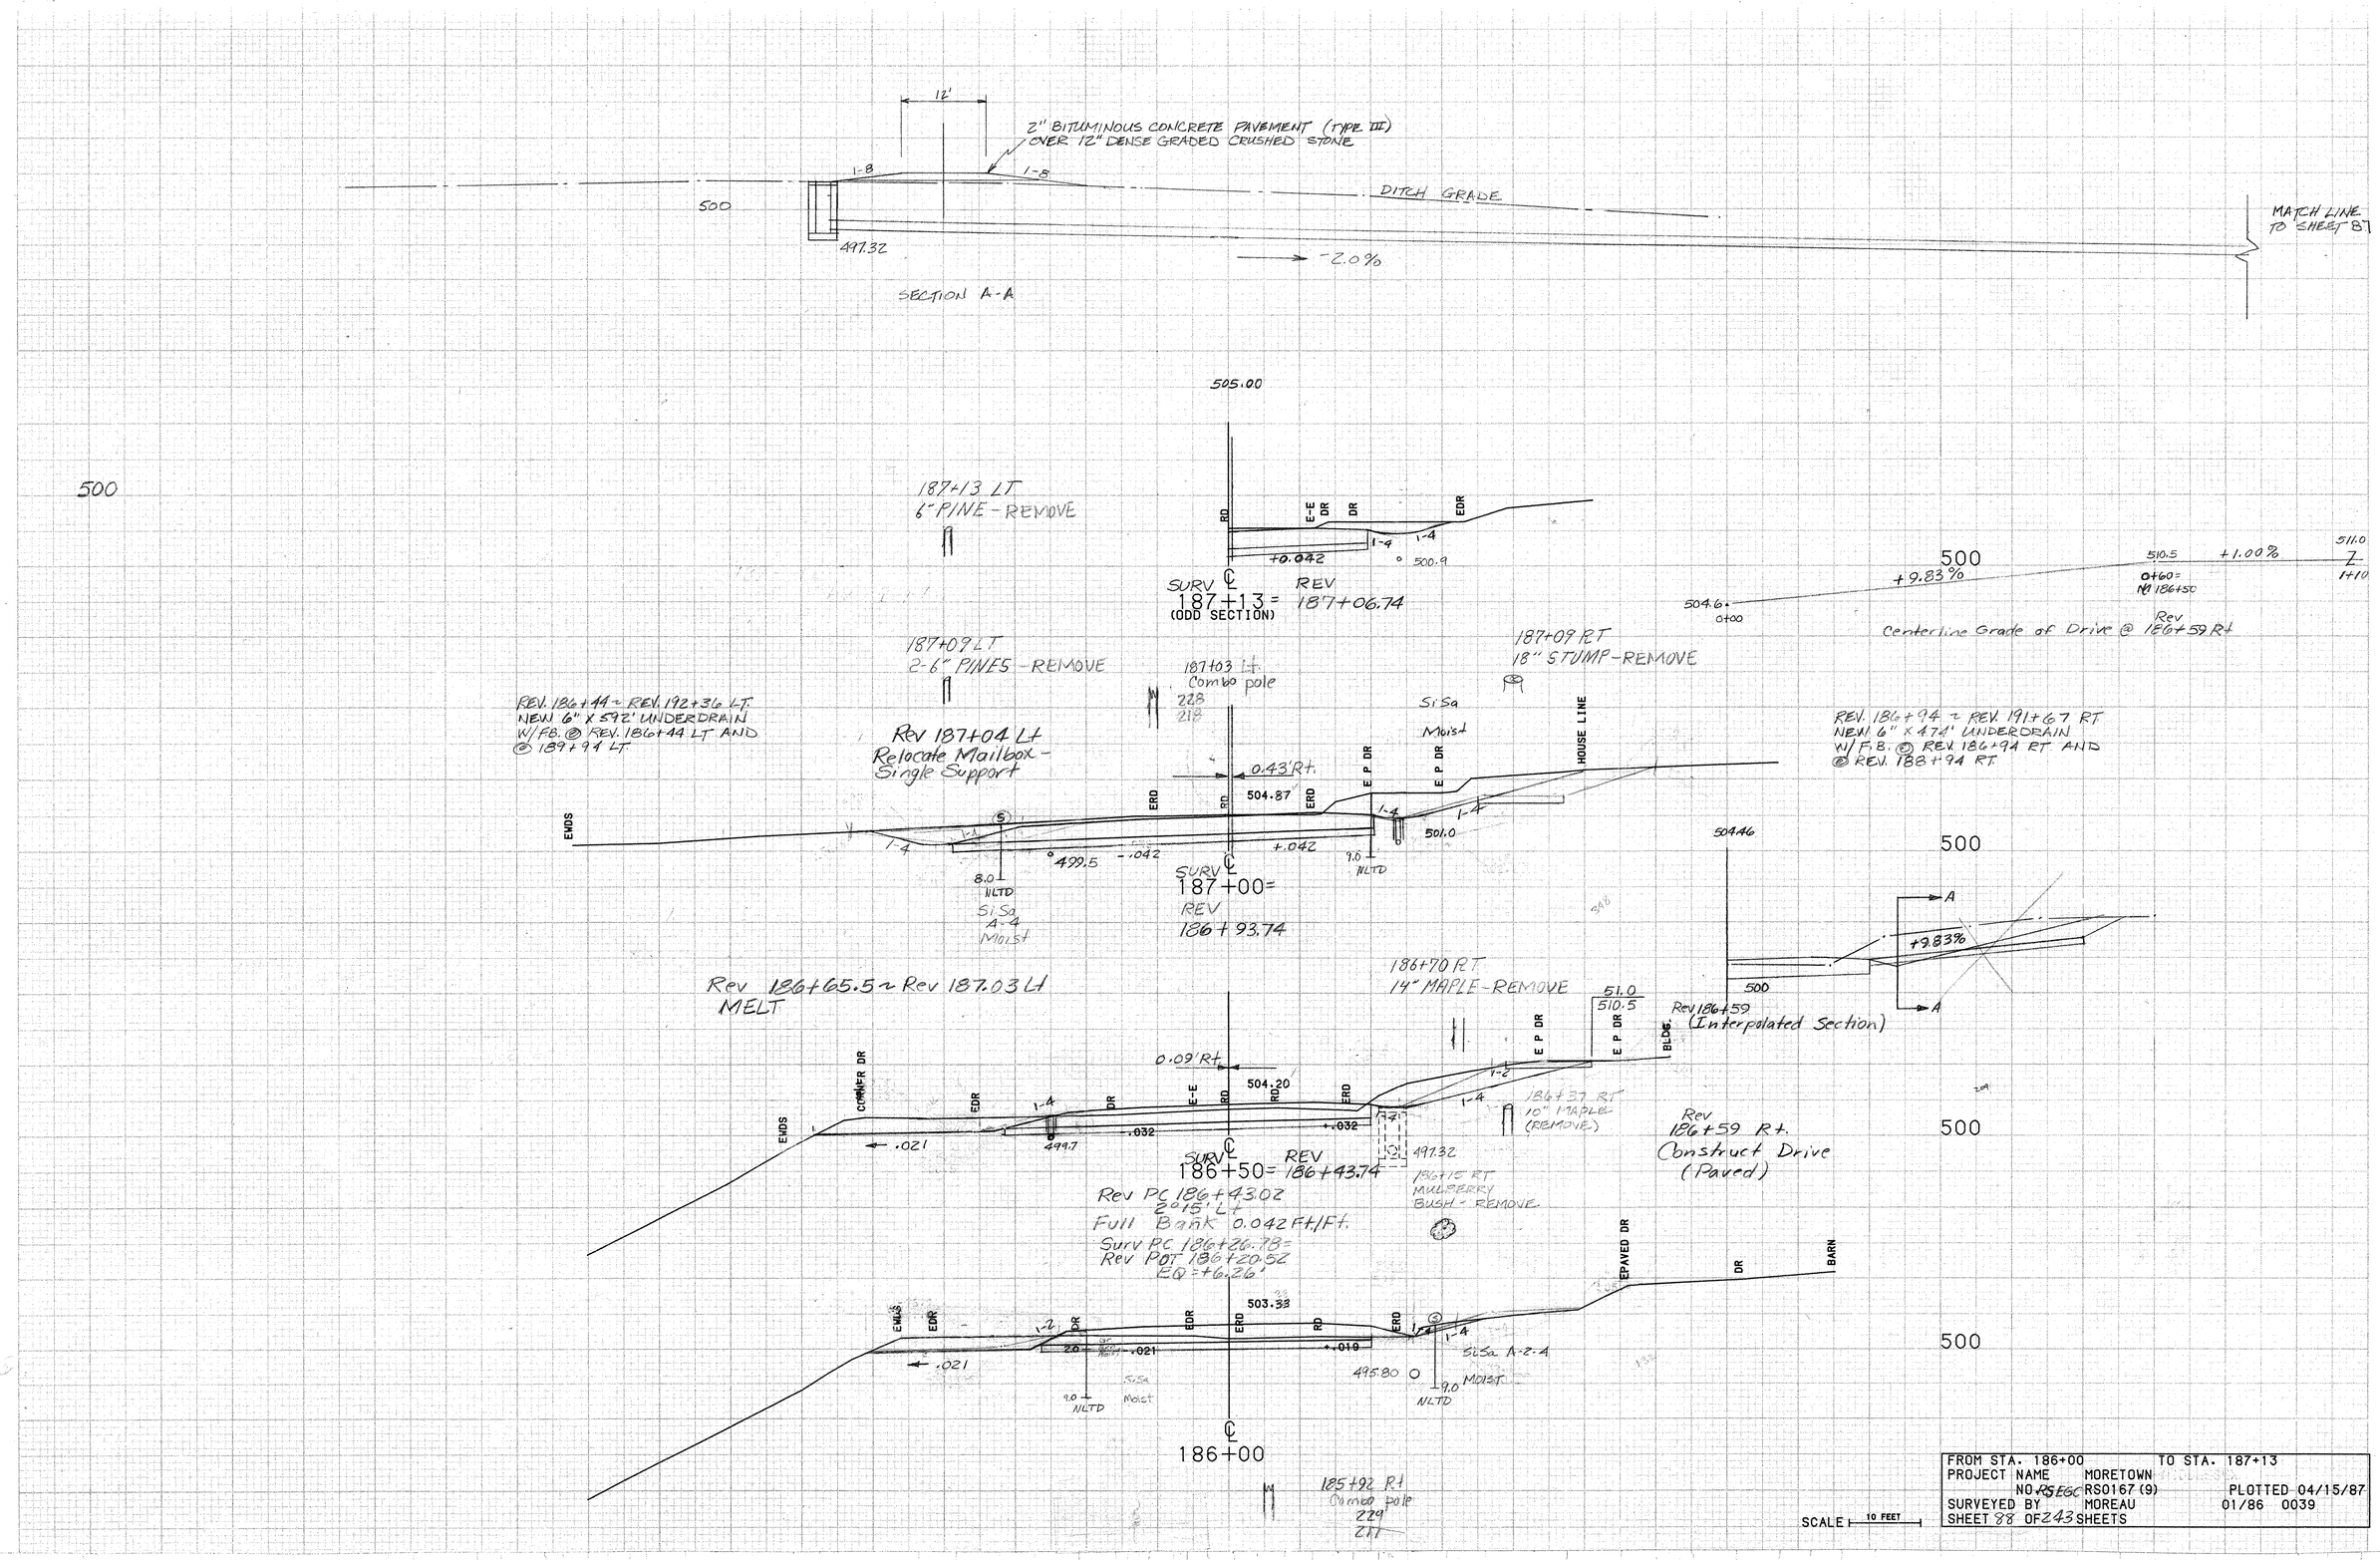

FROM STA. 186+00		TO STA. 187+13
PROJECT NAME	MORETOWN	
NO. ~~RS EGC~~	RS0167 (9)	PLOTTED 04/15/87
SURVEYED BY	MOREAU	01/86 0039
SHEET 88 OF 243 SHEETS		