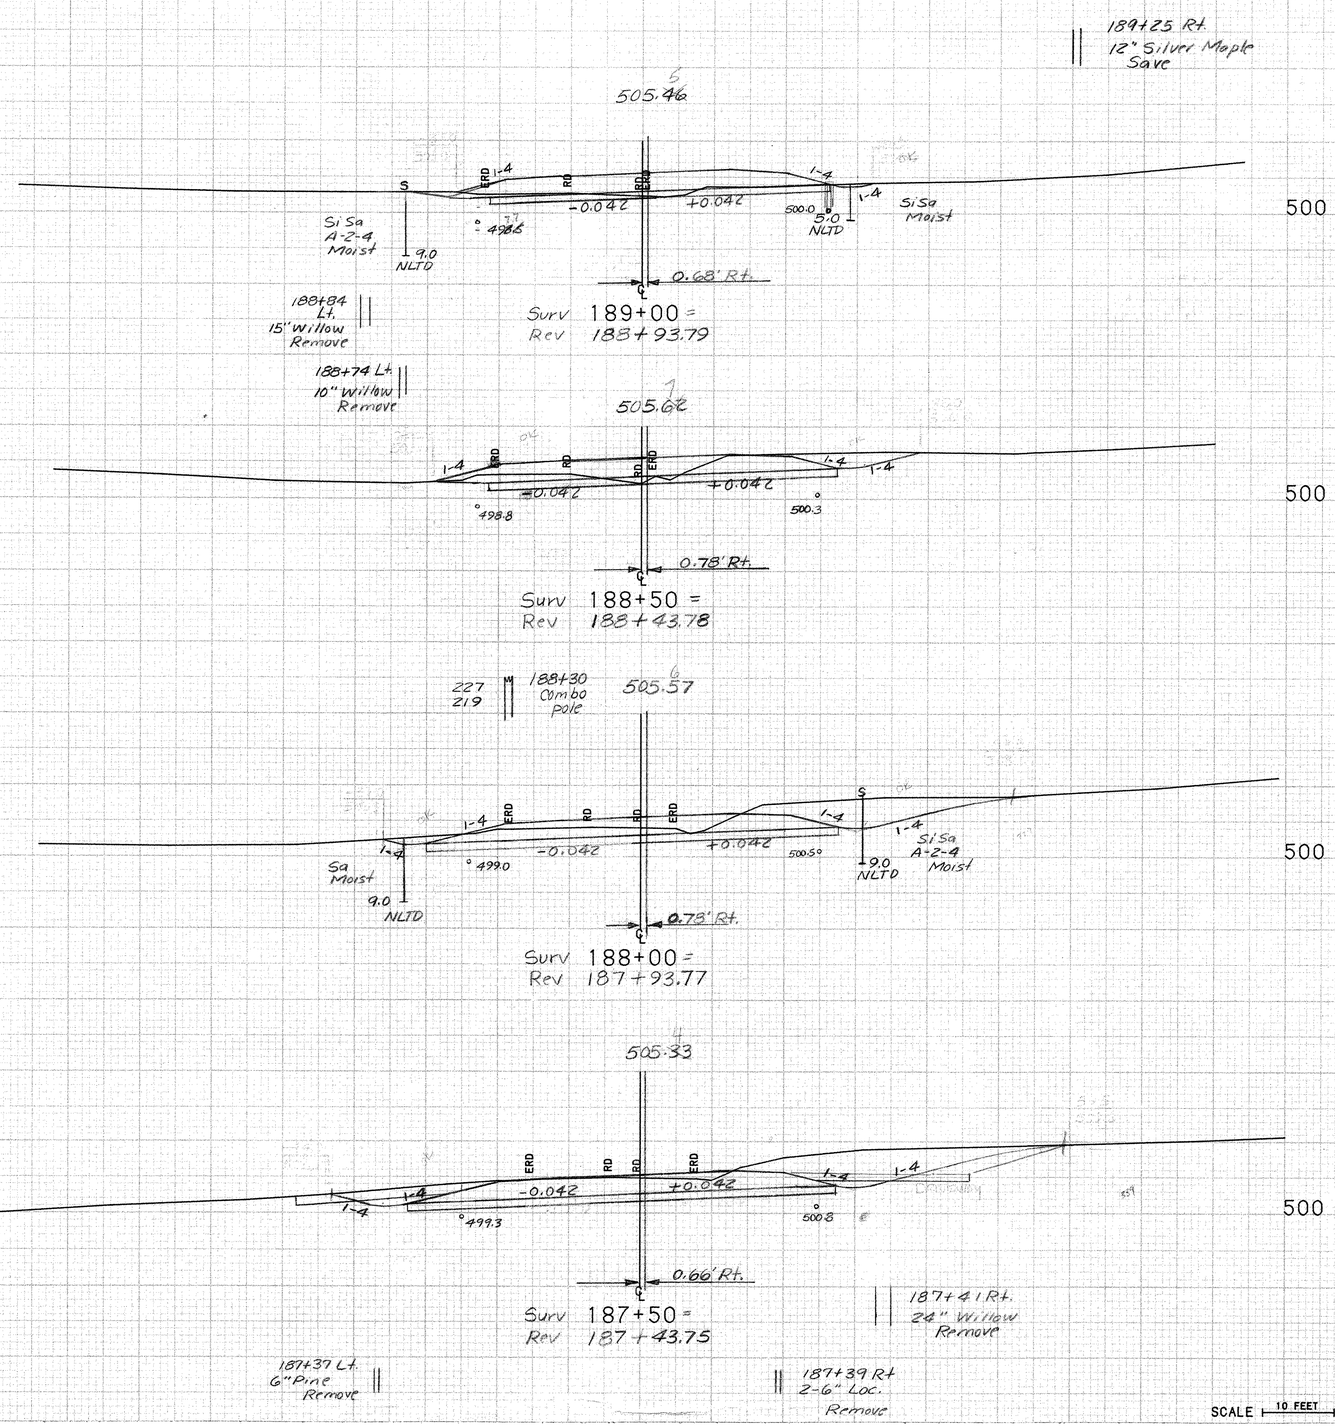

FROM STA. 187+50		TO STA. 189+00	
PROJECT NAME	MORETOWN-MIDDLESEX		
NO.	RS EGC RS0167 (9)		PLOTTED 02/29/88
SURVEYED BY	MOREAU	01/86	0105
SHEET 89 OF 243 SHEETS			