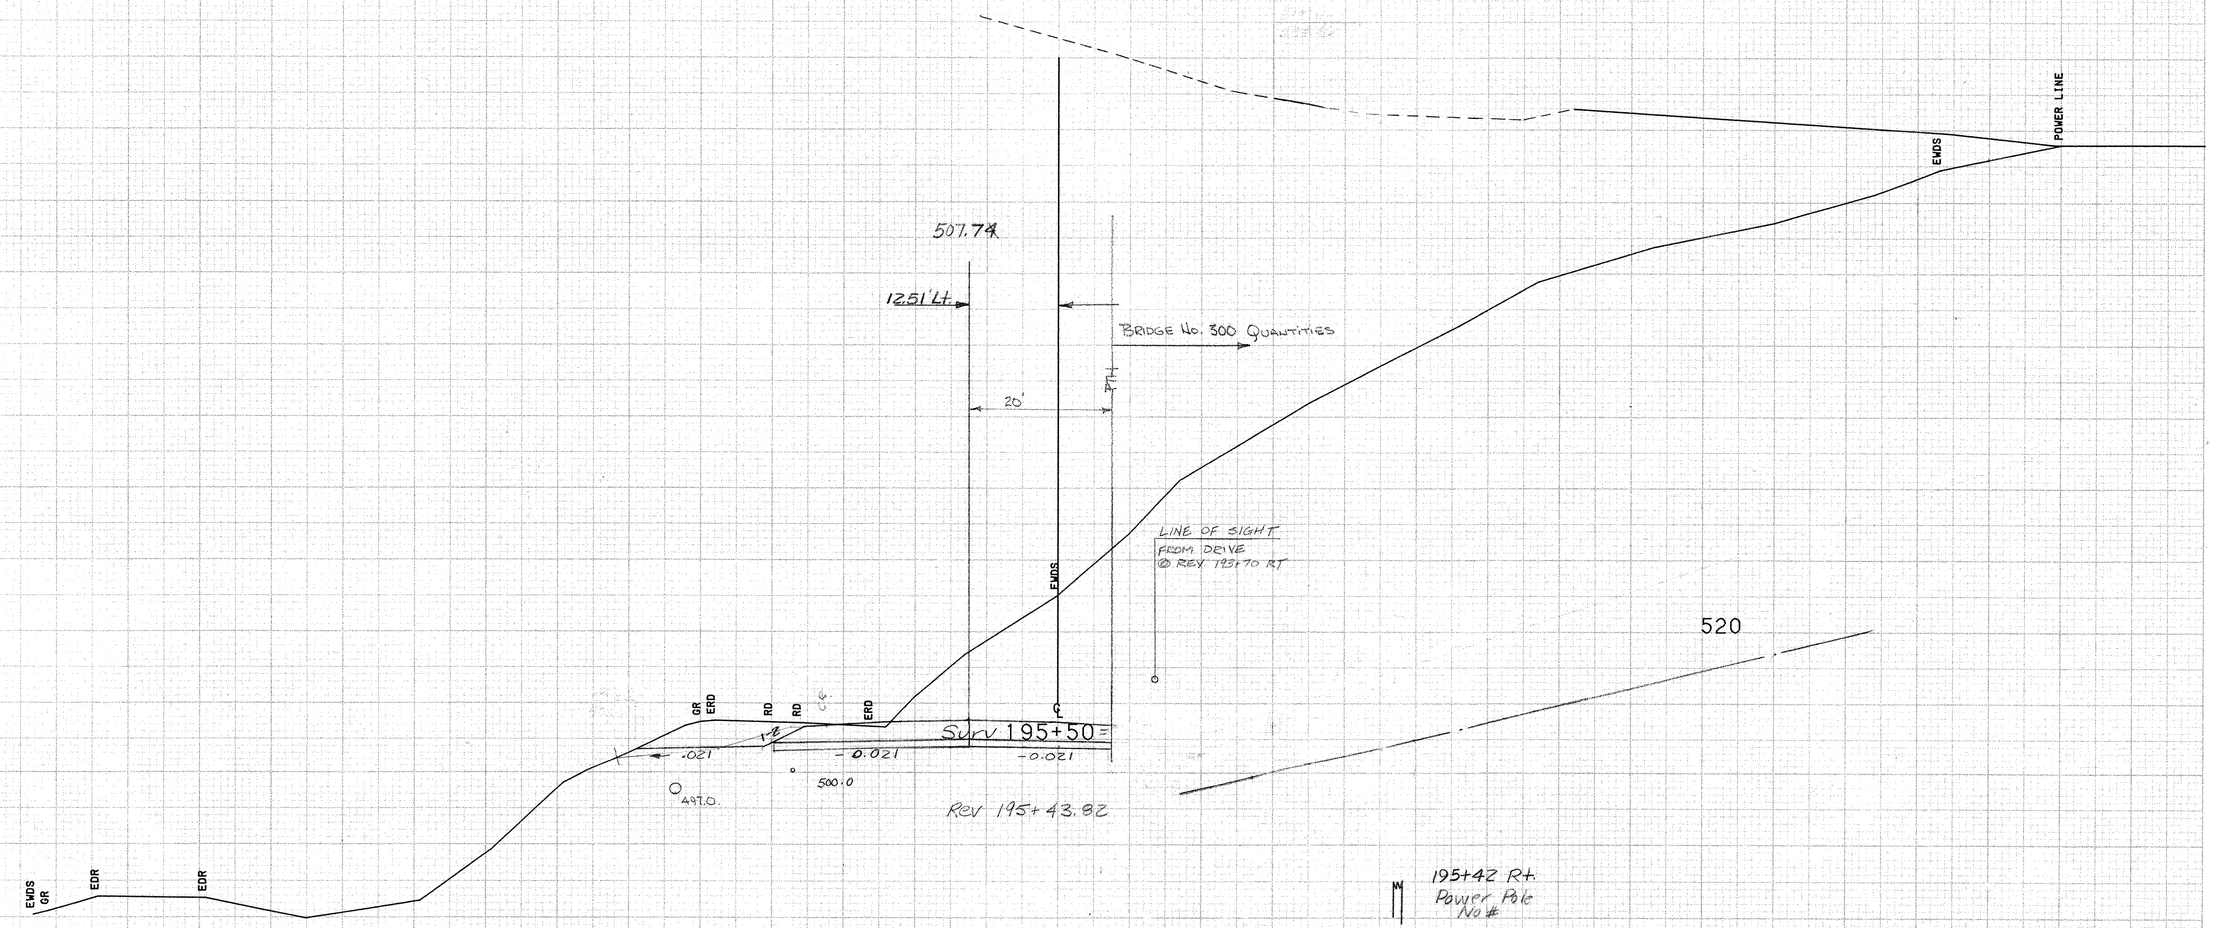

SCALE 10 FEET

FROM STA. 195+50	TO STA. 195+50
PROJECT NAME MORETOWN-MIDDLESEX	
NO. RS EGC RS0167 (9)	PLOTTED 02/29/88
SURVEYED BY MOREAU	01/86 0105
SHEET 95 OF 243 SHEETS	