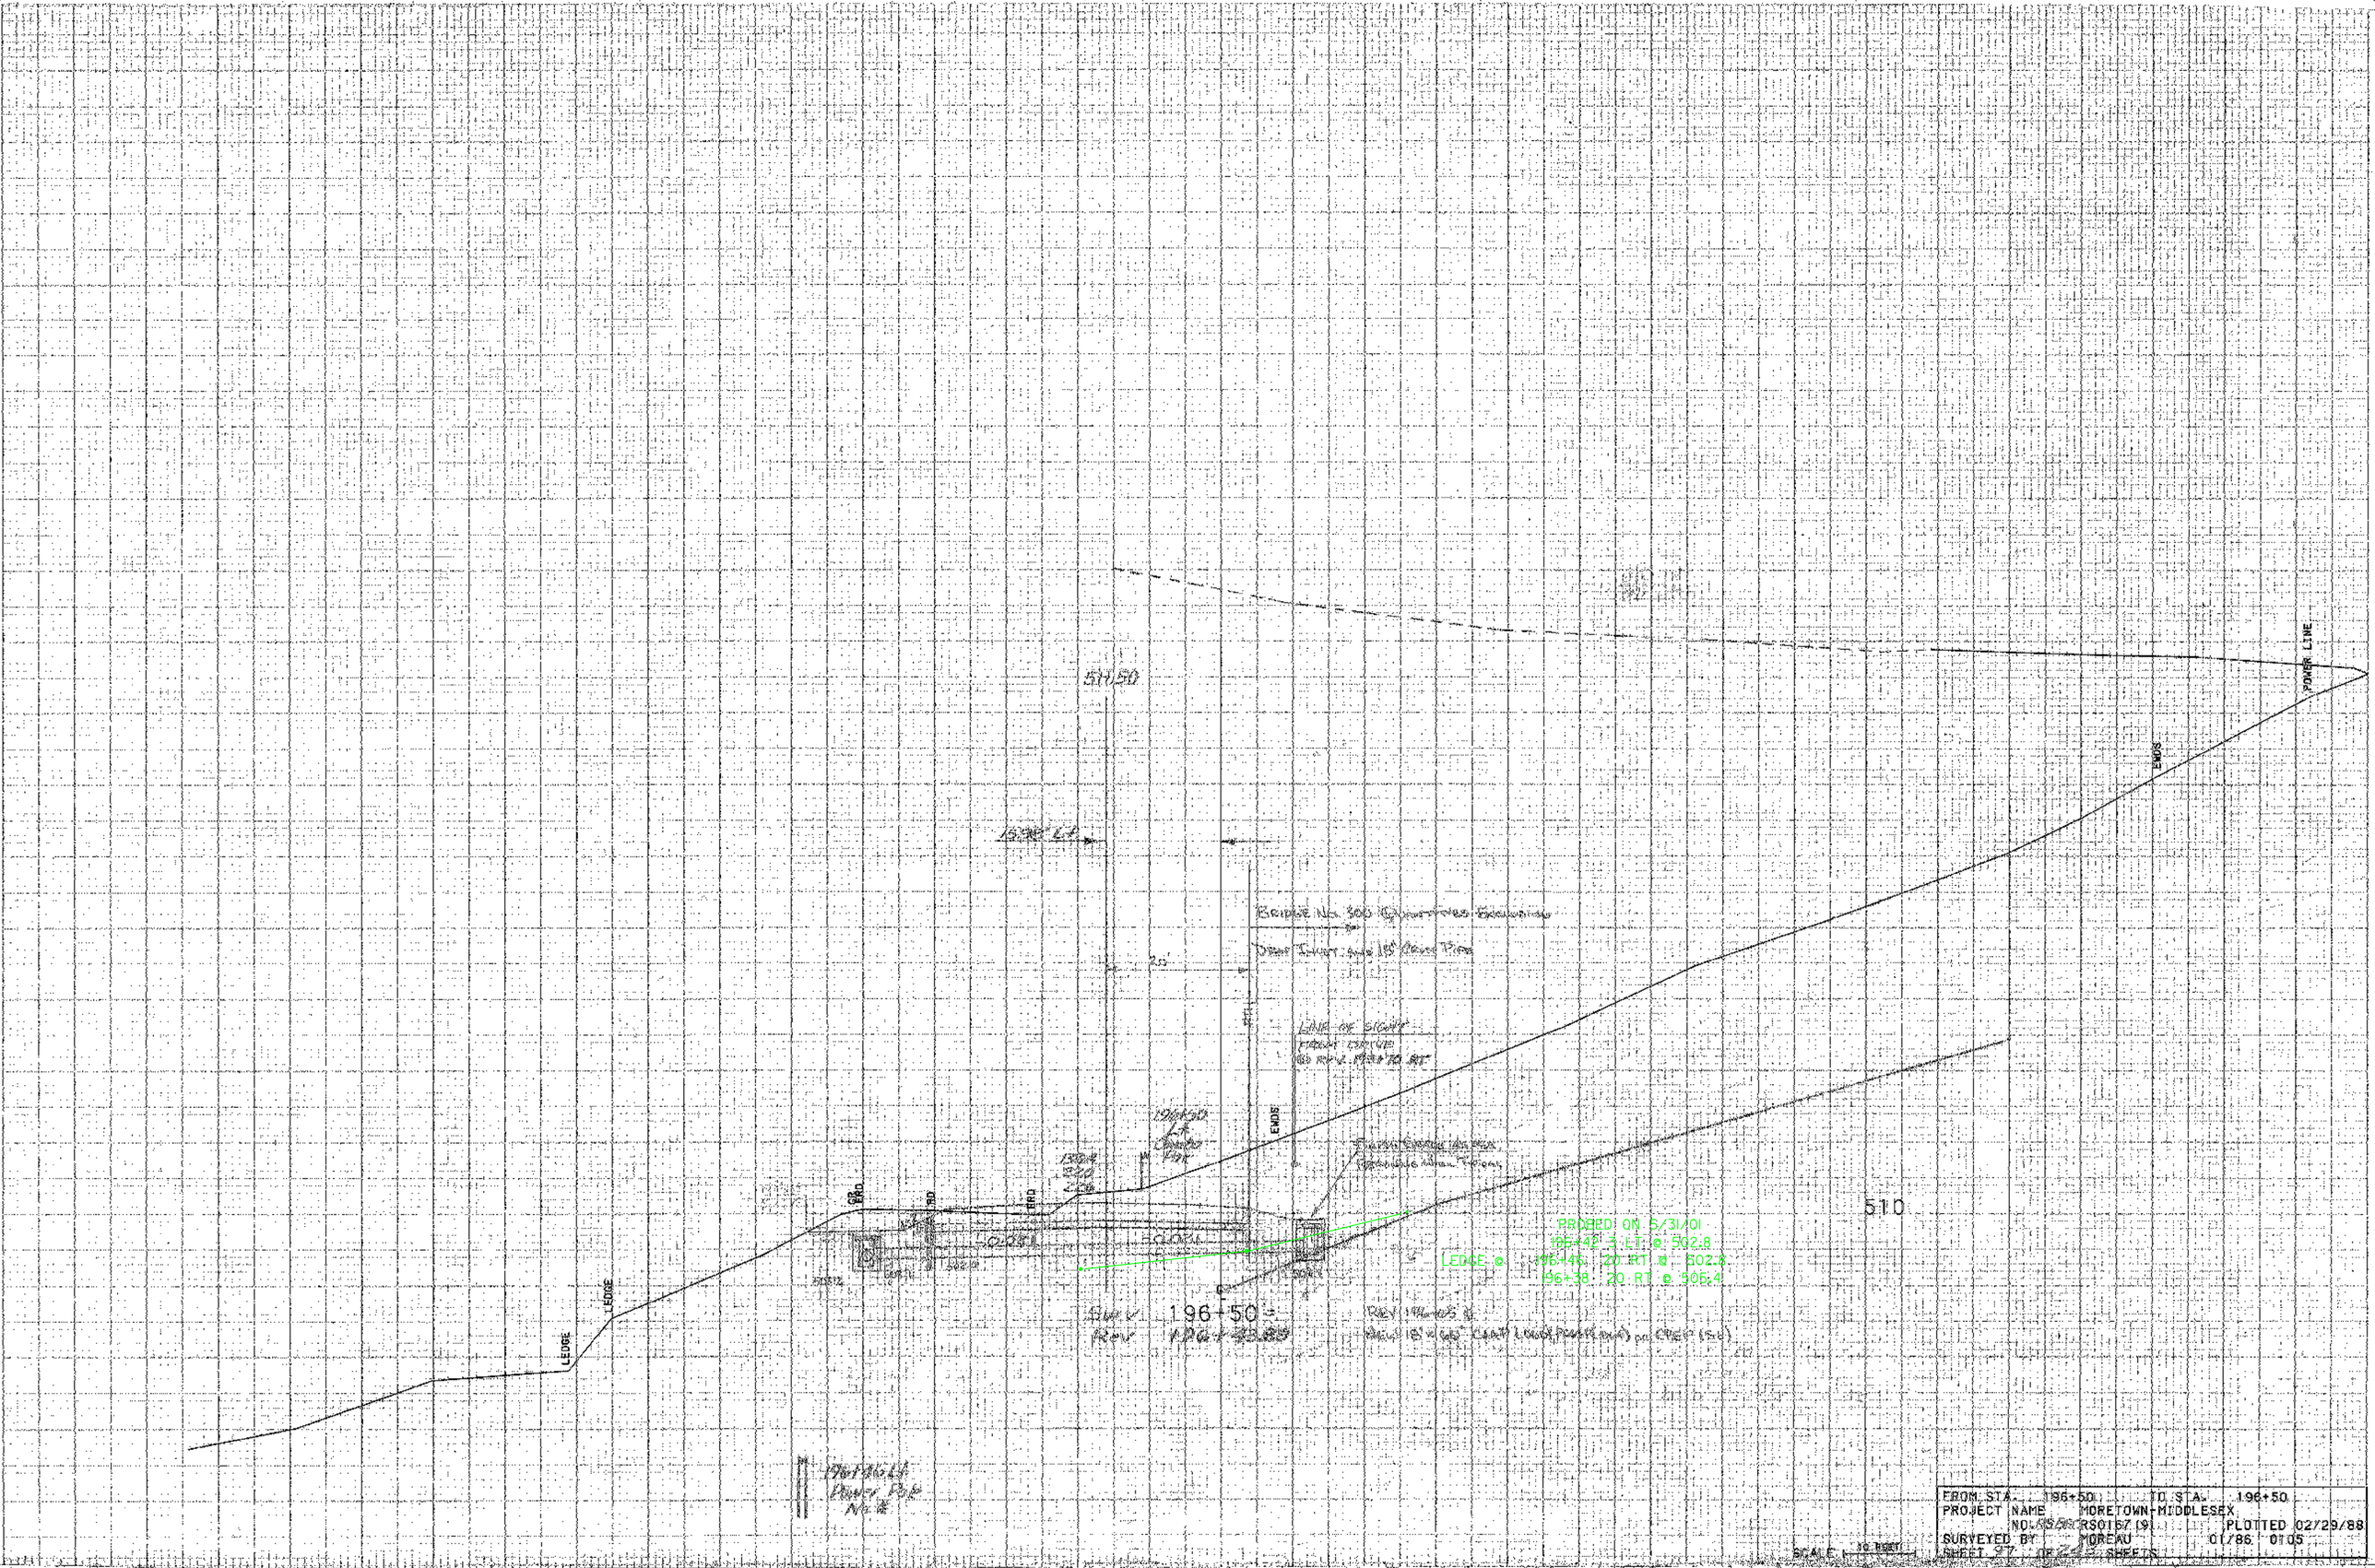
POWER LINE
EWOS
510
LEDGE
LEDGE
EWDS
ERD
ERD
ERD
PROBED ON 5/31/01
196+42, 3' LT @ 502.8
LEDGE @ 196+46, 20' RT @ 502.8
196+38, 20' RT @ 506.4
196+50
FROM STA. 196+50 TO STA. 196+50
PROJECT NAME MORETOWN-MIDDLESEX
NO. RS0167(9) PLOTTED 02/29/88
SURVEYED BY MOREAU 01/86 0105
SHEET 97 OF SHEETS
SCALE 1" = 10 FEET