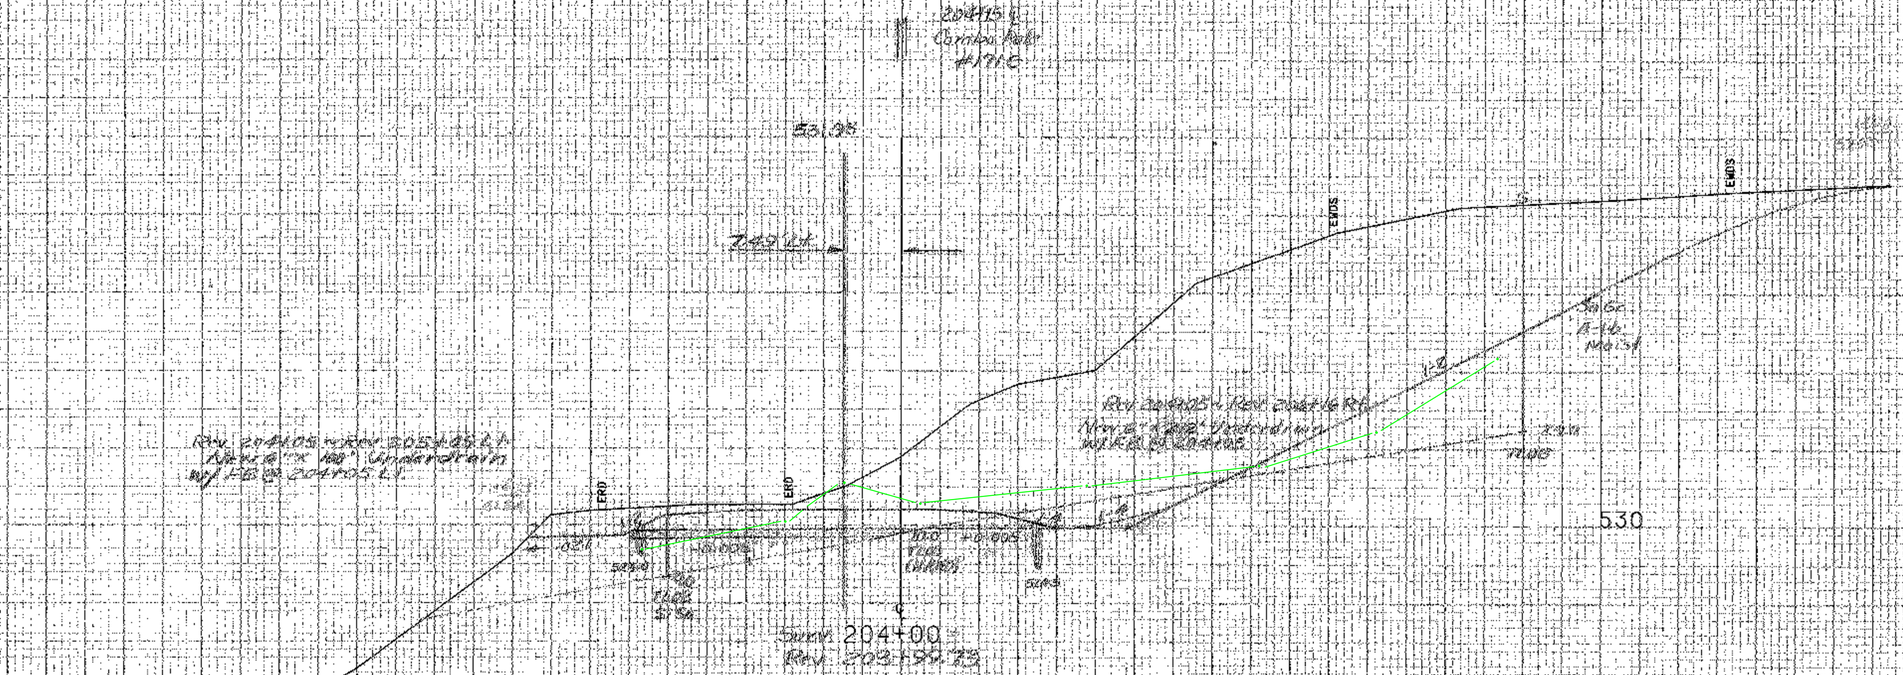

FROM STA. 204+00 TO STA. 204+00
PROJECT NAME MORETOWN-MIDDLESEX
NO. LRS0167 (9) PLOTTED 02/29/88
SURVEYED BY NYE 01/85 0105
SHEET 1 OF 1 SHEETS
SCALE 10 FEET