


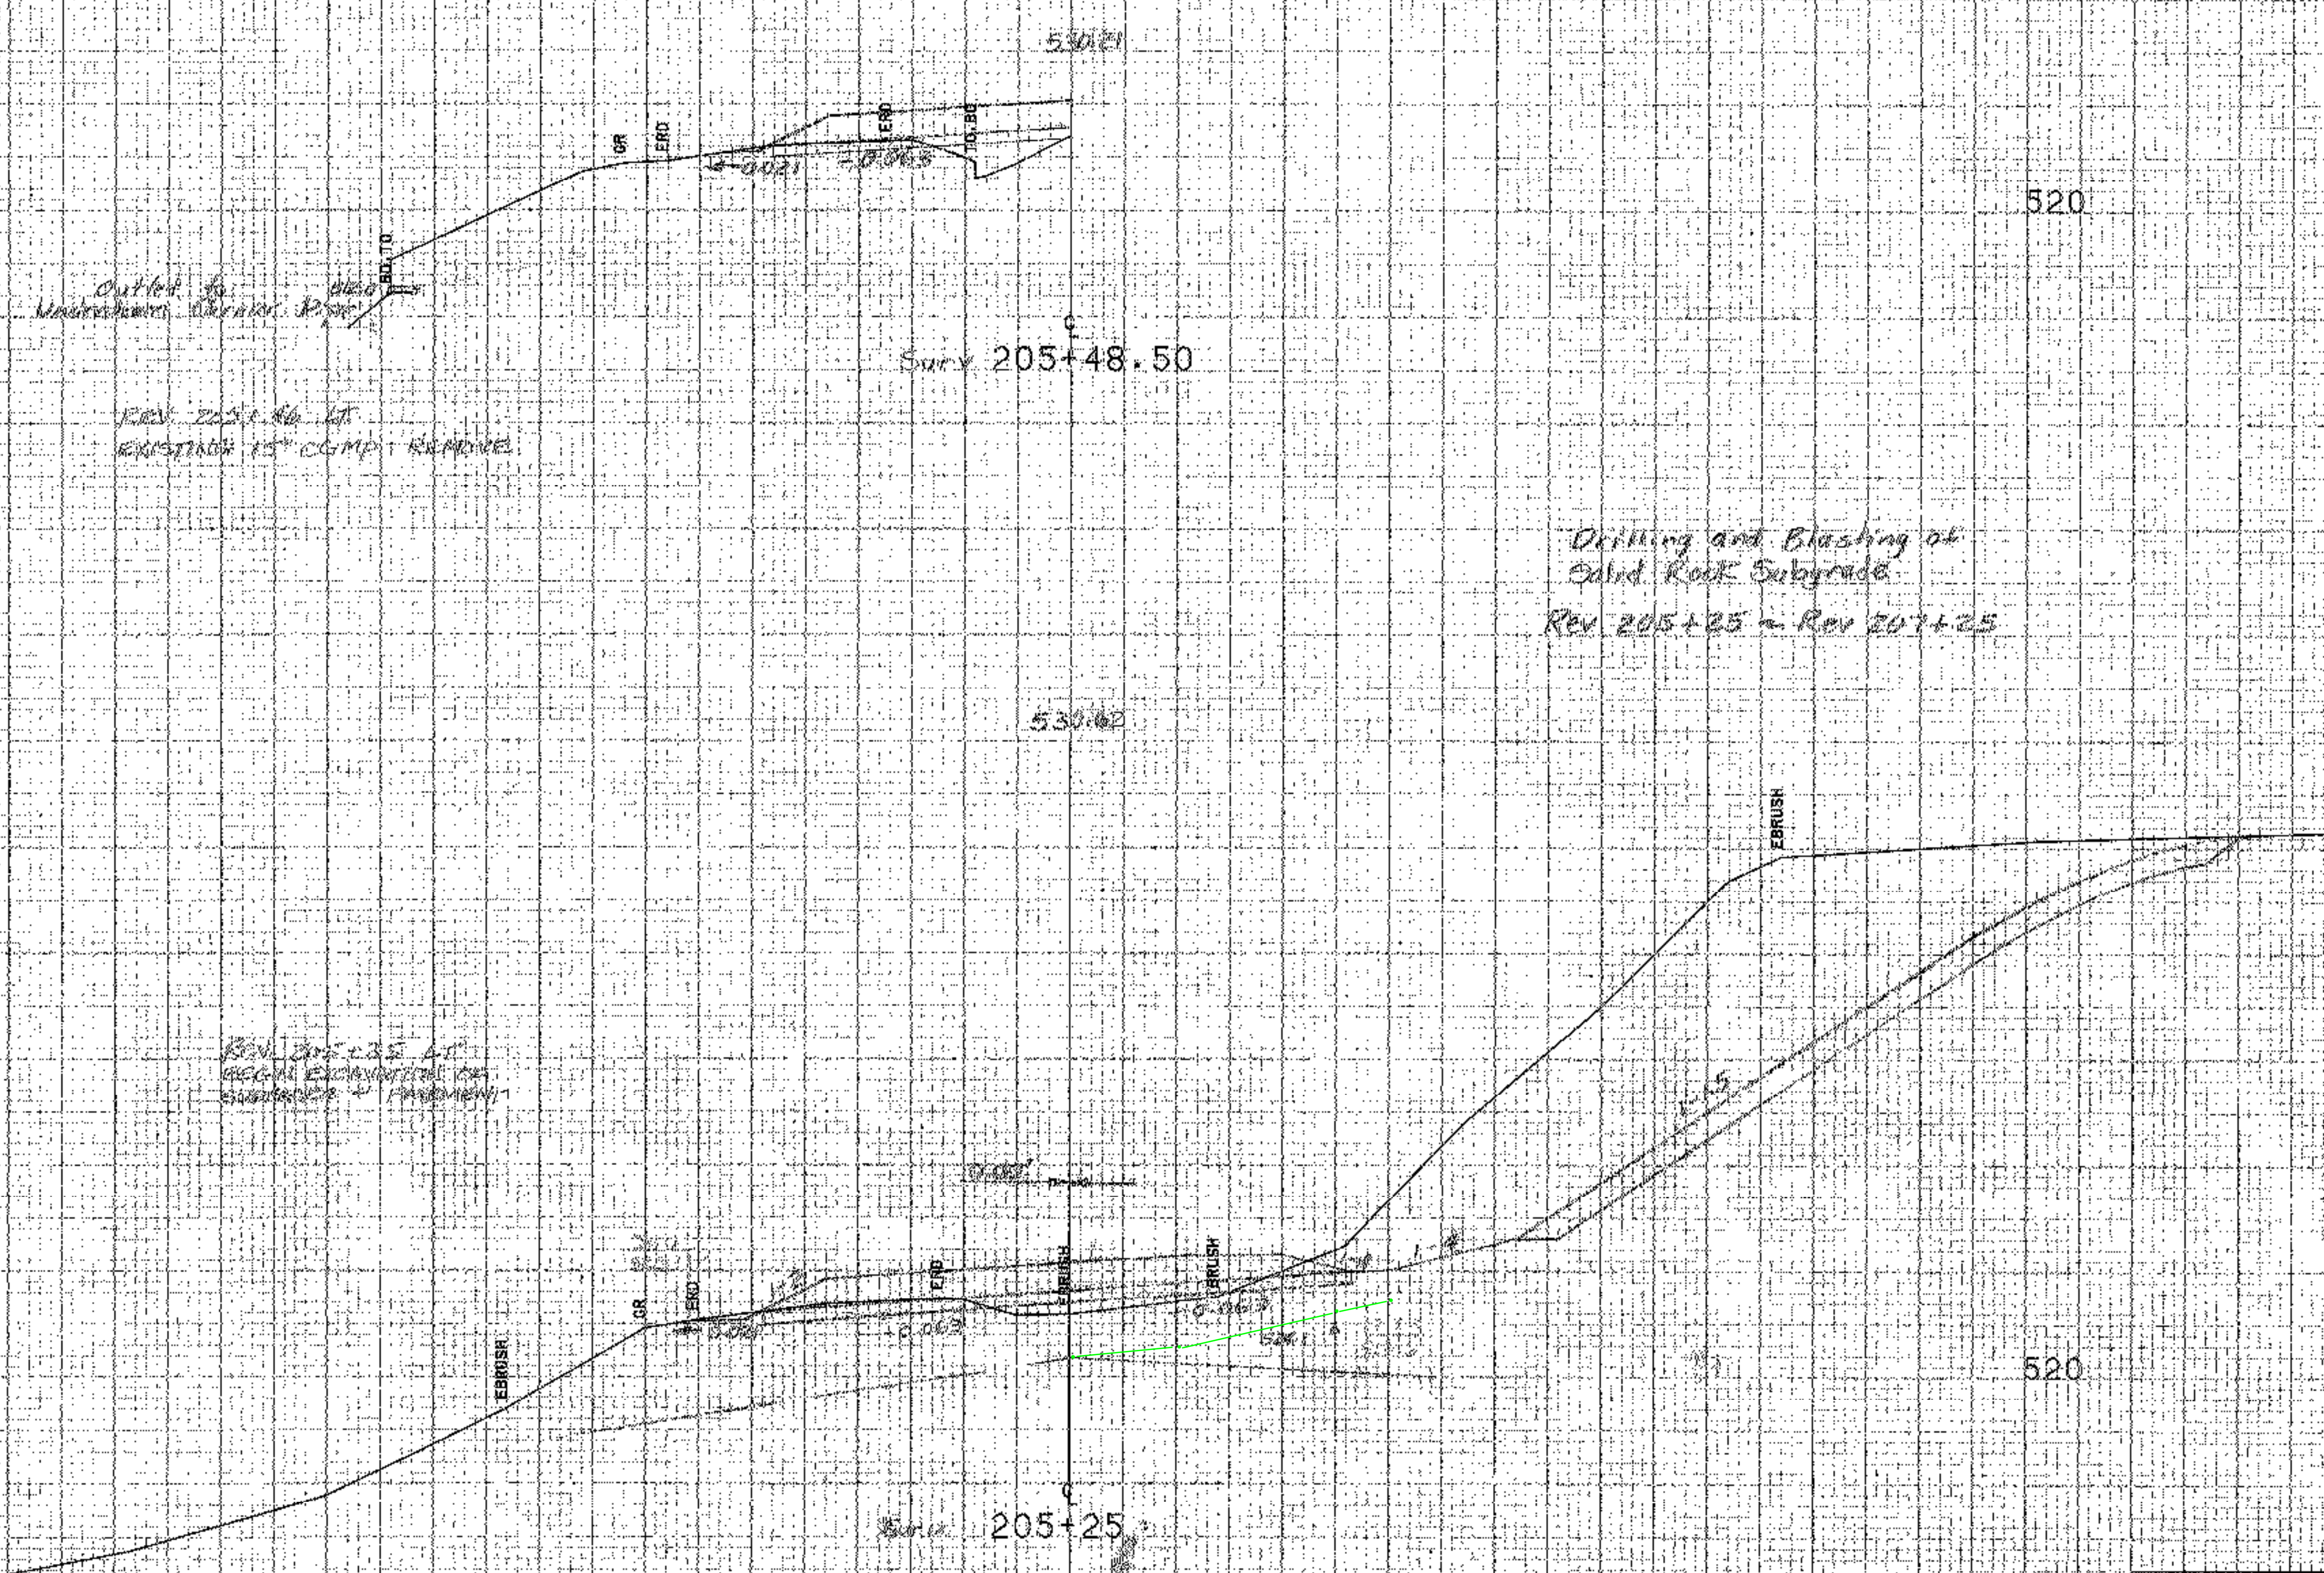

FROM STA.	205+25	TO STA.	205+48.50
PROJECT NAME	MORRISTOWN-MIDDLESEX		
NO.	100	DATE	01/85
SURVEYED BY	NYE	PLOTTED	02/20/88
SHEET	10	OF	23 SHEETS

SCALE 1" = 10 FEET