


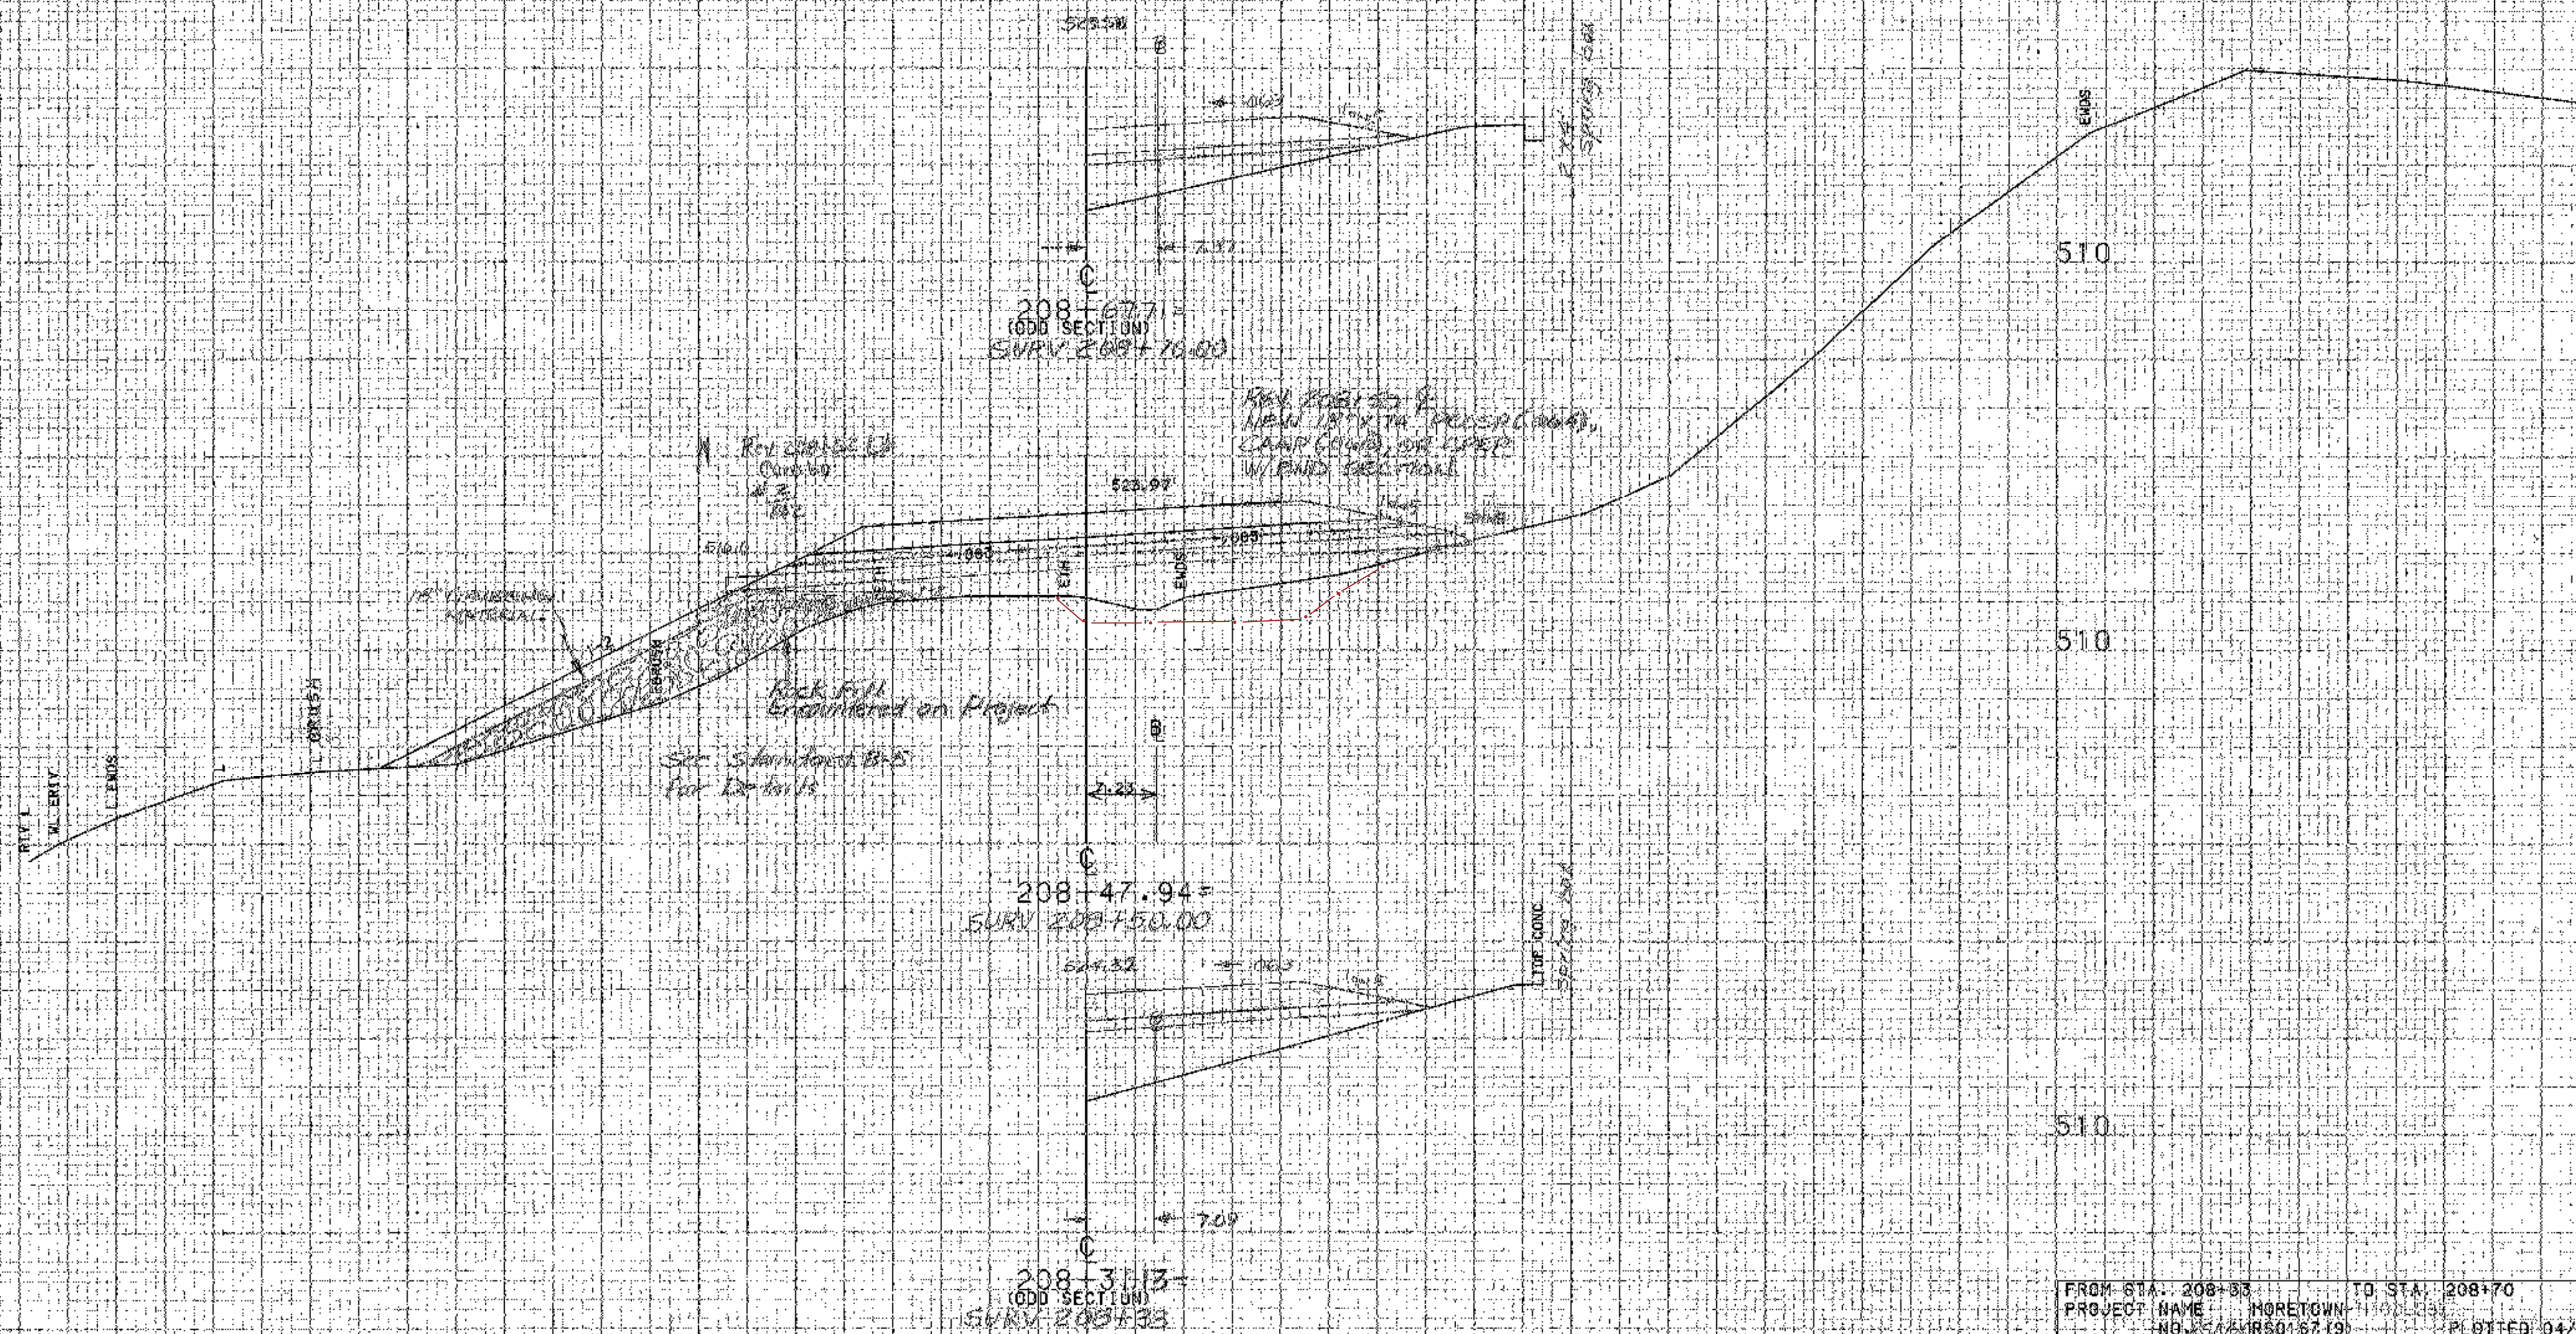

FROM STA. 208+33	TO STA. 208+70
PROJECT NAME MORETOWN	NO. 3542 (RSO 16719)
SURVEYED BY MOREAU	PLOTTED 04/22/67
SHEET 1A OF 22 SHEETS	01/86 0639

SCALE 1" = 10 FEET