


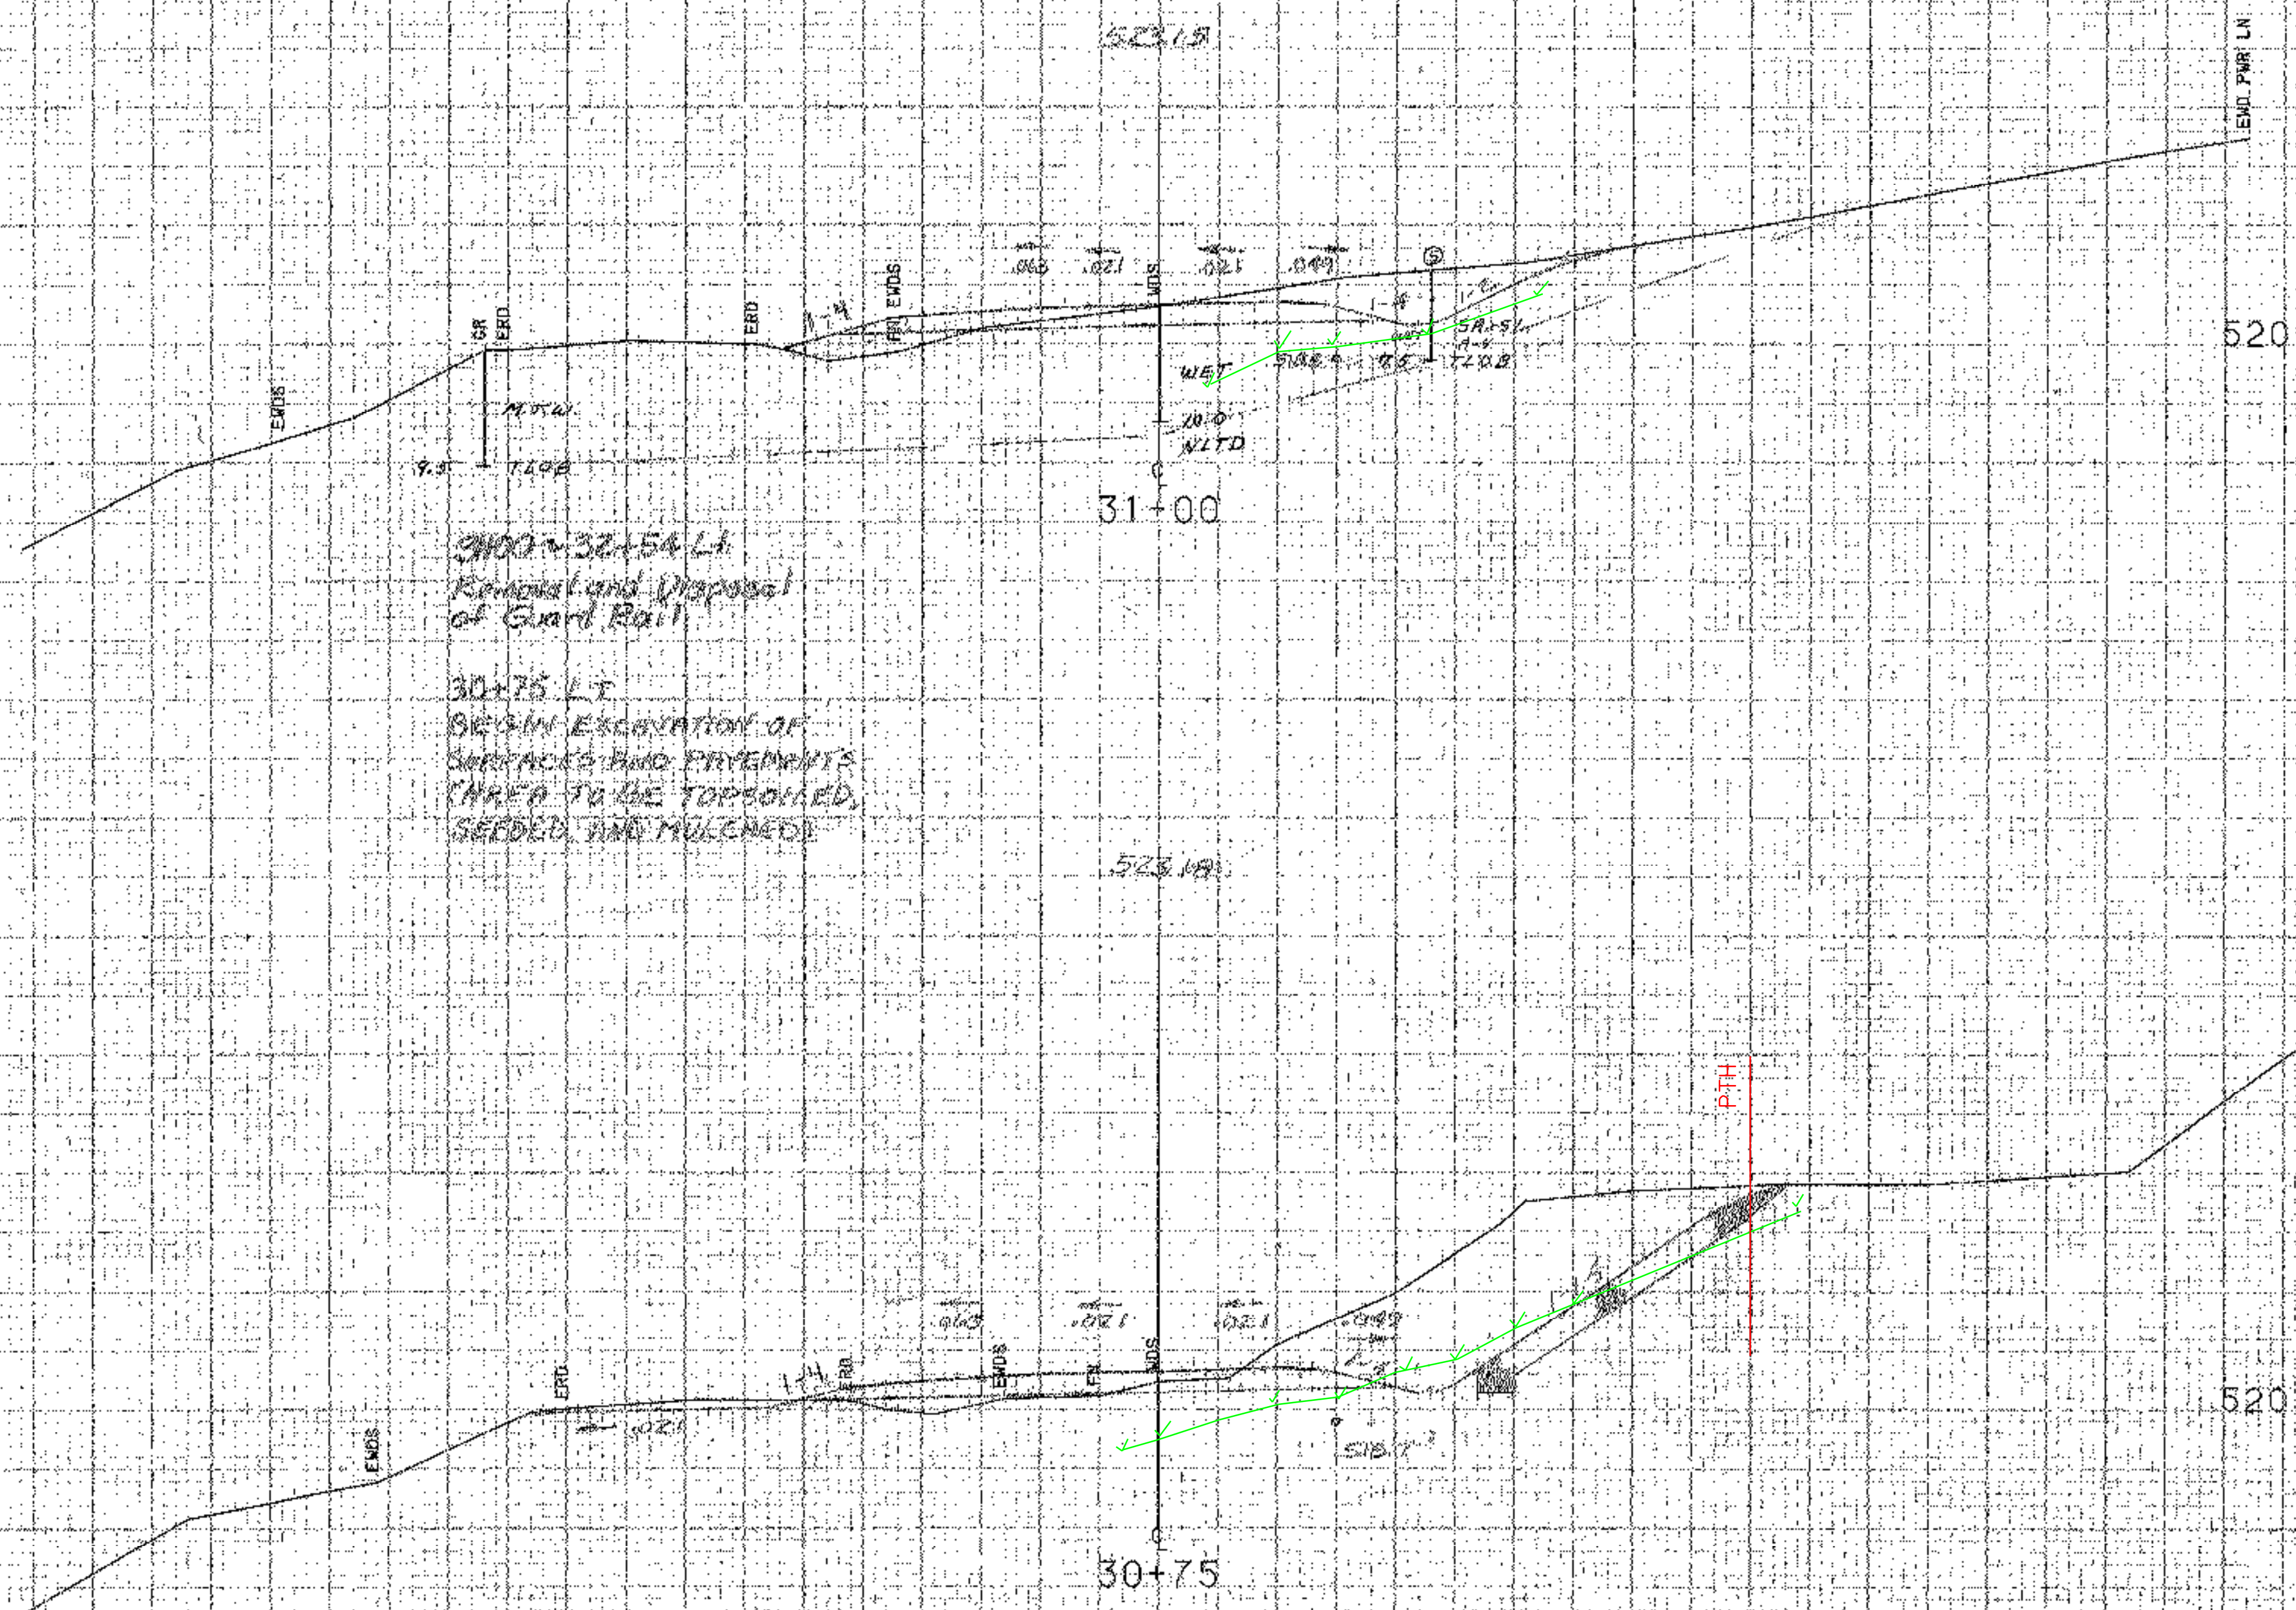

FROM STA.	30+75	TO STA.	31+00
PROJECT NAME	MORETOWN		
NO.	RS0167191	TH2	
SURVEYED BY	NYE		
SHEET	178	OF 213 SHEETS	
PLOTTED	06/09/86		
JAN	1985		

SCALE 1"=10 FEET