


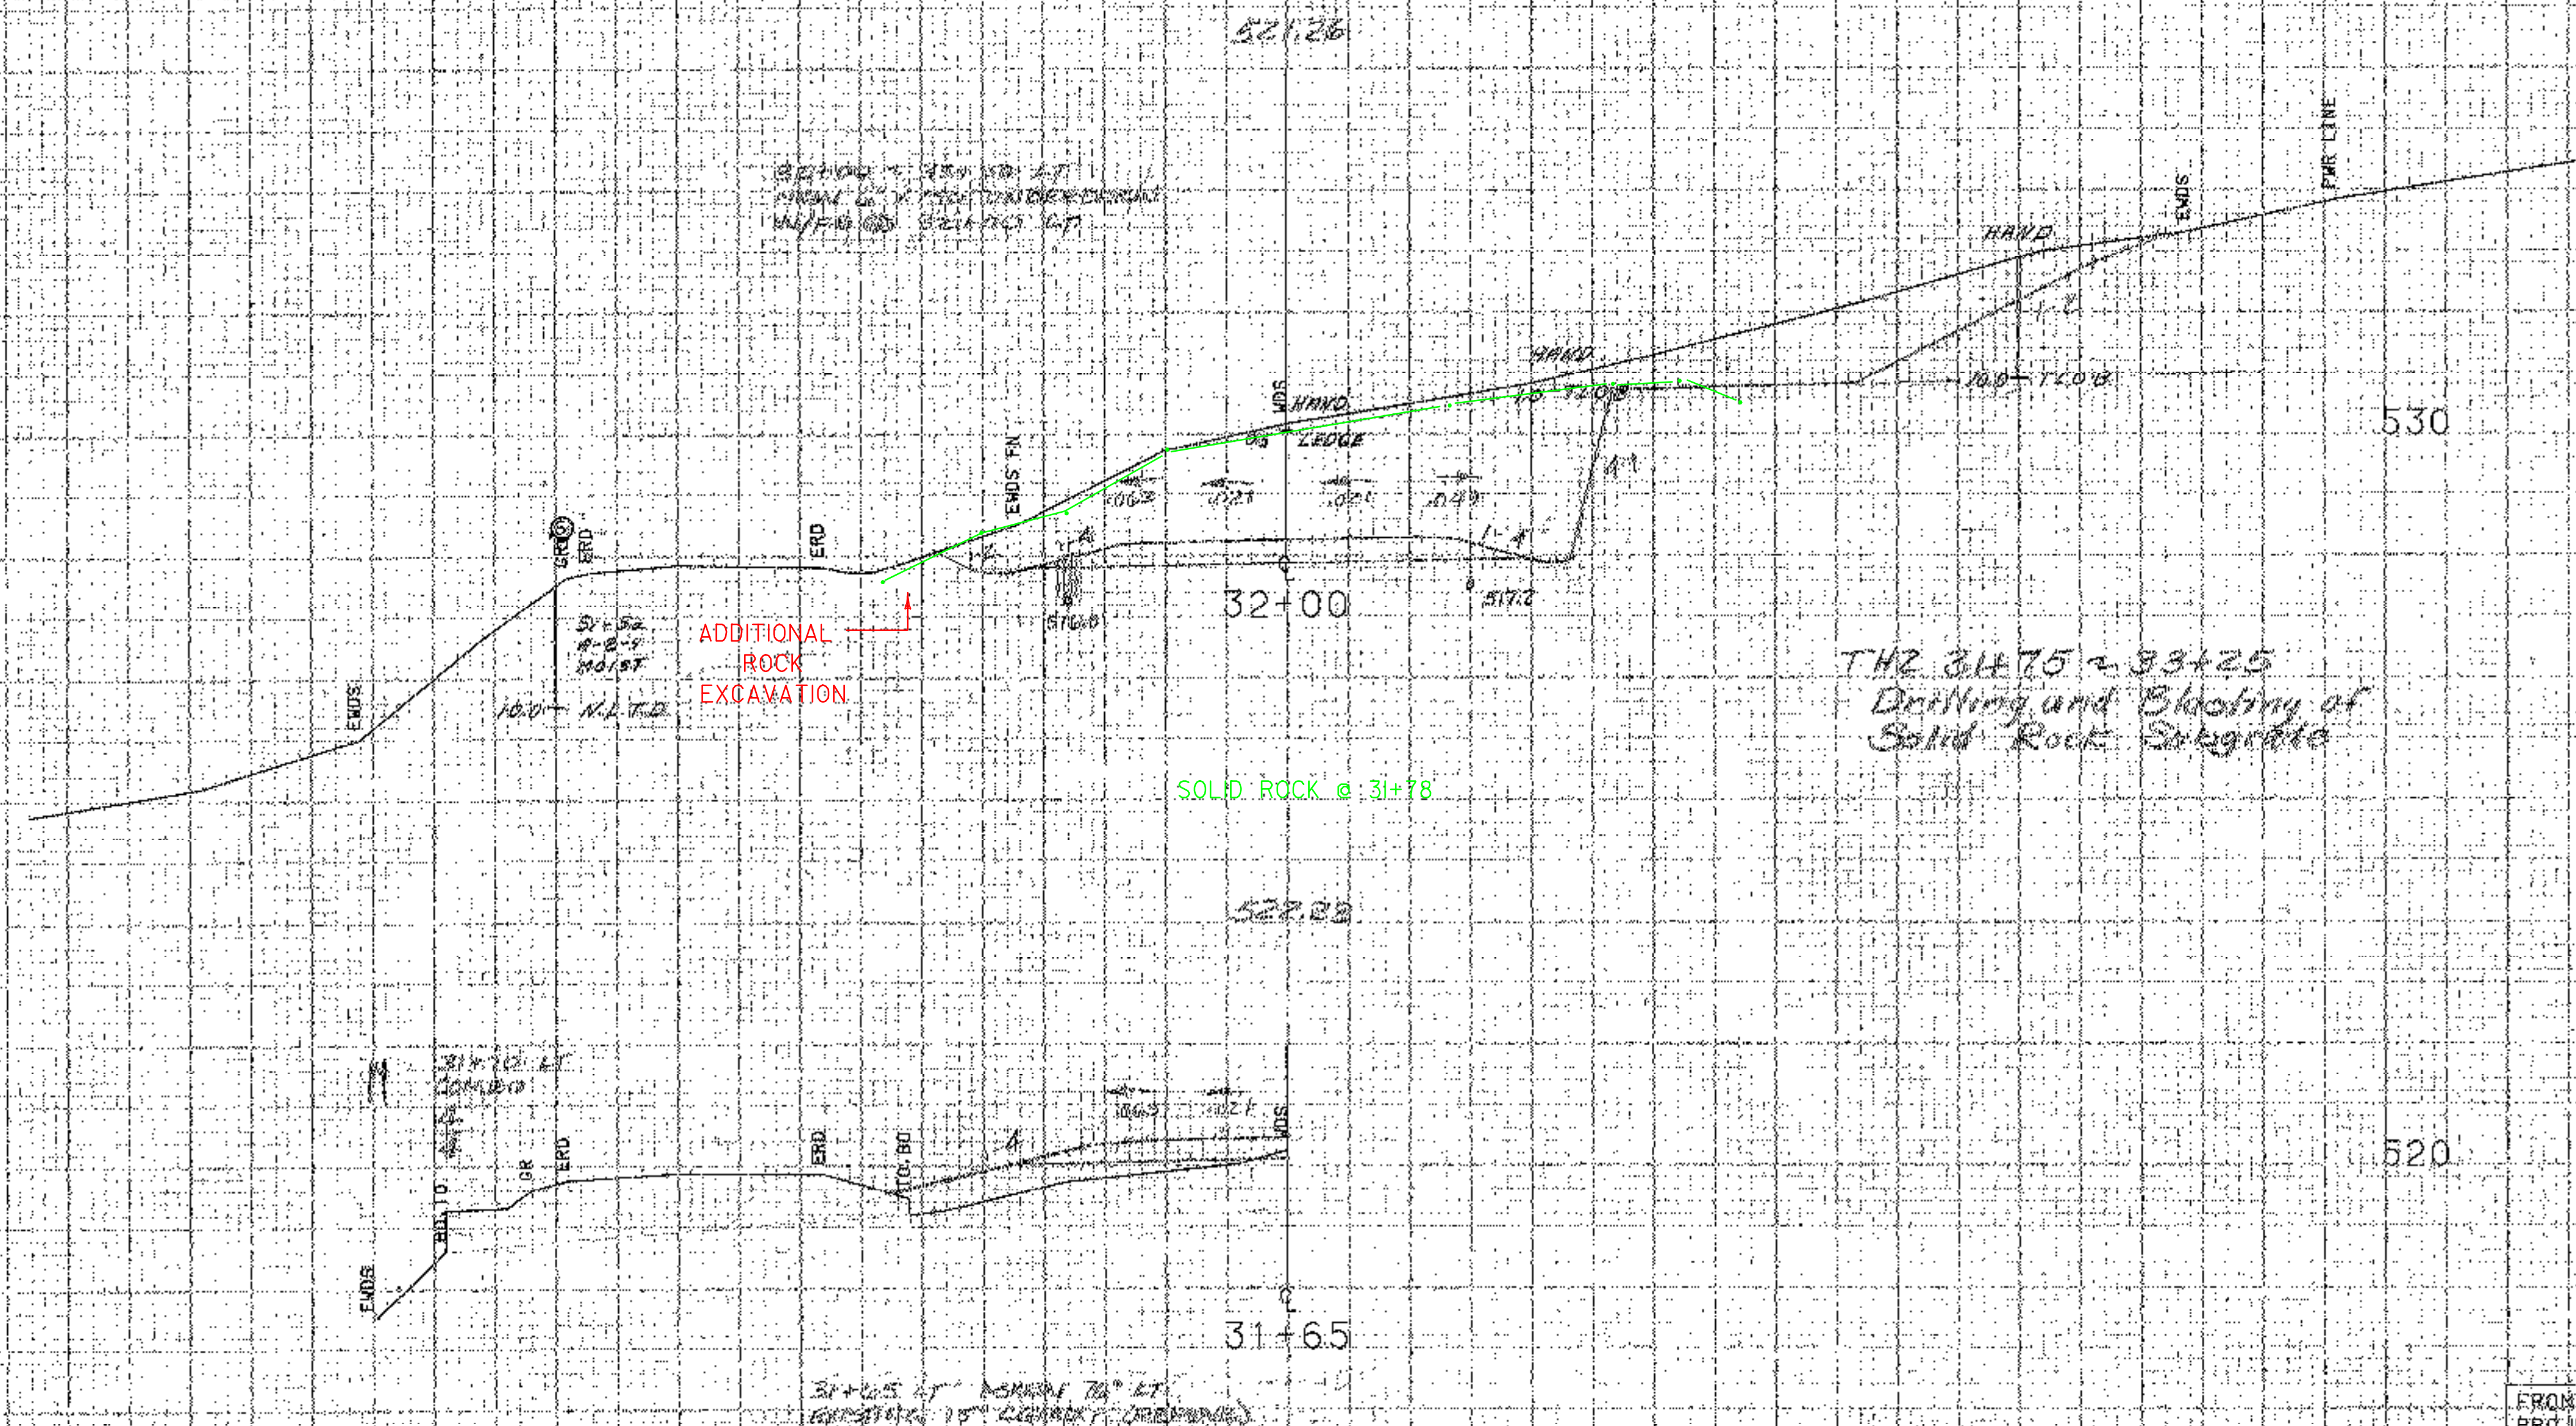

FROM STA.	31+65	TO STA.	32+00
PROJECT NAME	MORETOWN TOWNSHIP TH2		
NO. OF SHEETS	RS0157 (9)	DATE	06/09/86
SURVEYED BY	NYE	PLOTTED	JAN 1985
SHEET NO.	DE 243	SHEETS	