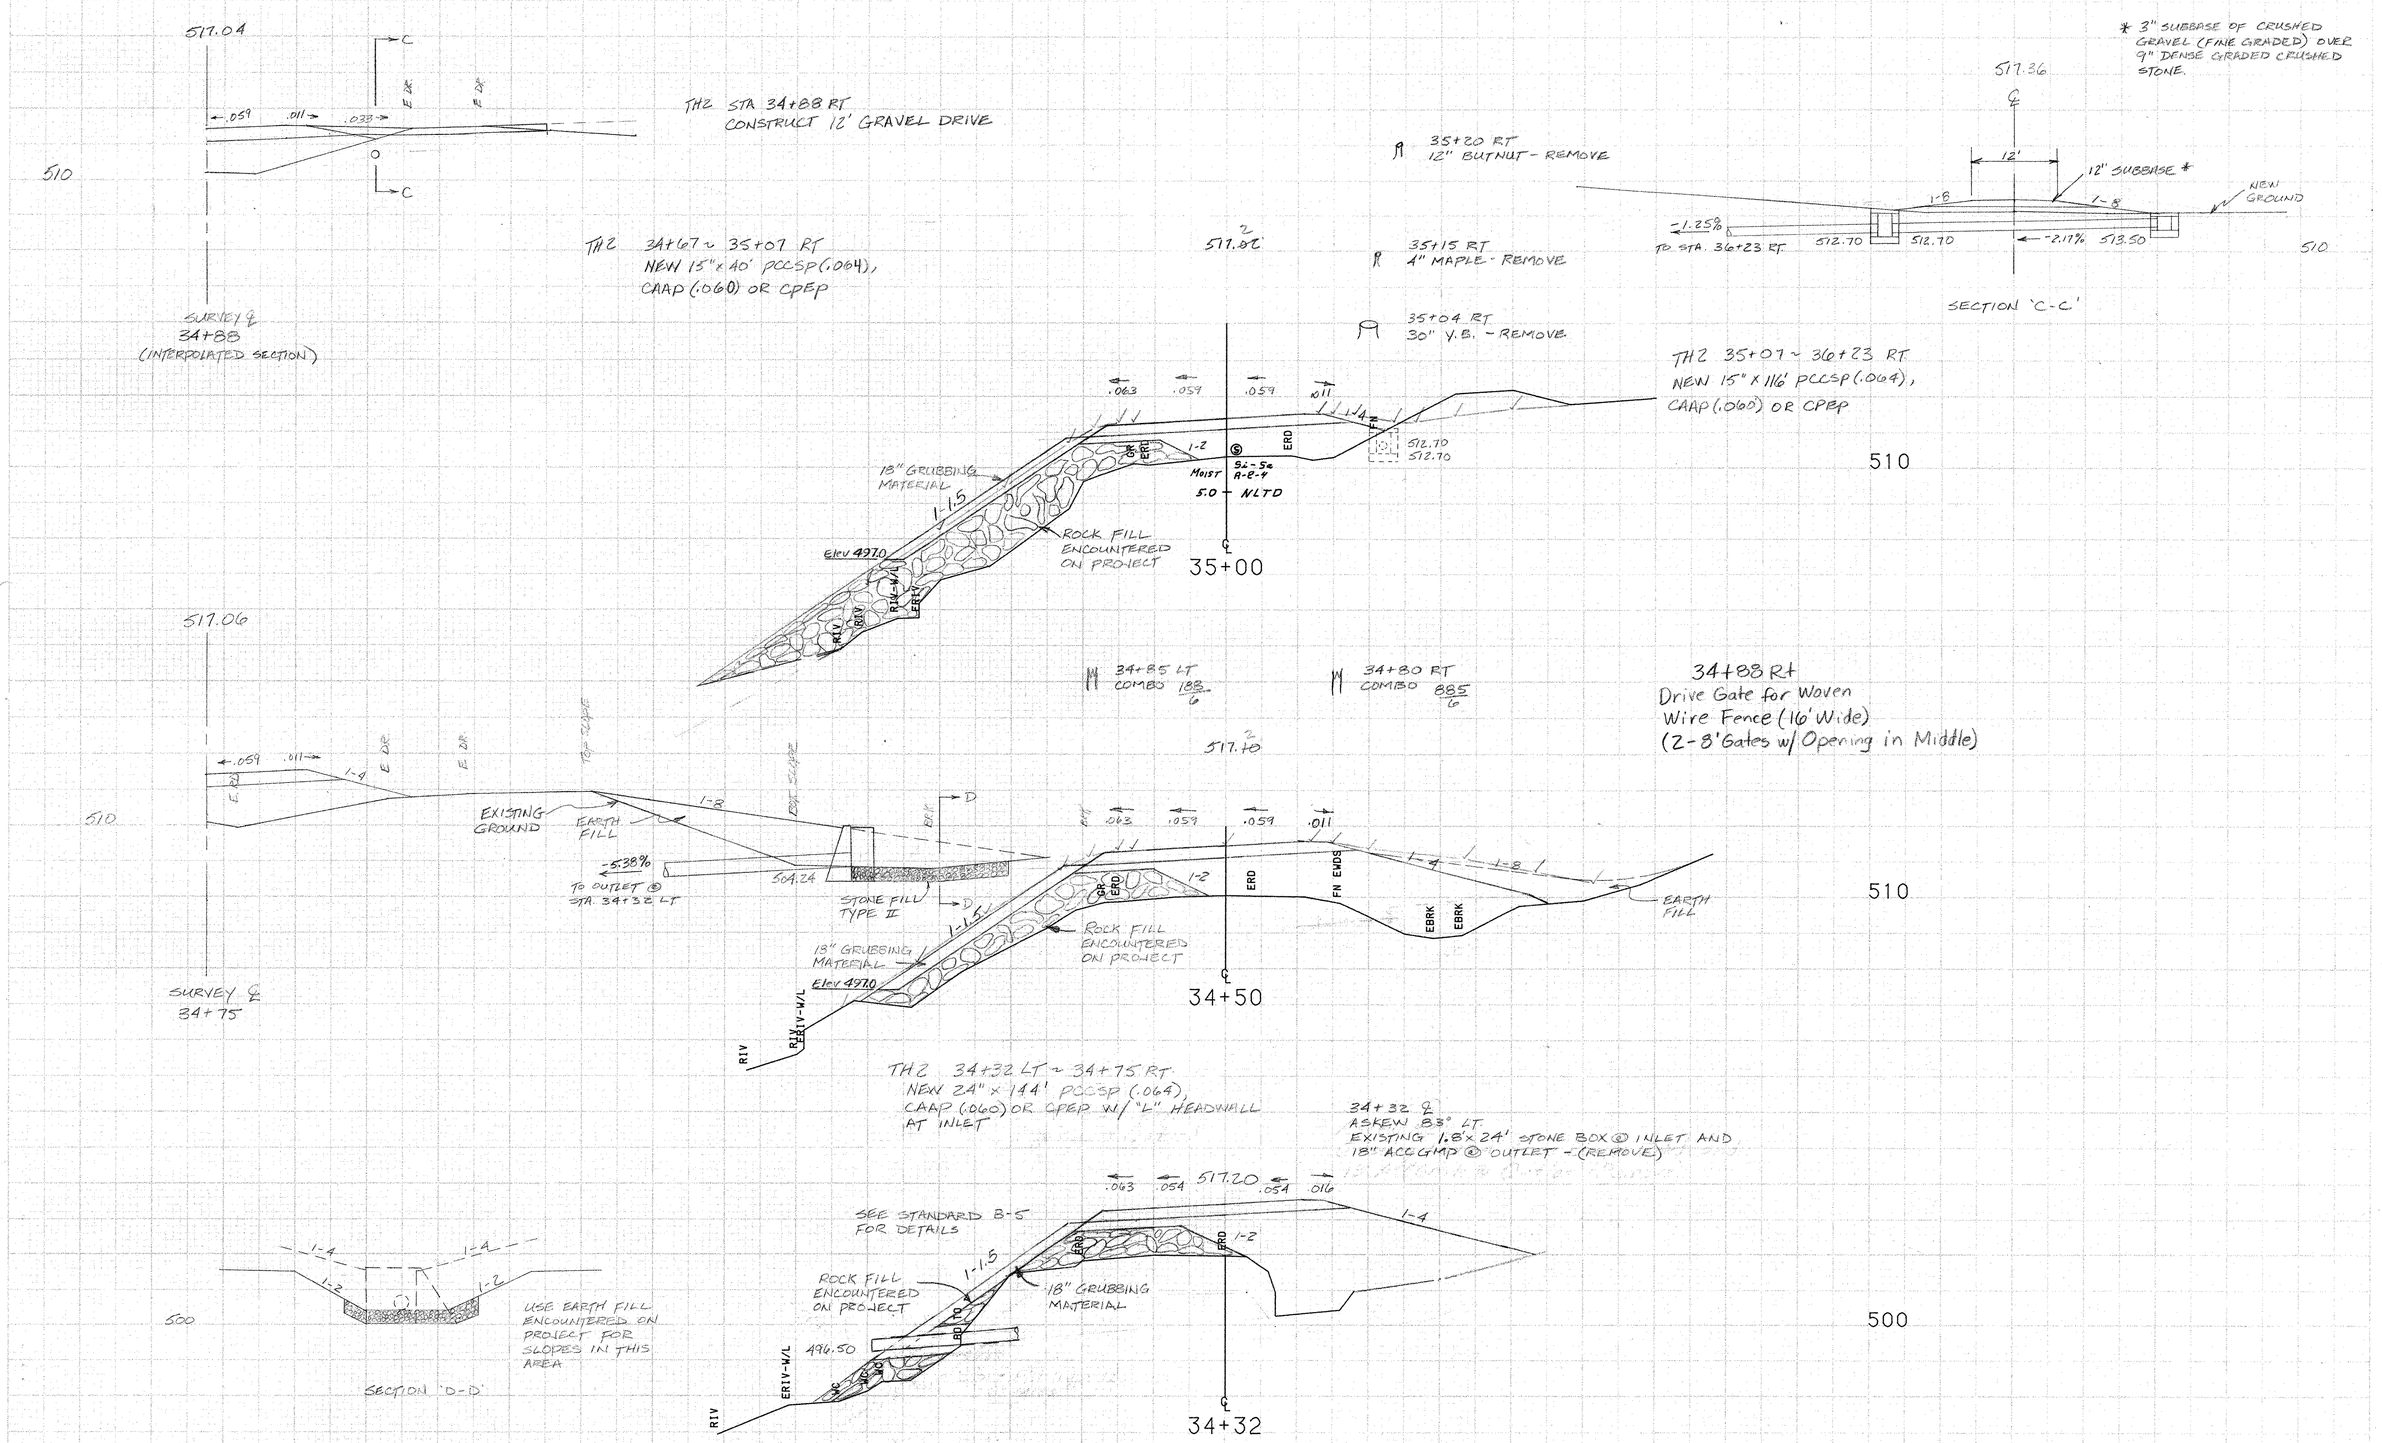

* 3" SUBBASE OF CRUSHED GRAVEL (FINE GRADED) OVER 9" DENSE GRADED CRUSHED STONE.

517.36
℄
12'
12" SUBBASE *
NEW GROUND
1-8
1-8
-1.25%
TO STA. 36+23 RT
512.70
512.70
-2.17%
513.50
510
SECTION 'C-C'

FROM STA. 34+32	TO STA. 35+00
PROJECT NAME MORETOWN-MIDDLESEX	TH2
NO. R5EG(RS0167(9)	PLOTTED 06/09/86
SURVEYED BY NYE	JAN 1985
SHEET 125 OF 243 SHEETS	