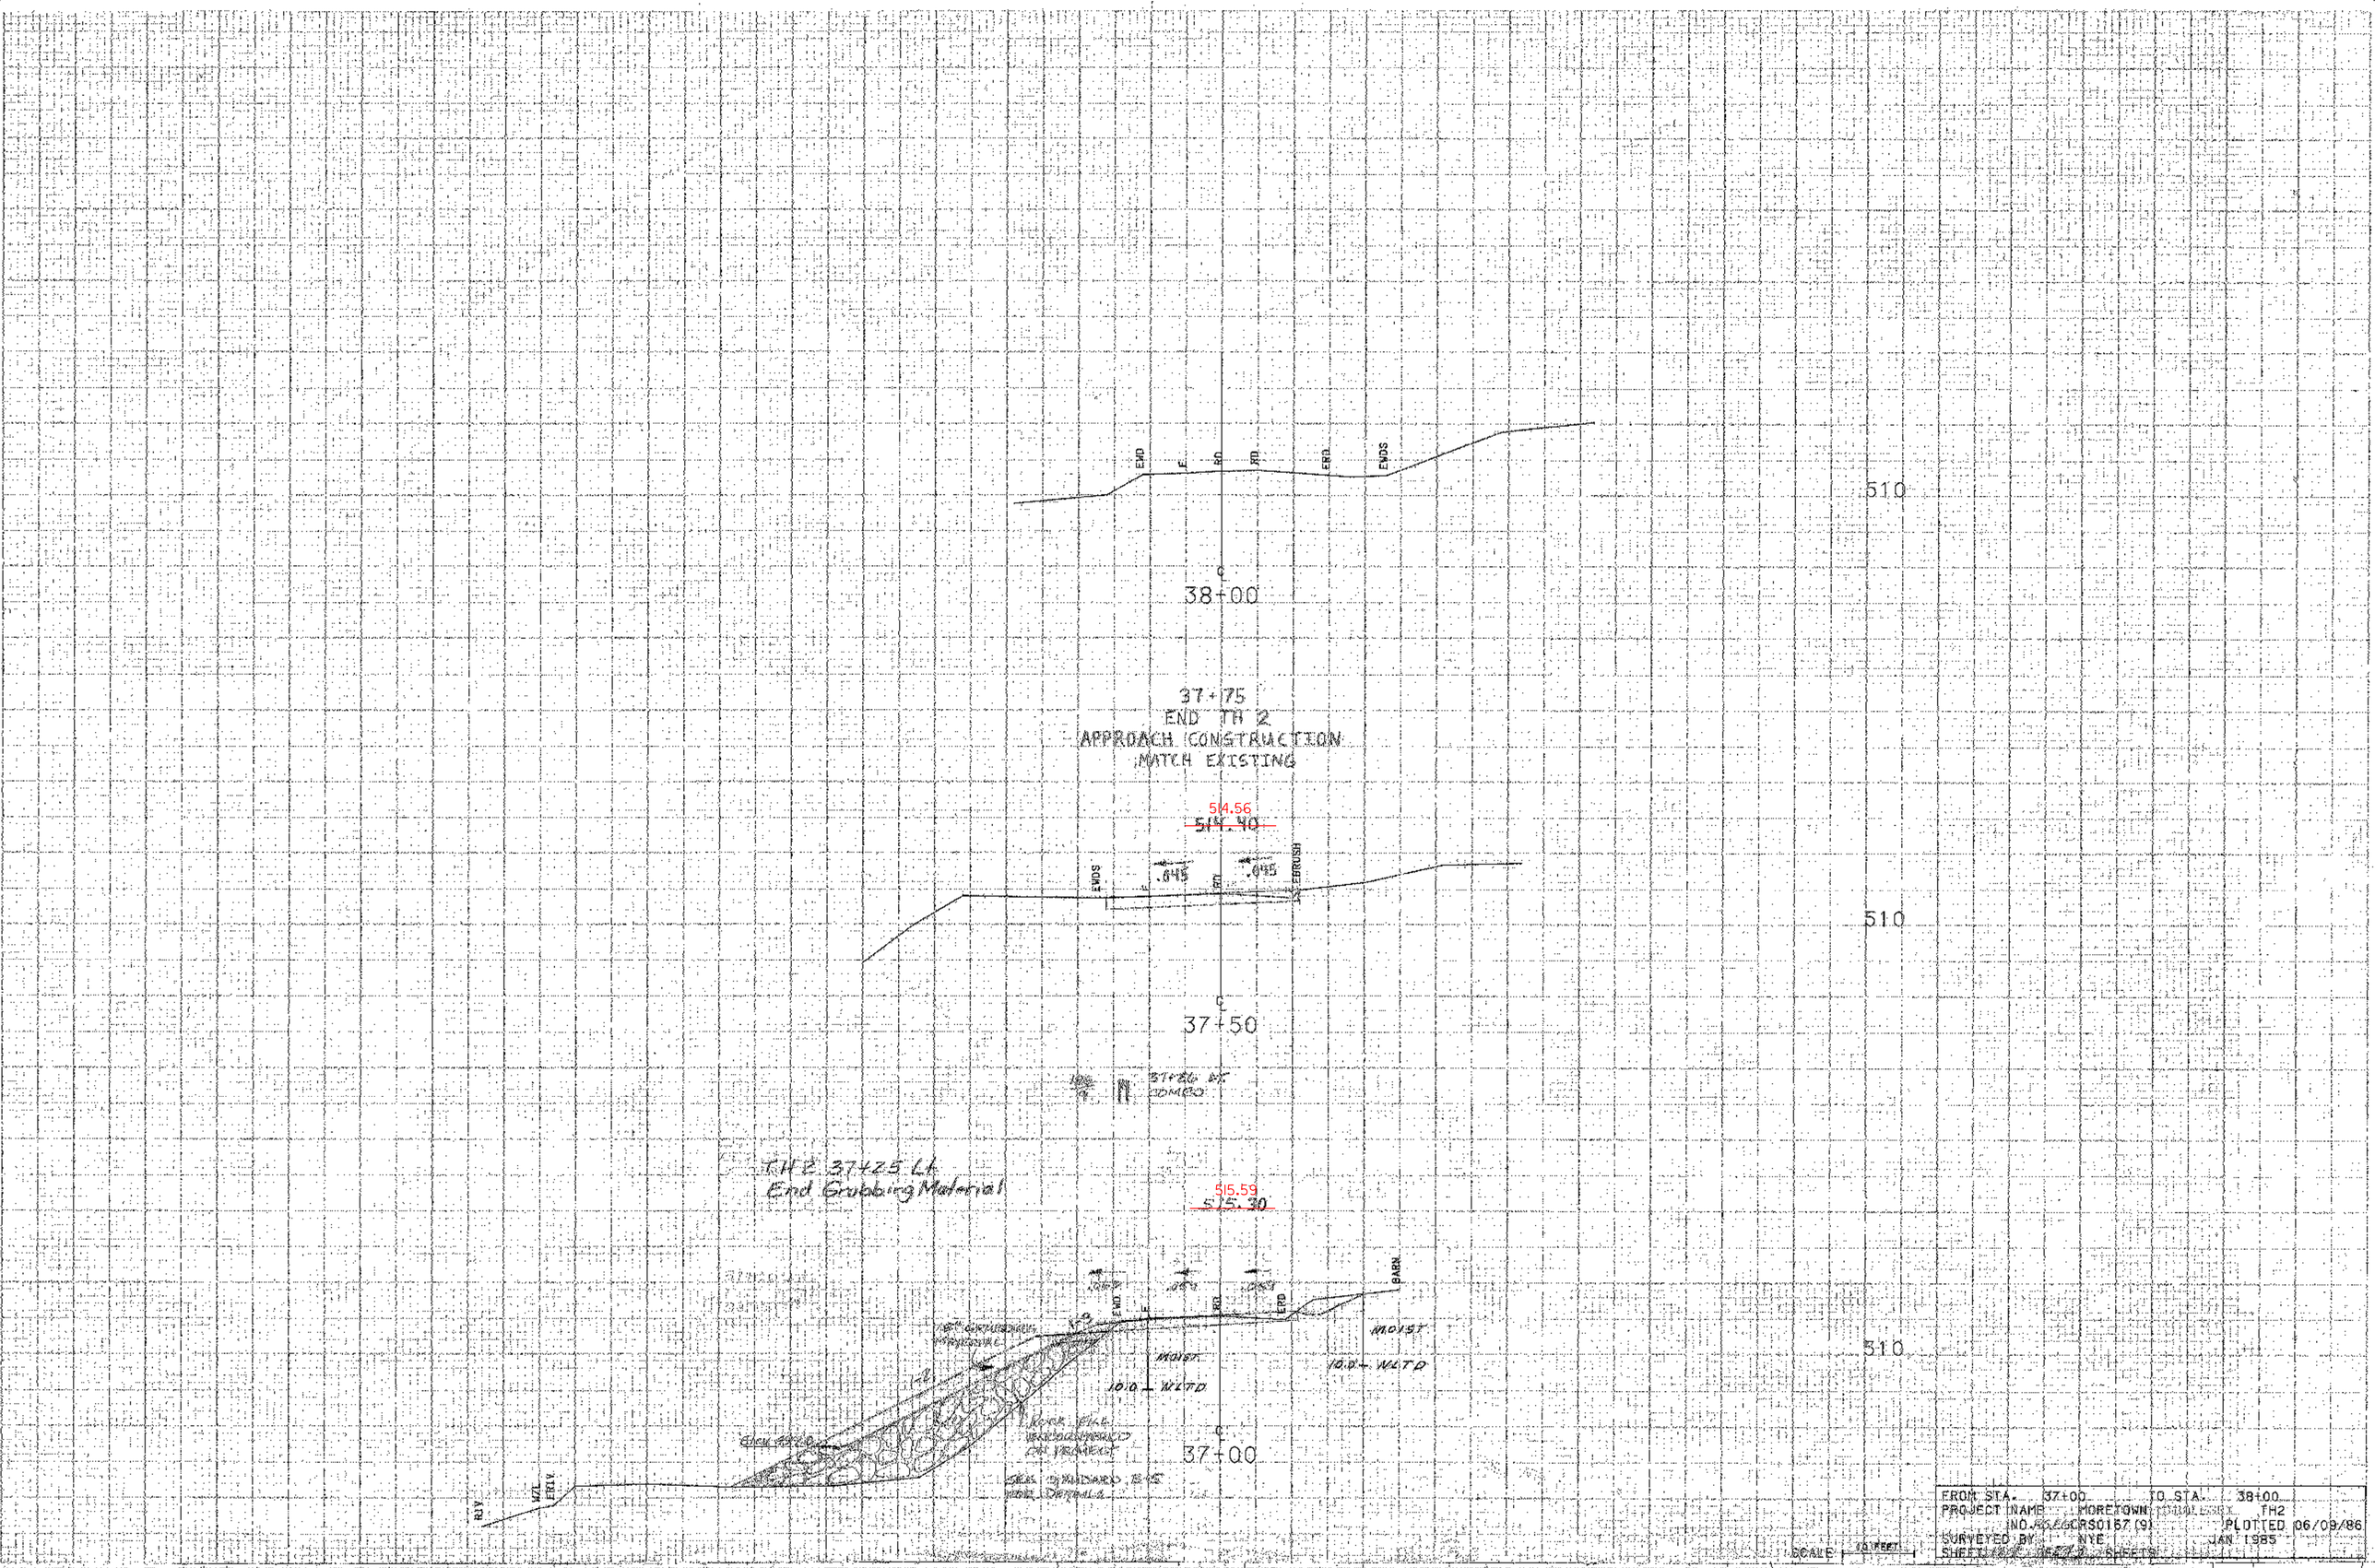

FROM STA. 37+00	TO STA. 38+00
PROJECT NAME MORETOWN	TH2
NO. [illegible]GRS0157 (9)	PLOTTED 06/09/86
SURVEYED BY NYE	JAN 1985
SHEET [illegible] OF [illegible] SHEETS	

SCALE 1" = 10 FEET