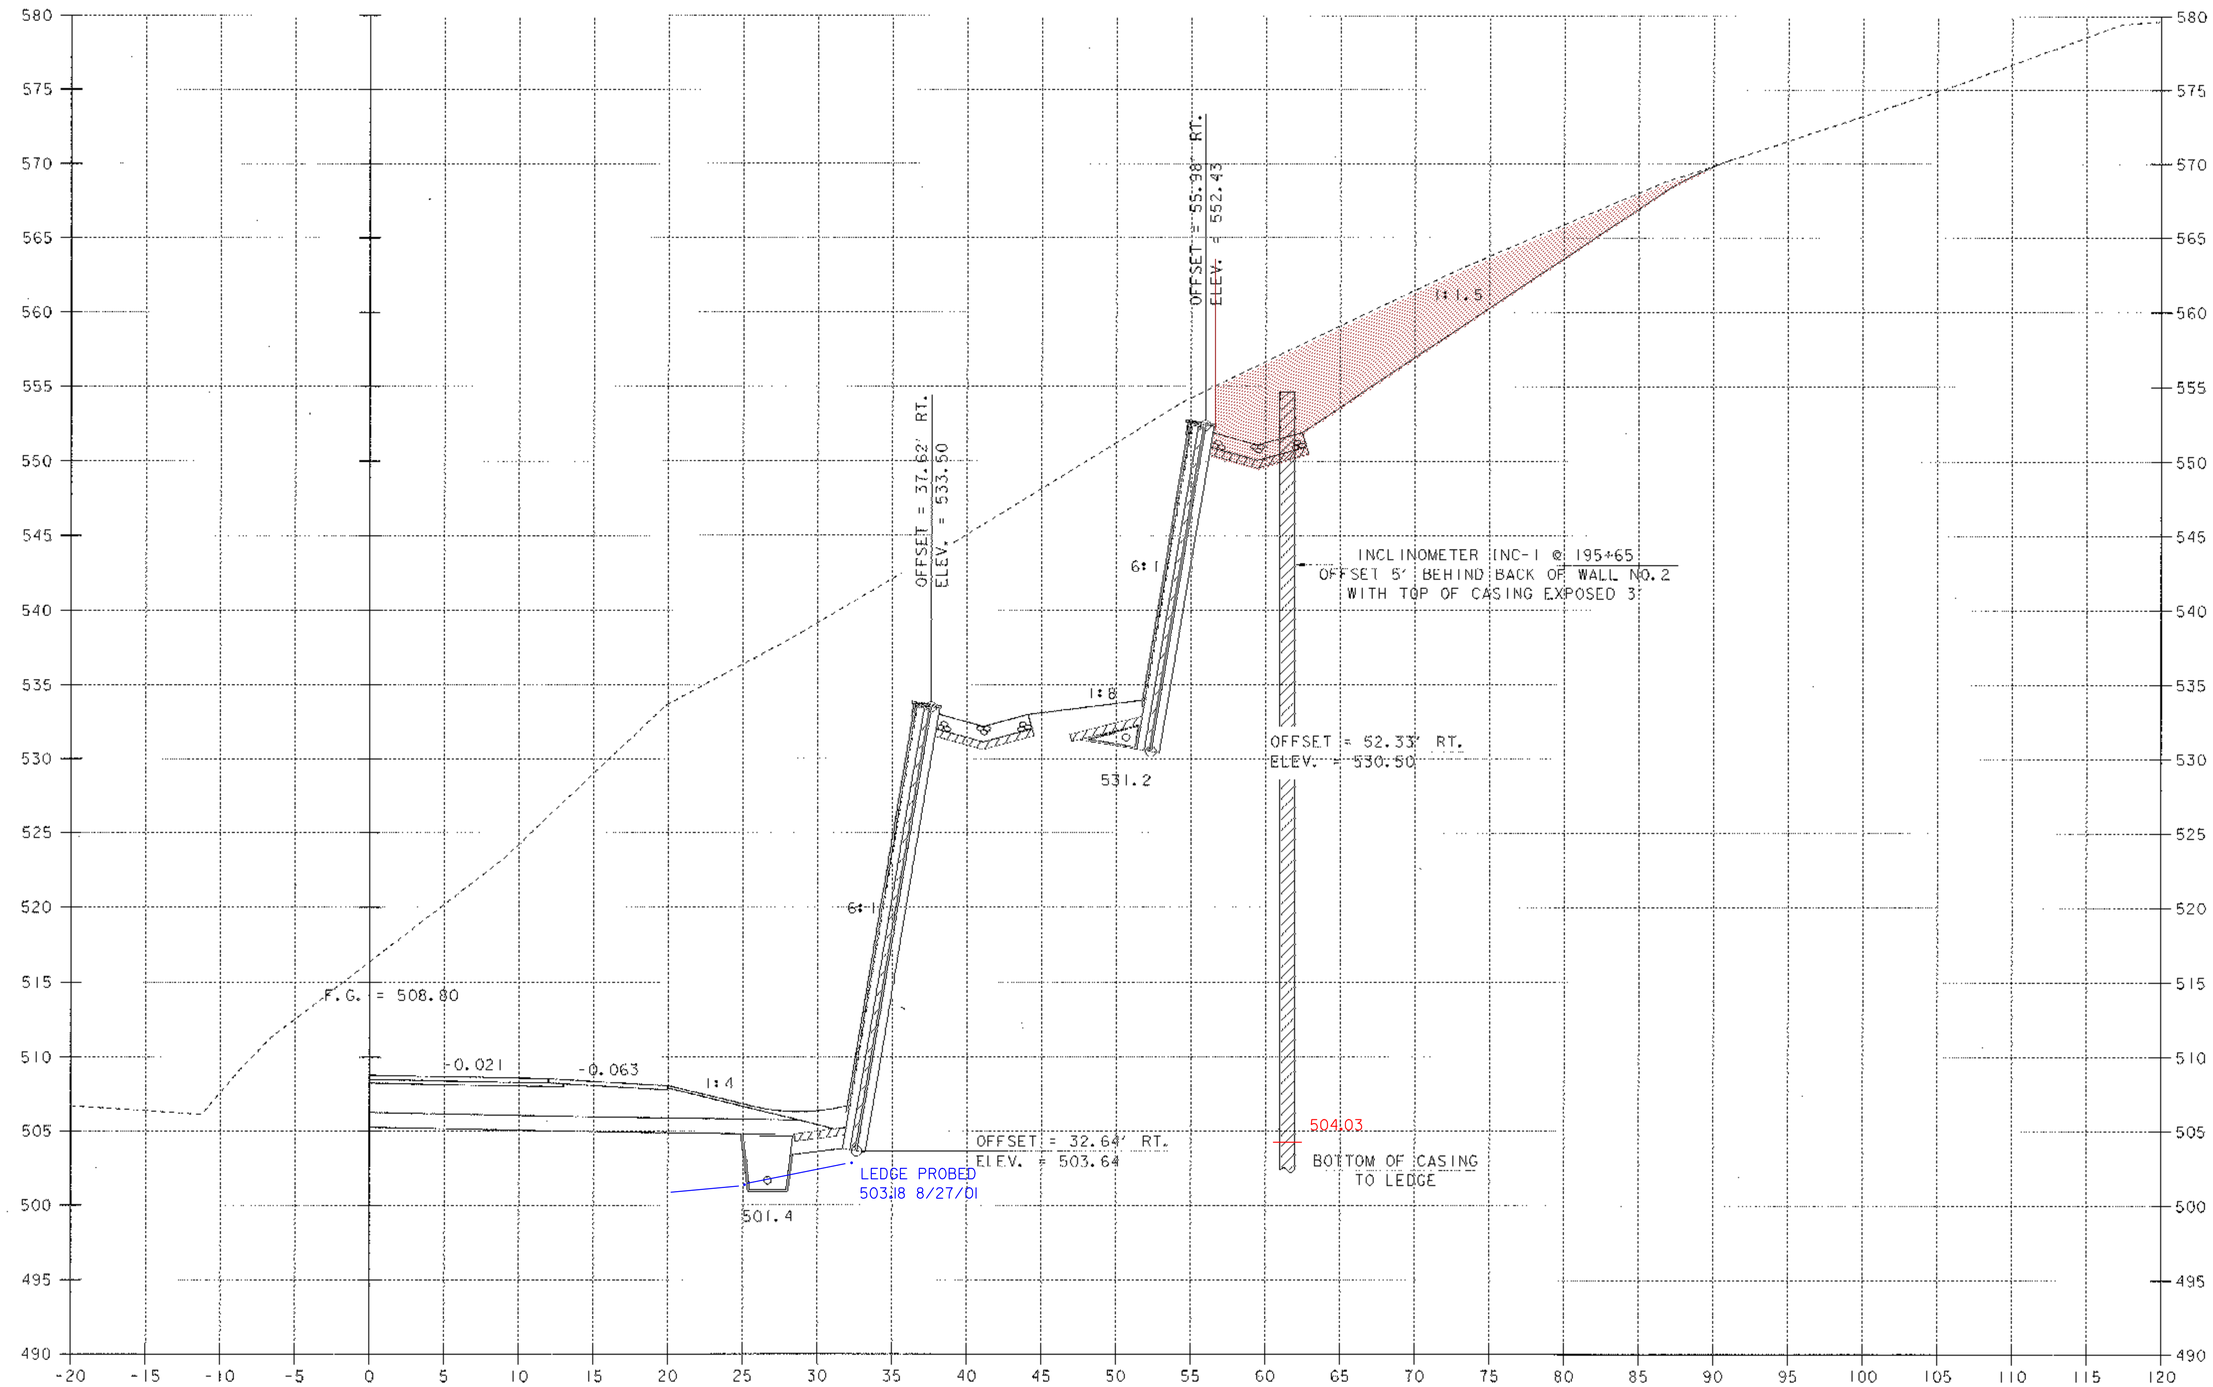

REV. 195+75

SCALE 1" = 5'-0

PROJECT NAME: MORETOWN	
PROJECT NUMBER: STP EGC RSEGC 0167 (9)	
FILE NAME: \78el32\Structures\sel32+10.1	PLOT DATE: 12-MAY-2000
PROJECT LEADER: R. R. WHITCOMB	DRAWN BY: G. ROY
DESIGNED BY: C. ALLEN	CHECKED BY: C. ALLEN
BRIDGE SHEET BR325	SHEET 145J OF 243