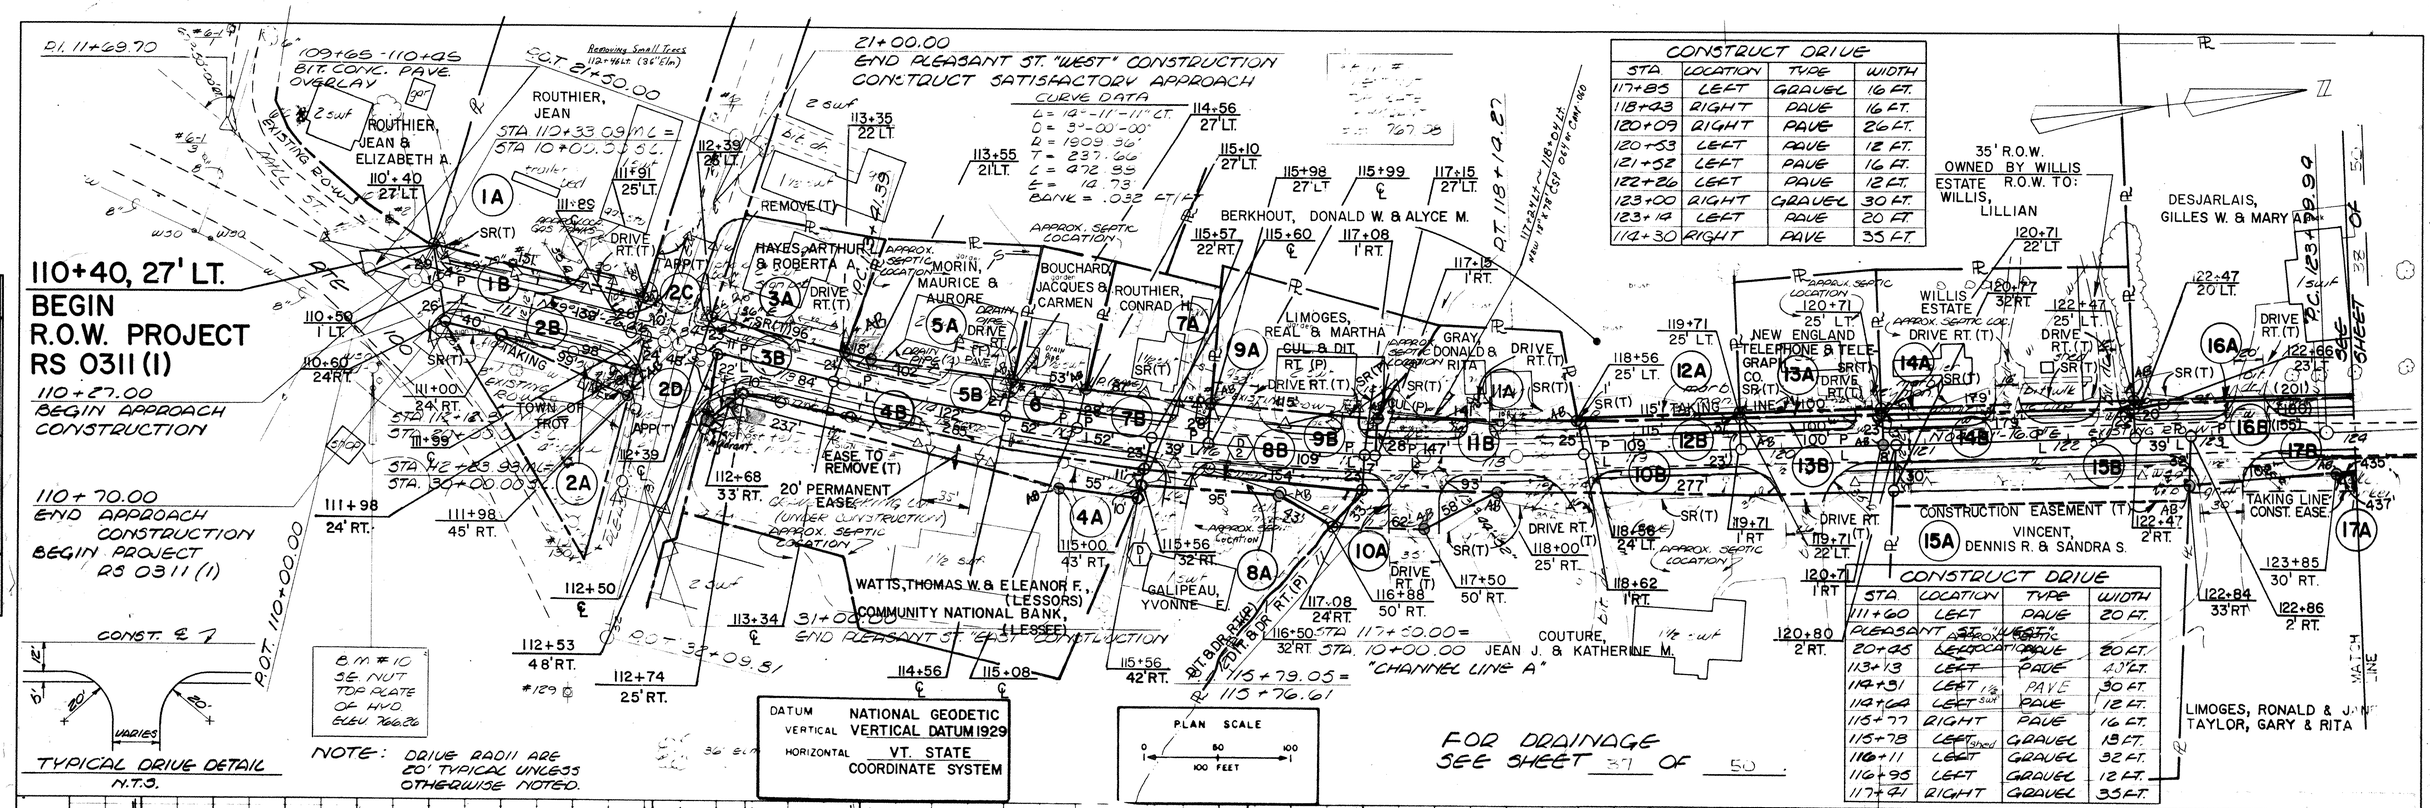

CONSTRUCT DRIVE			
STA	LOCATION	TYPE	WIDTH
117+85	LEFT	GRAVEL	16 FT.
118+23	RIGHT	PAVE	16 FT.
120+09	RIGHT	PAVE	26 FT.
120+53	LEFT	PAVE	12 FT.
121+52	LEFT	PAVE	16 FT.
122+26	LEFT	PAVE	12 FT.
123+00	RIGHT	GRAVEL	30 FT.
123+14	LEFT	PAVE	20 FT.
112+30	RIGHT	PAVE	35 FT.

CONSTRUCT DRIVE			
STA	LOCATION	TYPE	WIDTH
111+60	LEFT	PAVE	20 FT.
PLEASANT ST. "WEST"	APPROX. SEPTIC LOCATION		
20+25	LEFT	PAVE	20 FT.
113+13	LEFT	PAVE	40 FT.
114+31	LEFT	PAVE	30 FT.
114+64	LEFT	PAVE	12 FT.
115+77	RIGHT	PAVE	16 FT.
115+78	LEFT	GRAVEL	18 FT.
116+11	LEFT	GRAVEL	32 FT.
116+95	LEFT	GRAVEL	12 FT.
117+71	RIGHT	GRAVEL	35 FT.