
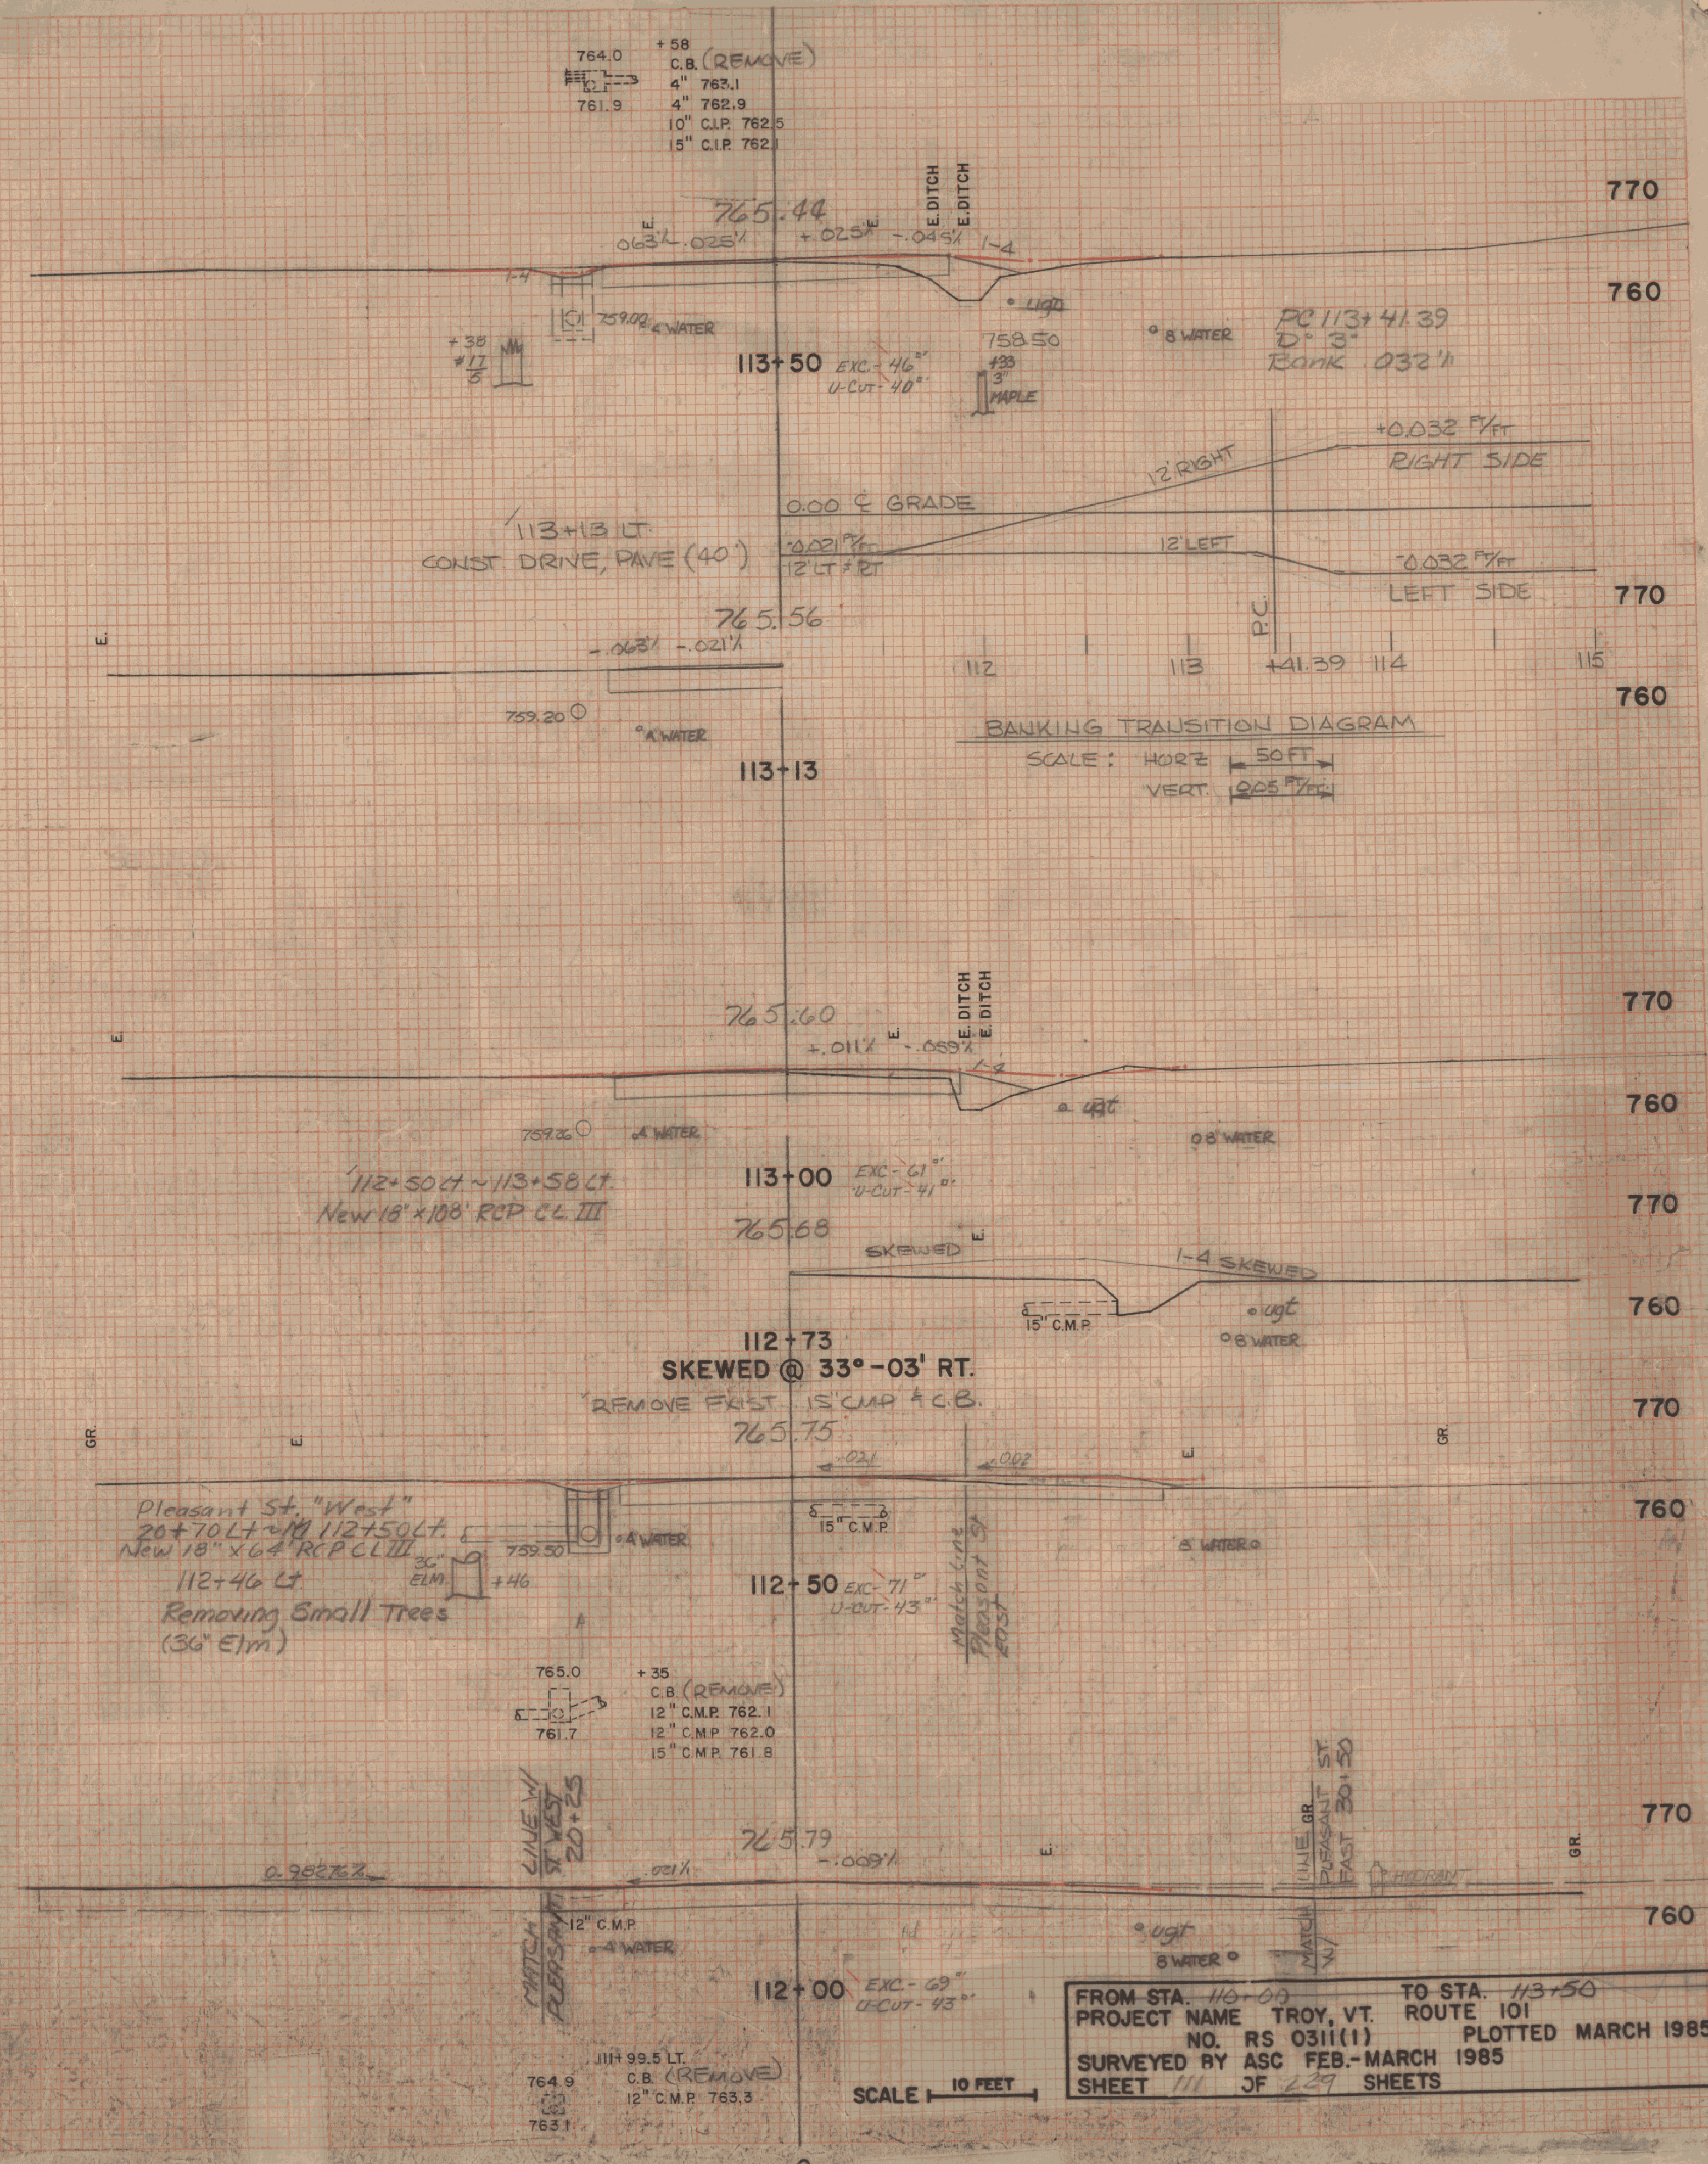


DATE  
BY  
FINAL SURVEY  
CORRECTED  
PLOTTED  
NOTE BOOK  
AREA  
NO.

DATE  
BY  
ORIGINAL SURVEY  
CORRECTED  
PLOTTED  
NOTE BOOK  
AREA  
NO.

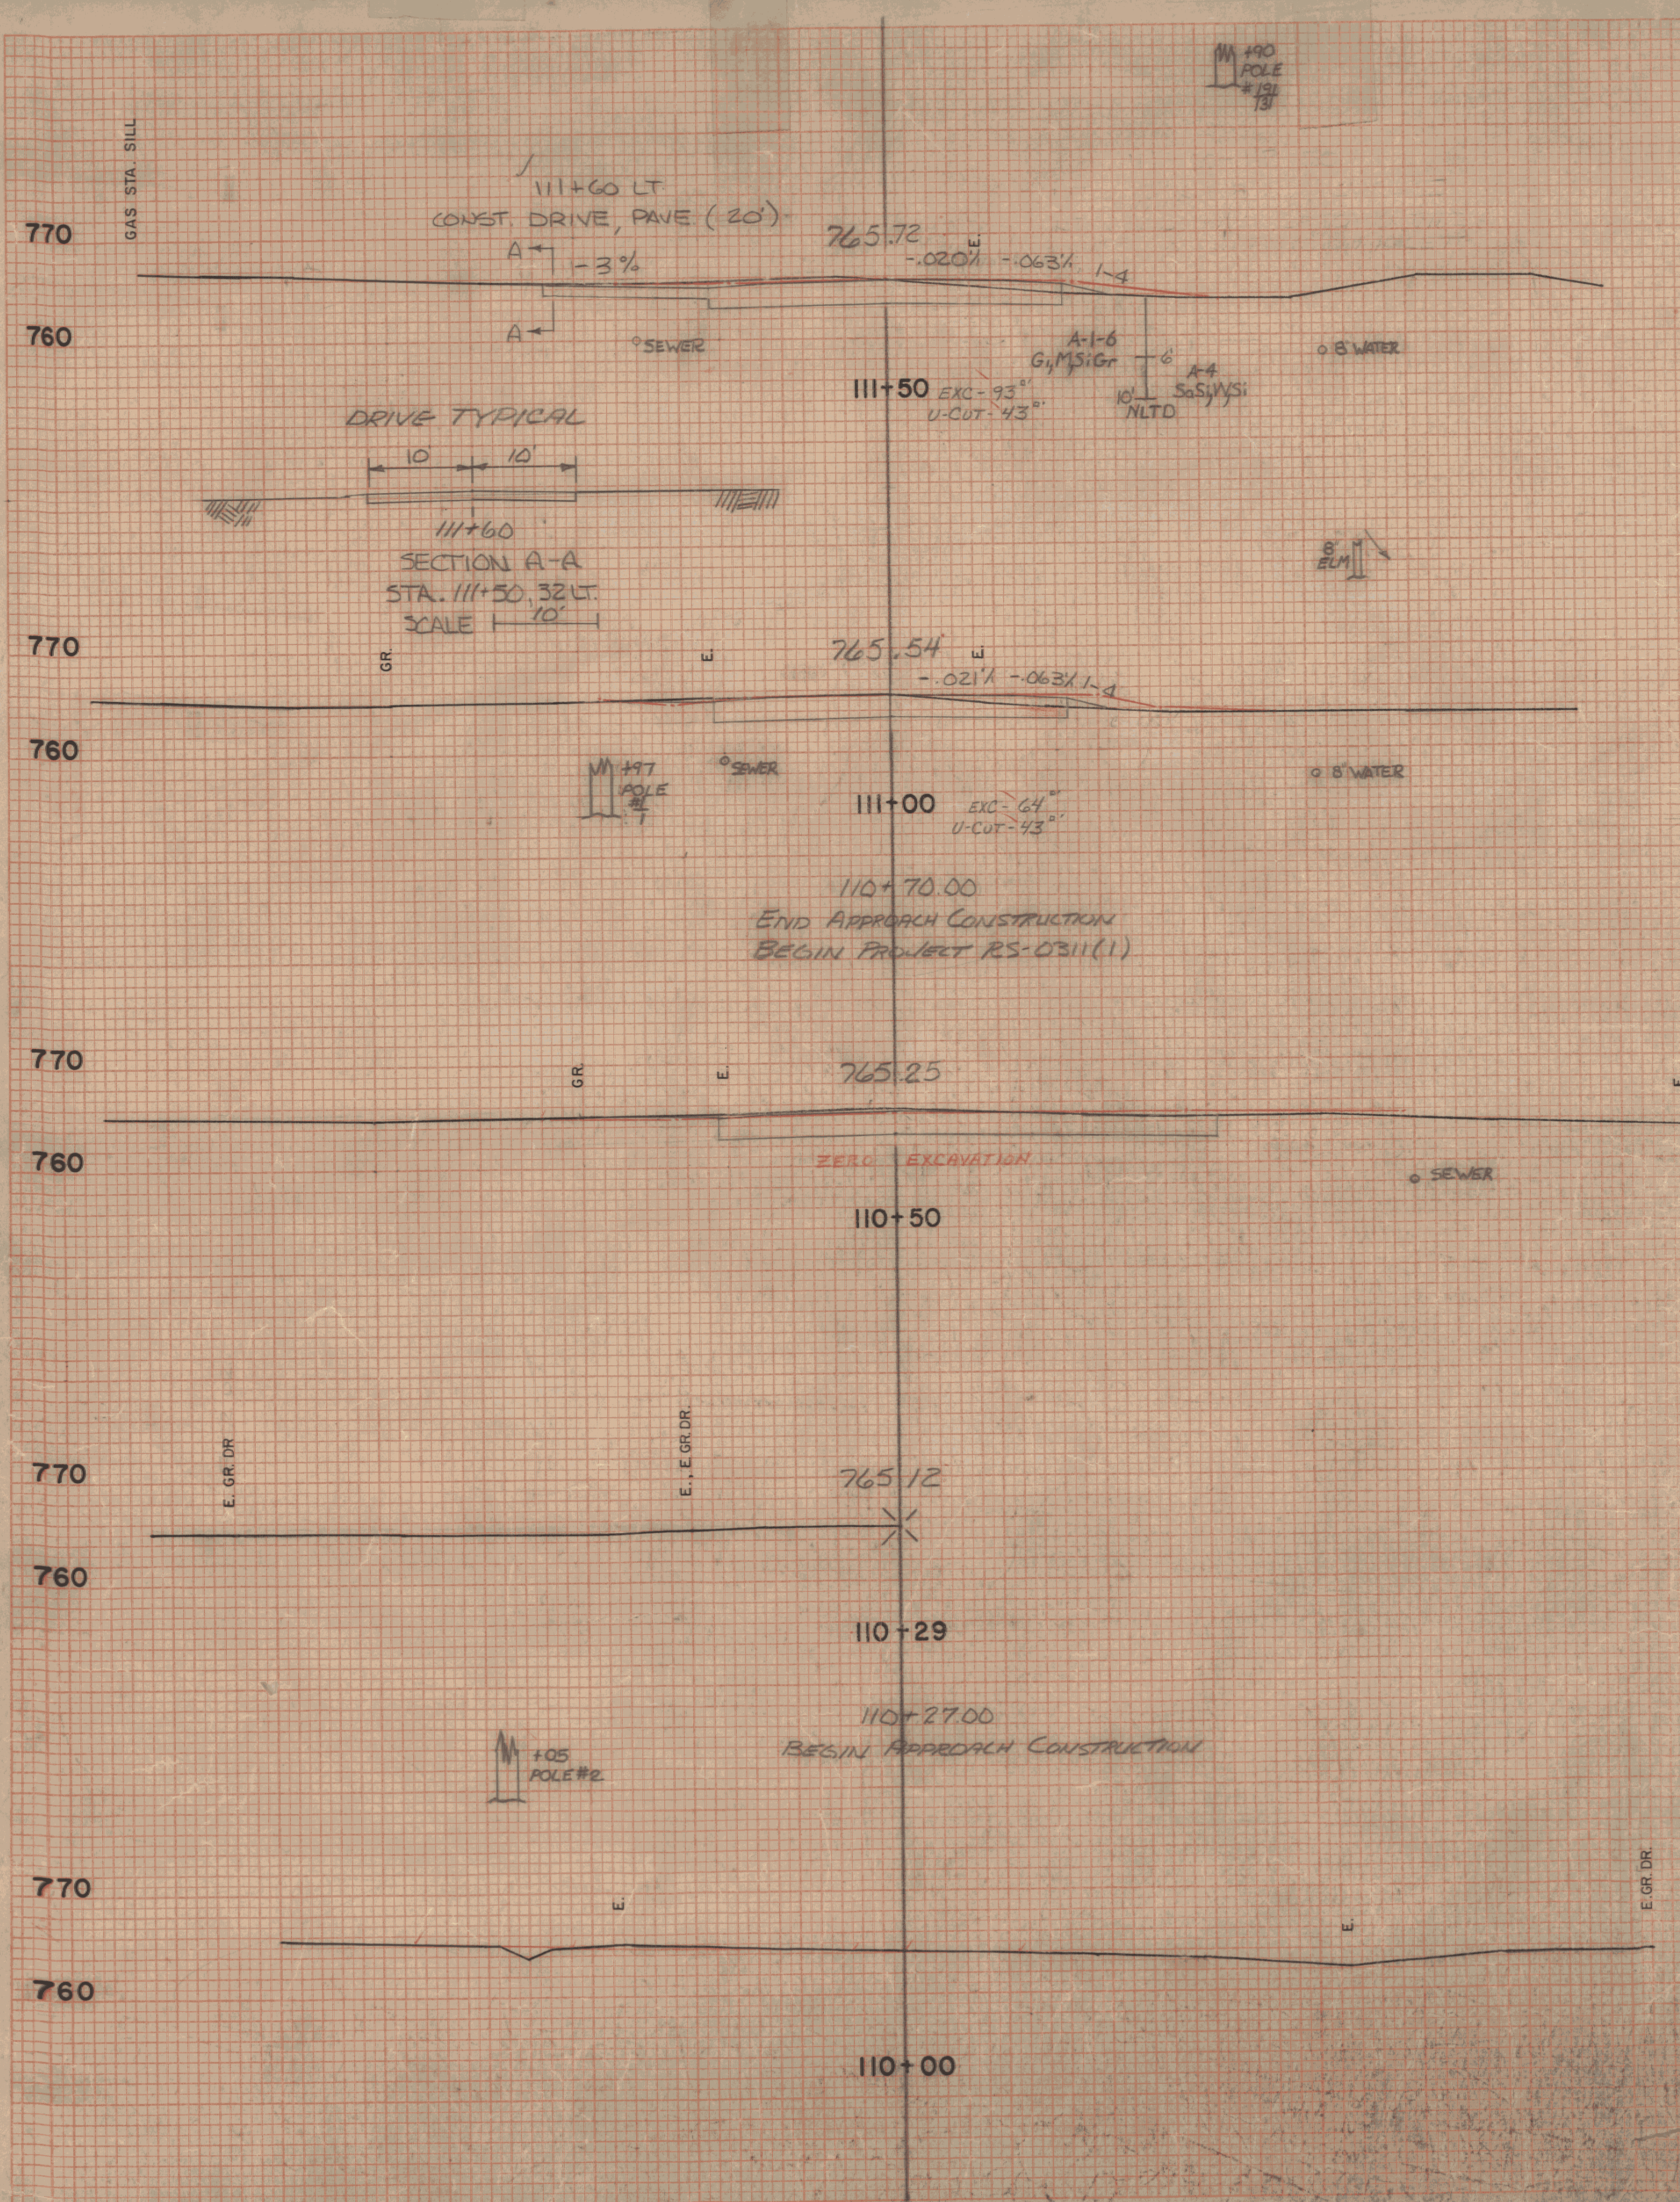

FROM STA. 110+00 TO STA. 113+50  
PROJECT NAME TROY, VT. ROUTE 101  
NO. RS 0311(1) PLOTTED MARCH 1985  
SURVEYED BY ASC FEB.-MARCH 1985  
SHEET 111 JF 129 SHEETS

SCALE 10 FEET

Plotted 11-25-91 by JEM  
Planimetered 1-7-92 JEM  
Plot 1-17-92 JEM