


ORIGINAL SURVEY	SURVIVED	BY	DATE
NOTE BOOK	FLOTTED		
	TEMPLATE		
	AREAS		
	APPEAR CHECKED		

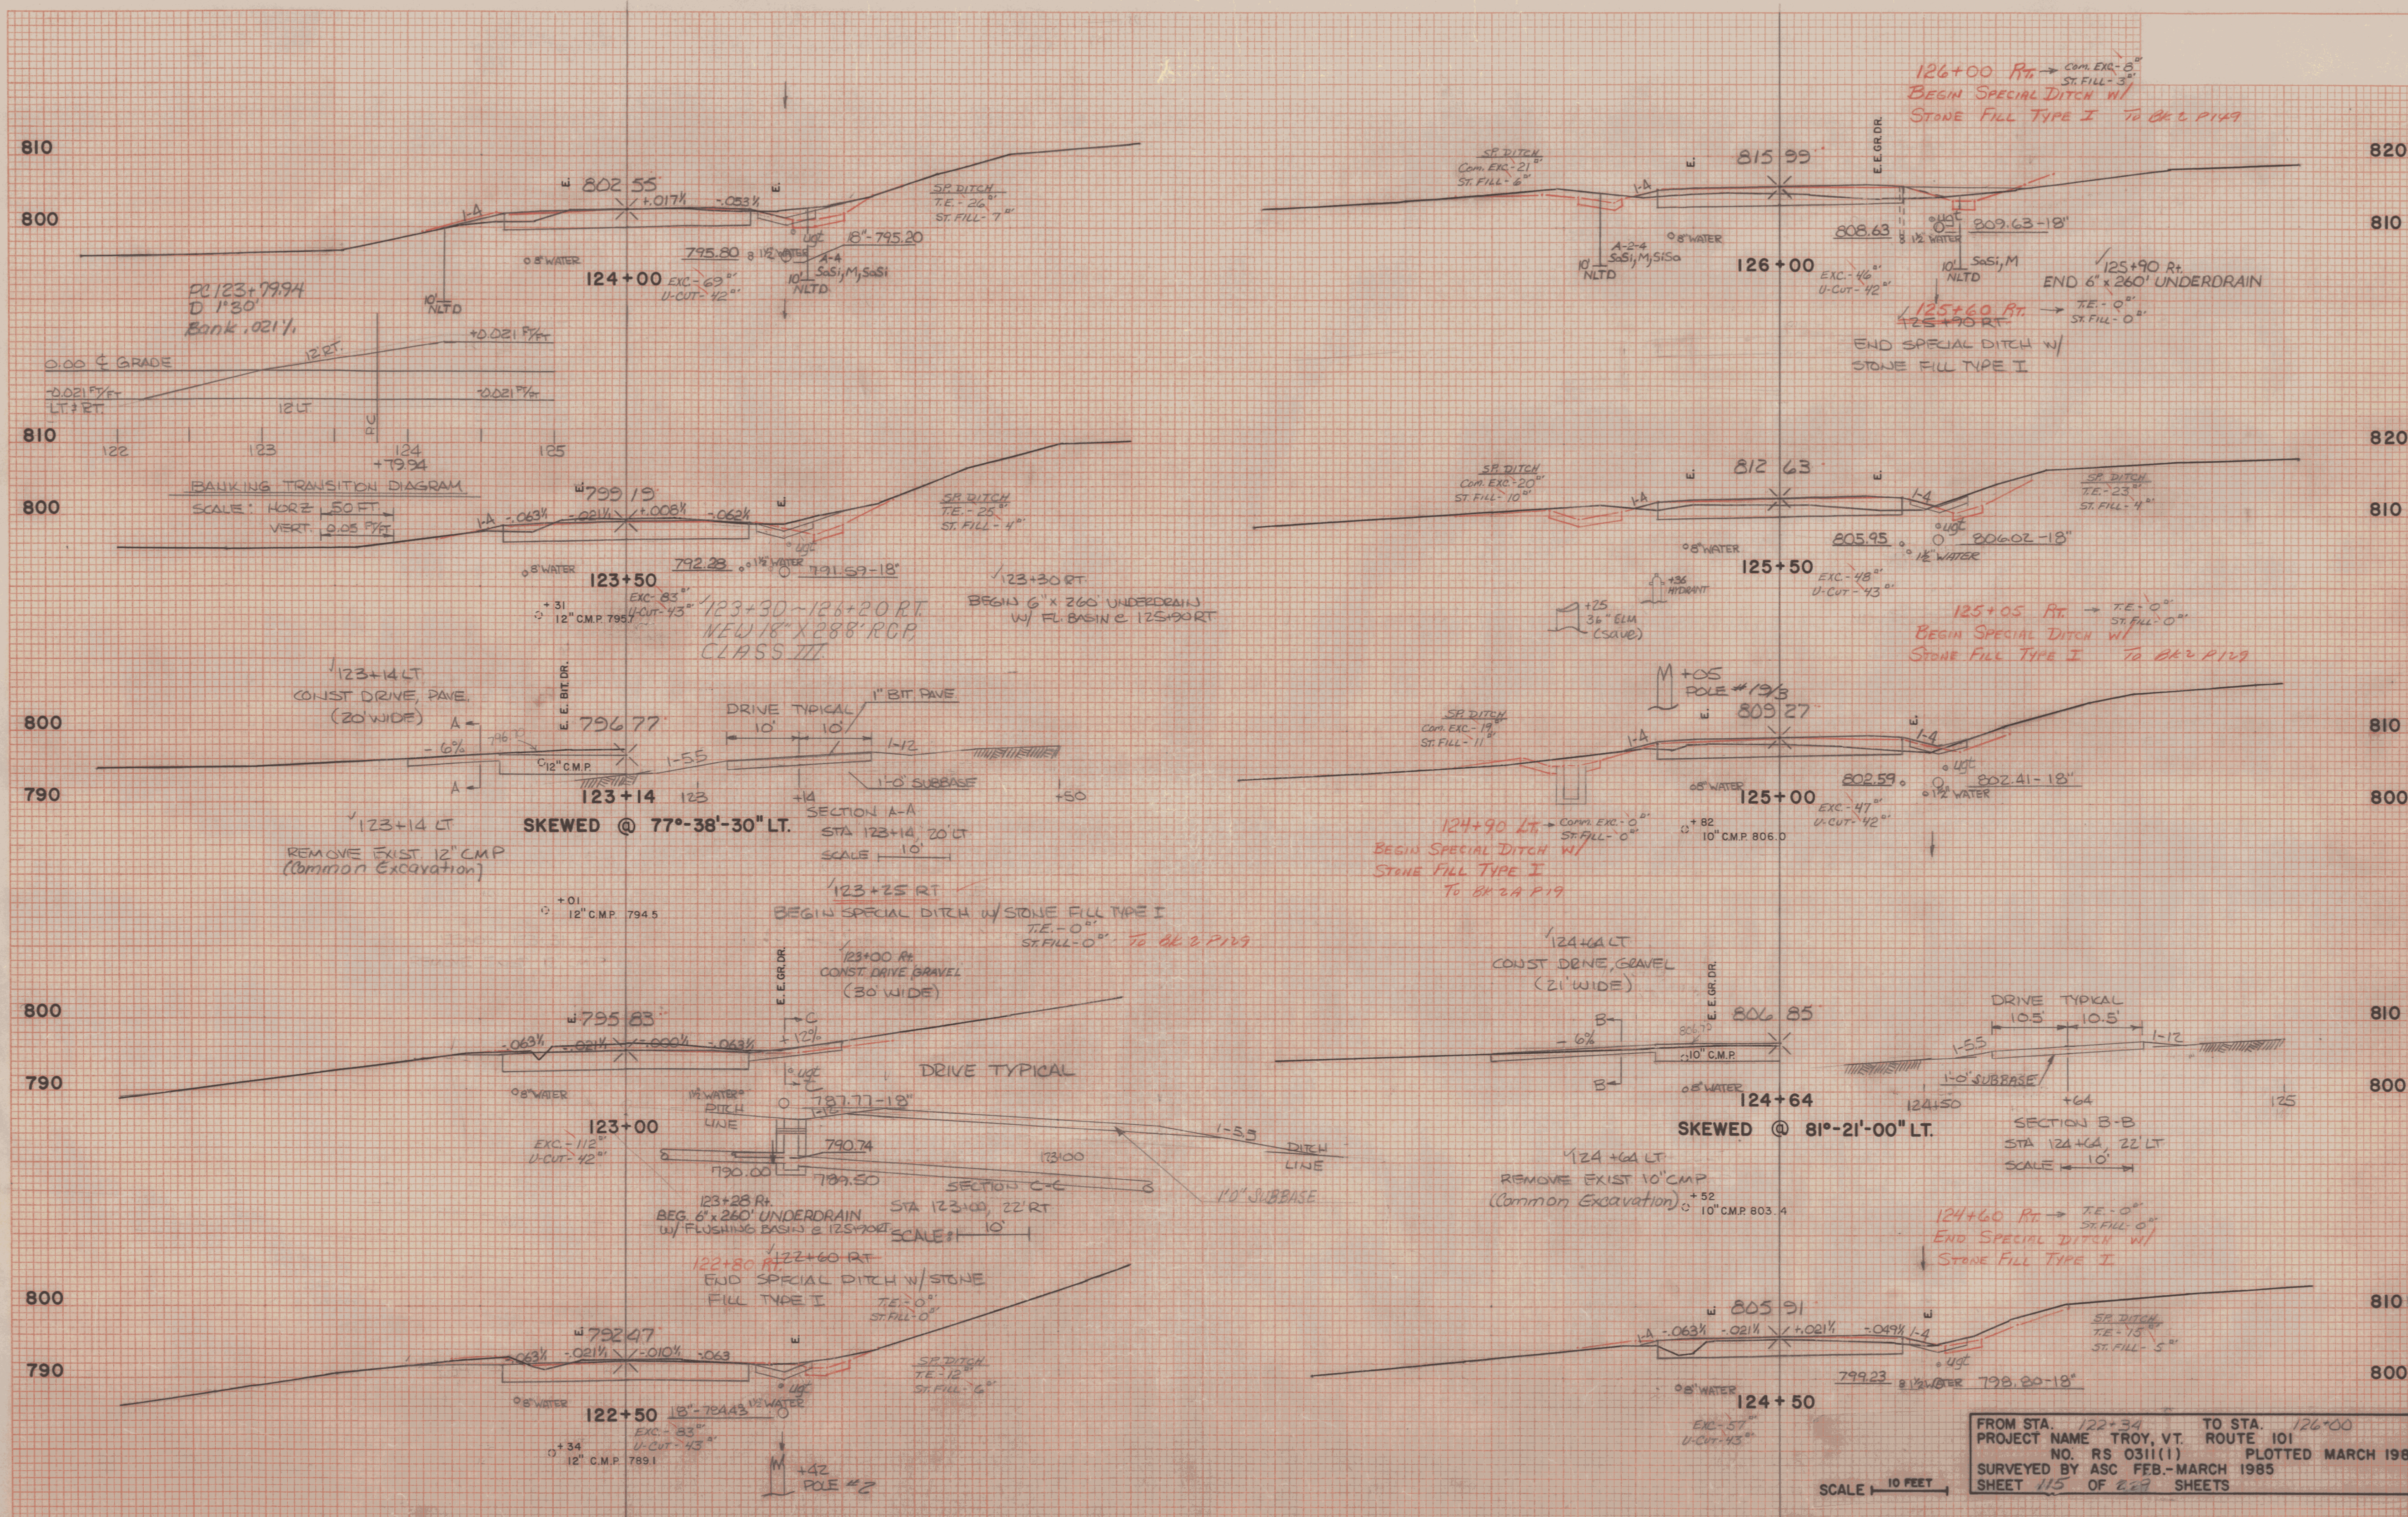

FROM STA. 122+34 TO STA. 126+00
PROJECT NAME TROY, VT. ROUTE 101
NO. RS 0311(1) PLOTTED MARCH 1985
SURVEYED BY ASC FEB.-MARCH 1985
SHEET 115 OF 229 SHEETS

SCALE 10 FEET

PLOTTED 11-26-91 *LEPM* Plan-1-17-52 *ALPS*
 PLANIMETERED 1-7-92 *J.M.*