


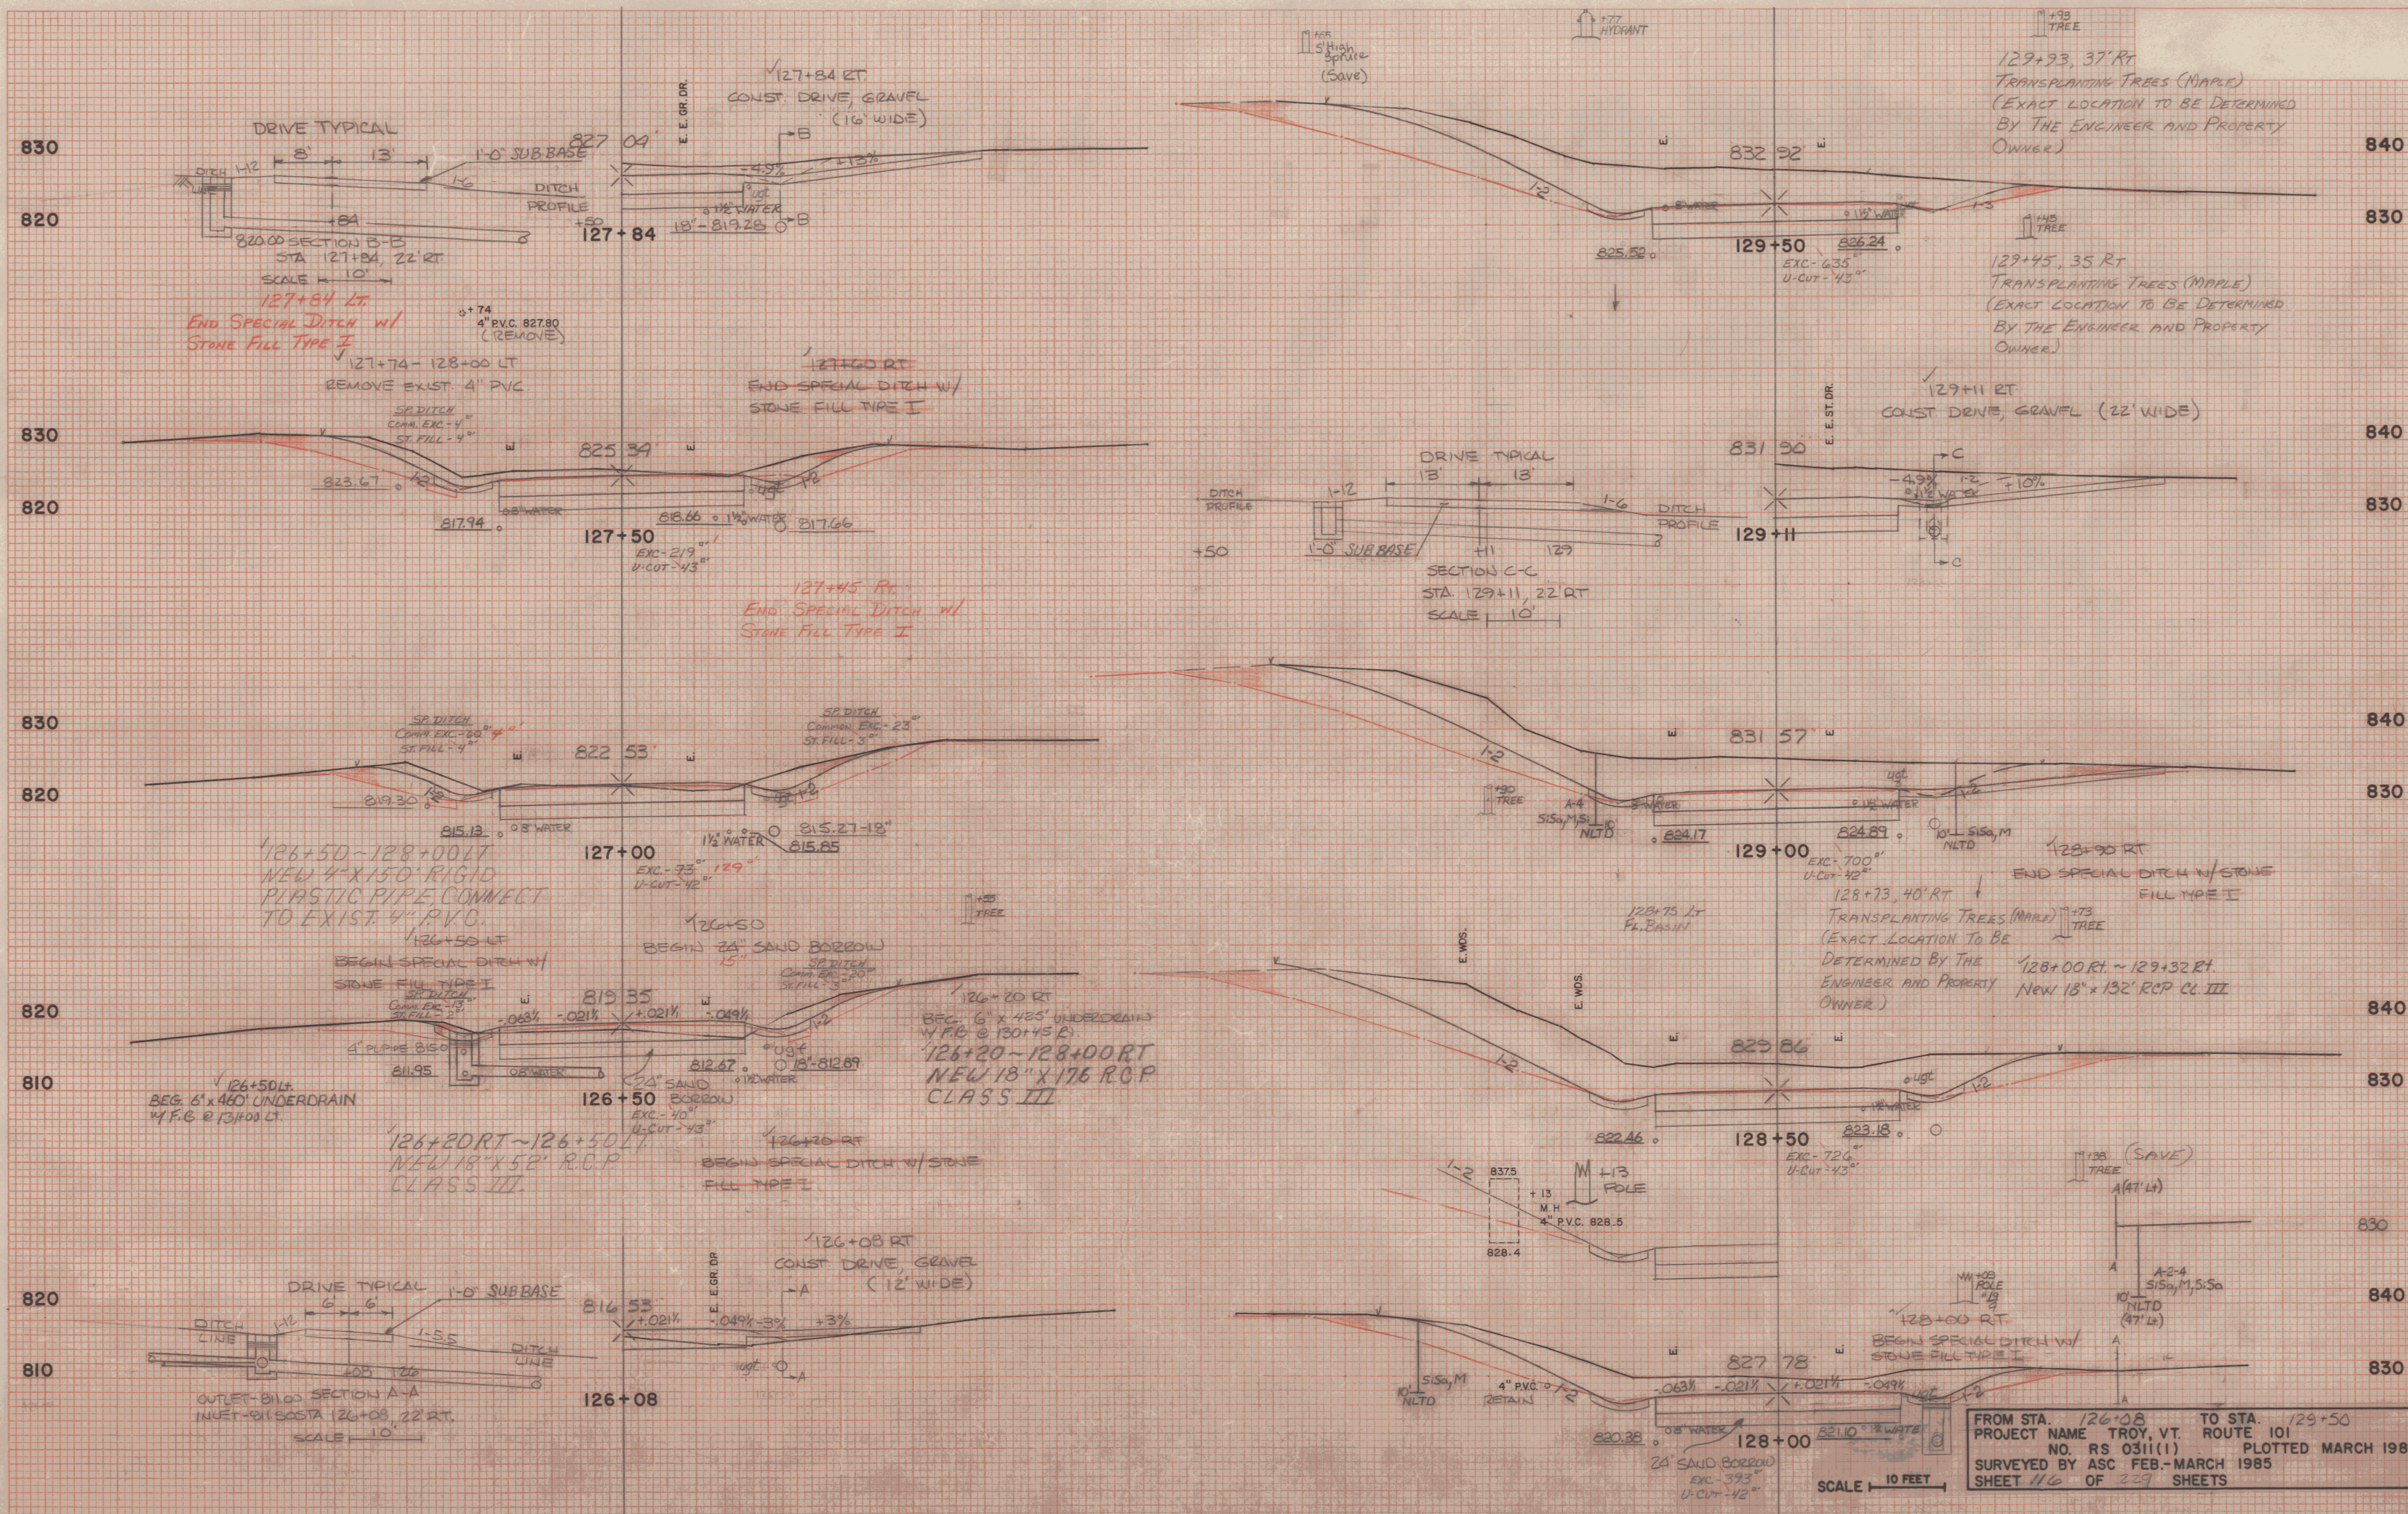

Bugged By TUB 12/85