
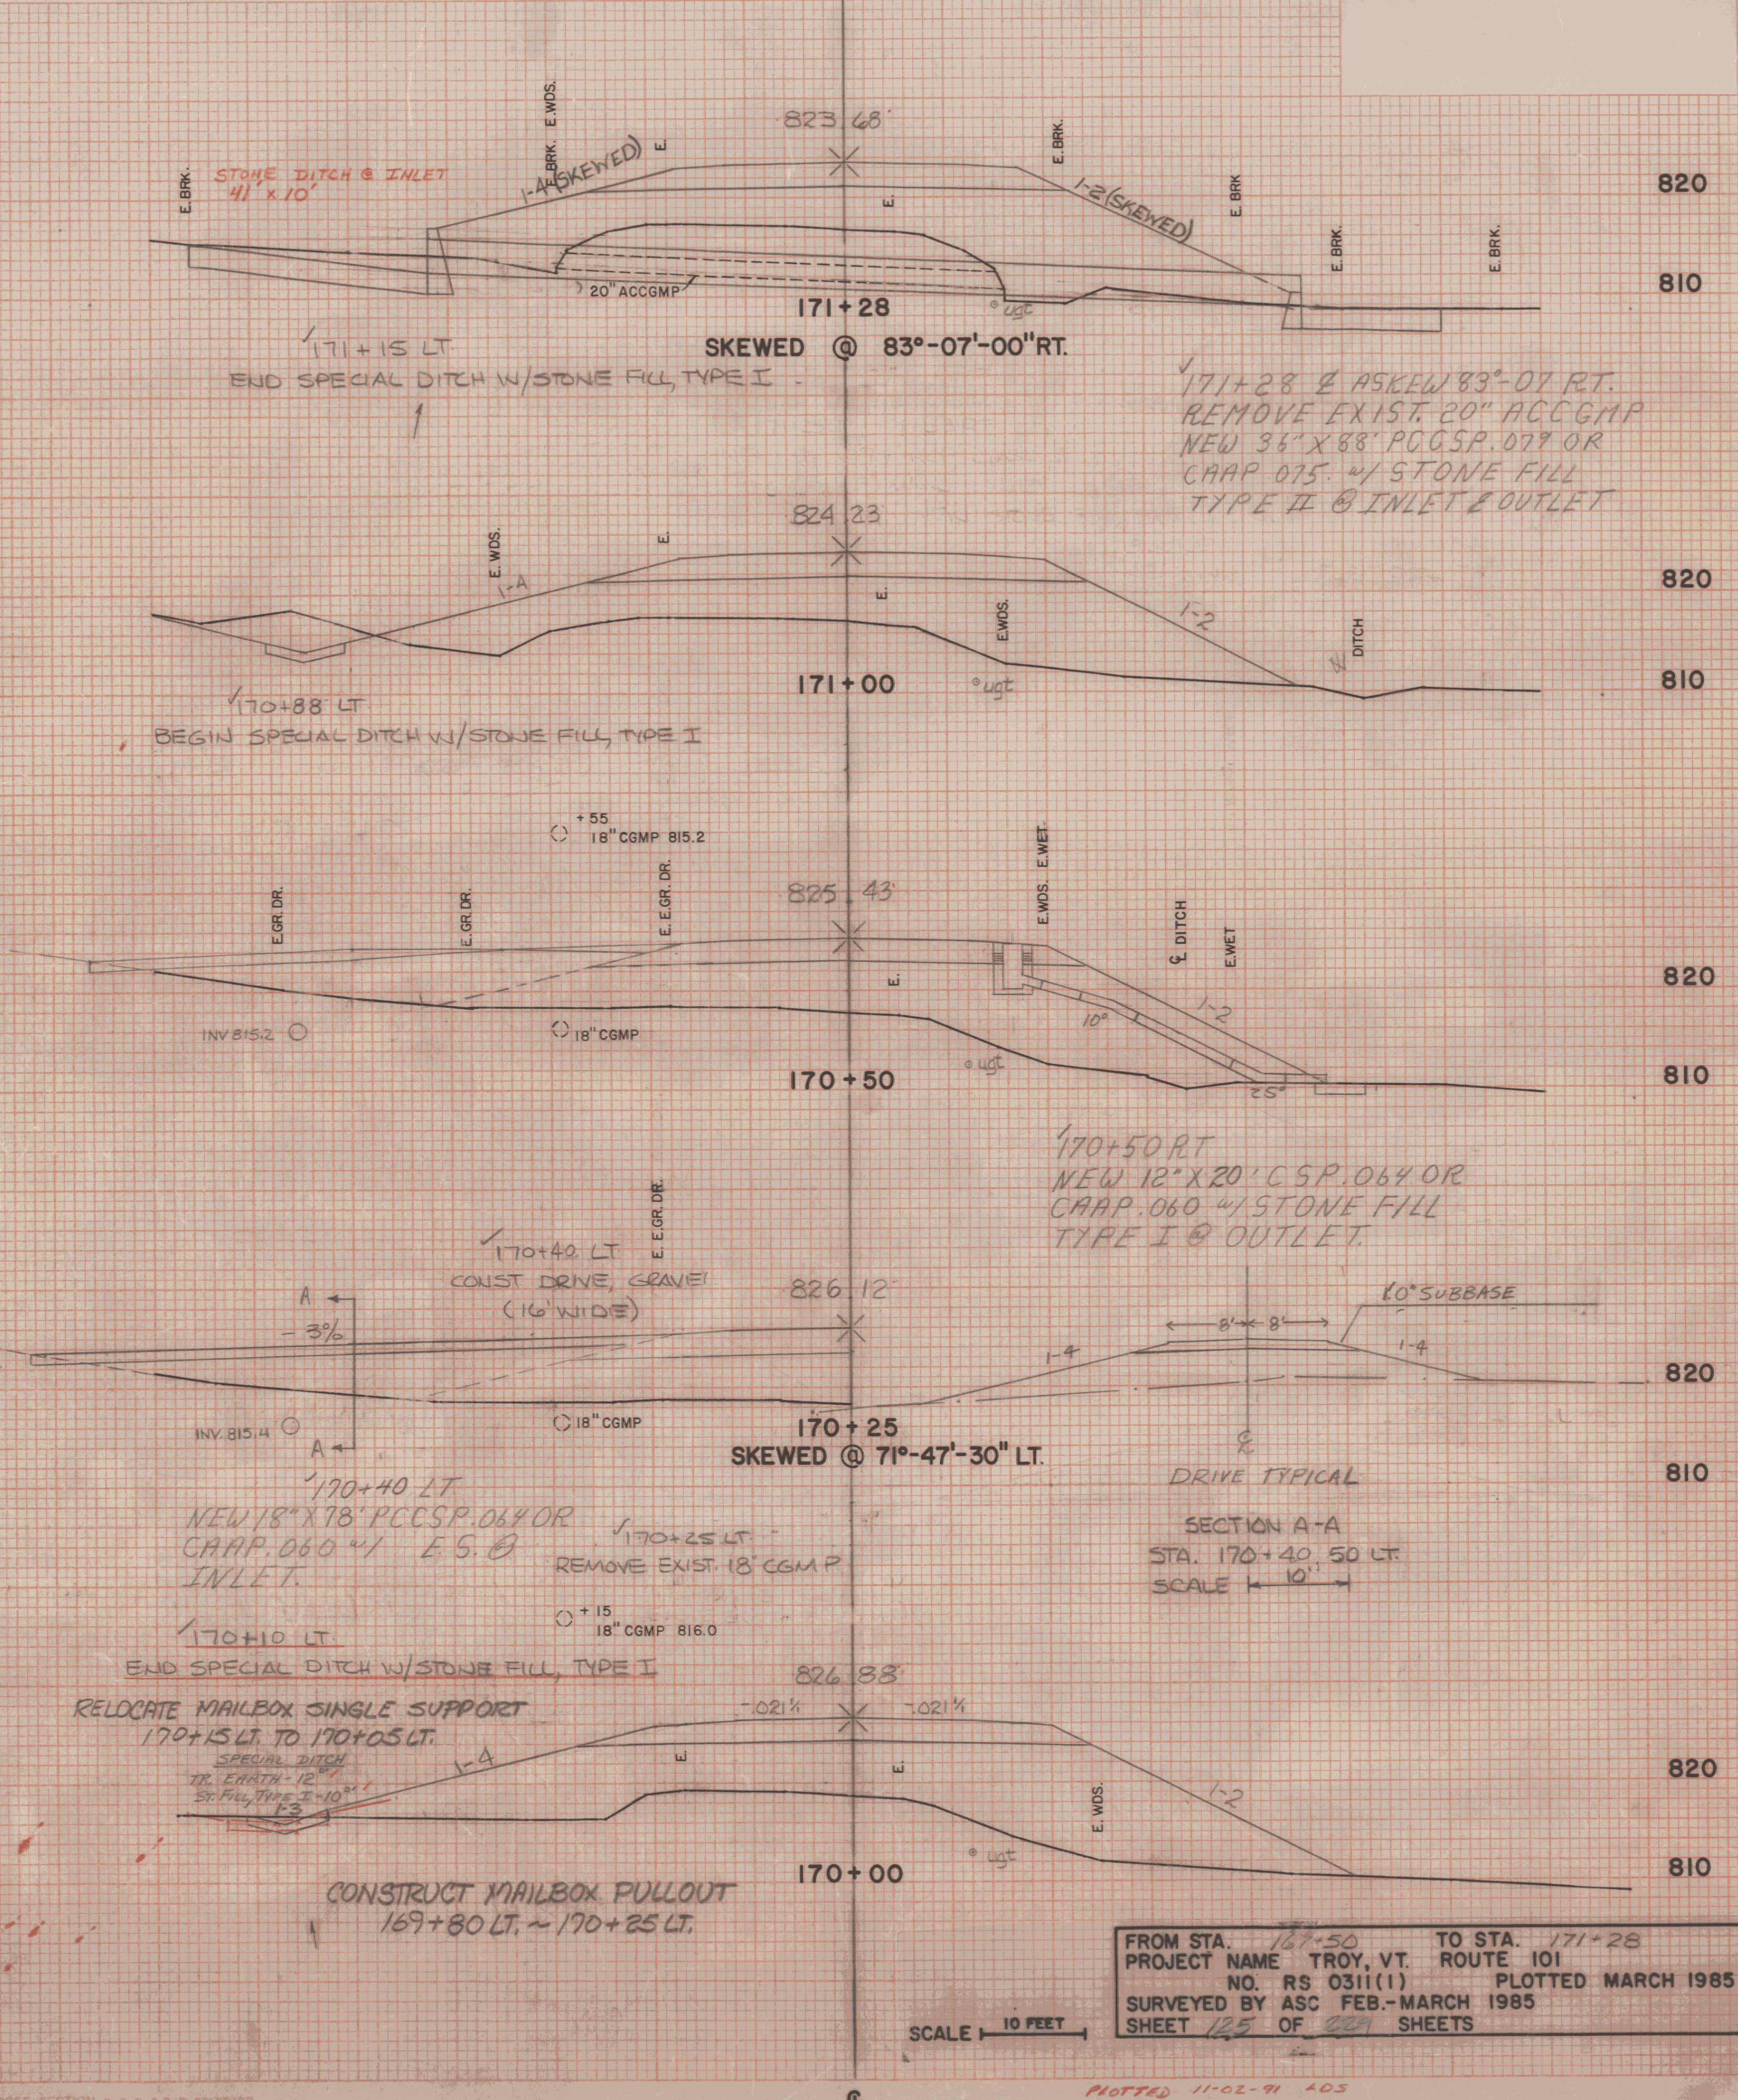


DATE _____ BY _____
 SURVIVED _____
 ORIGINAL SURVEY PLOTTED _____
 NOTE BOOK _____
 AREA CHECKED _____
 NO. _____

DATE _____ BY _____
 SURVIVED _____
 ORIGINAL SURVEY PLOTTED _____
 NOTE BOOK _____
 AREA CHECKED _____
 NO. _____

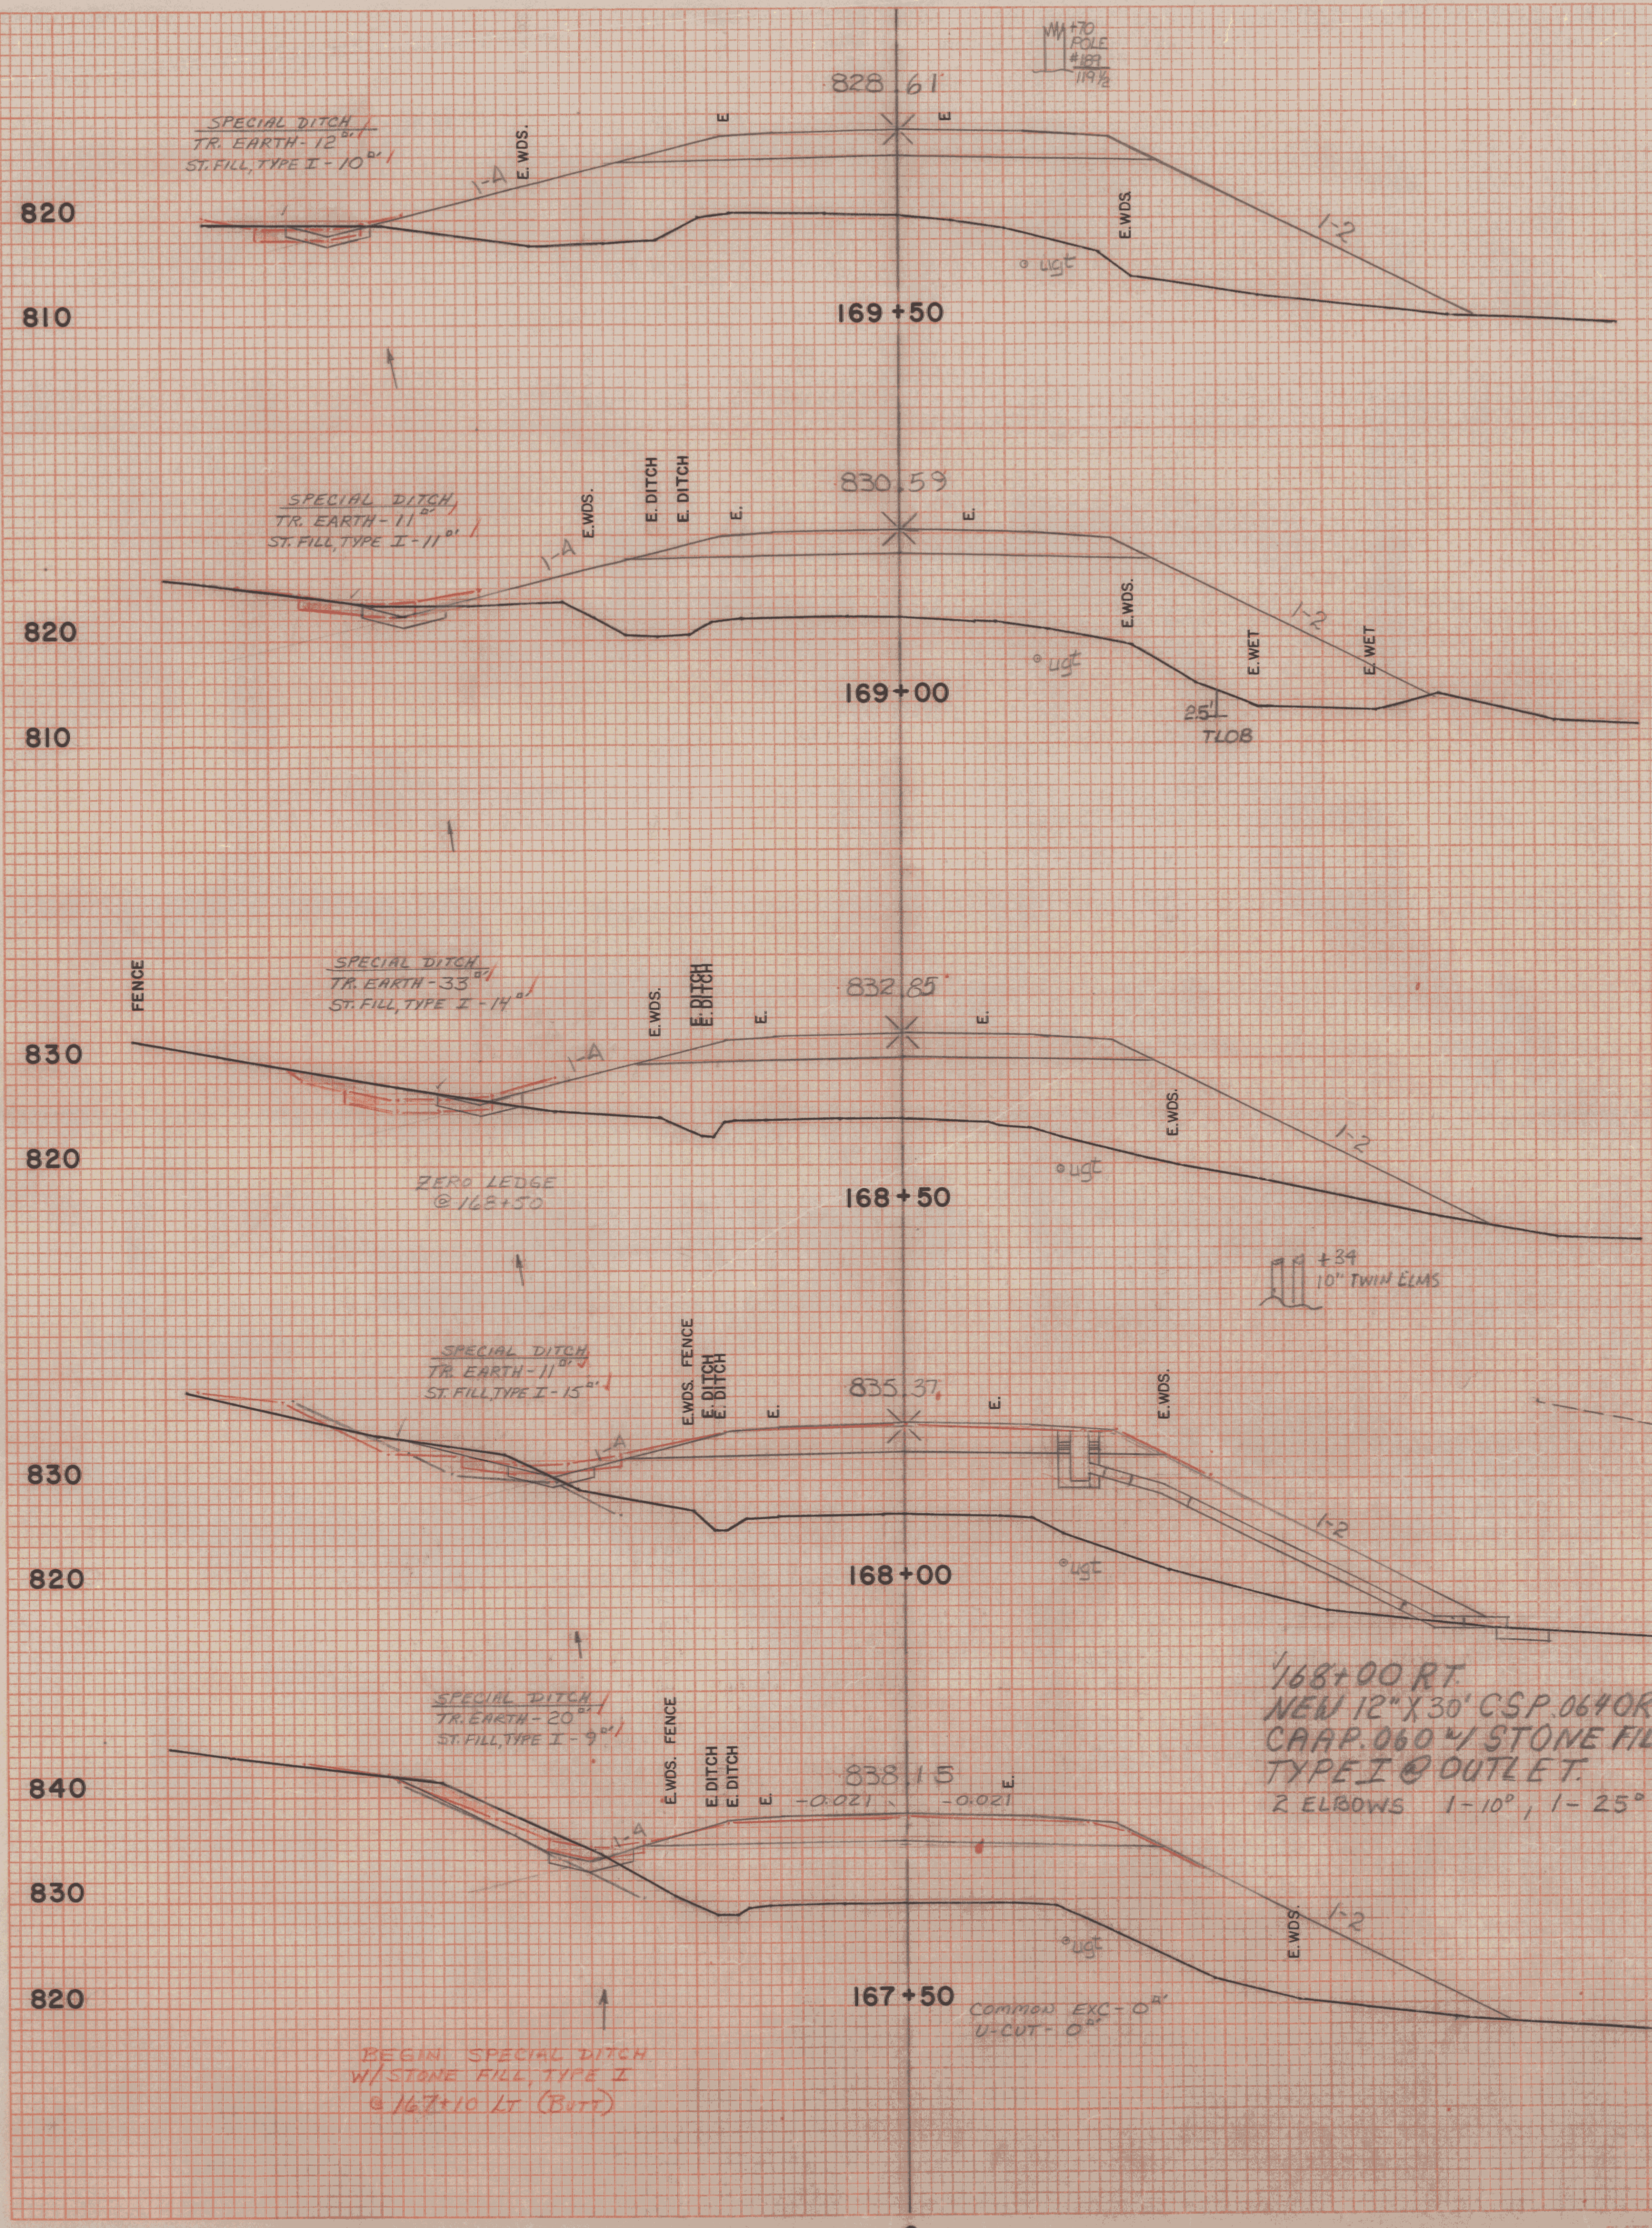

168+00 RT.
 NEW 12" X 30' CSP. 064 OR
 CAPP. 060 w/ STONE FILL
 TYPE I @ OUTLET.
 2 ELBOWS 1-10°, 1-25°

 CAPP. 060 w/ E.S. @
 INLET.

170+50 RT.
 NEW 12" X 20' CSP. 064 OR
 CAPP. 060 w/ STONE FILL
 TYPE I @ OUTLET.

FROM STA. 167+50 TO STA. 171+28
 PROJECT NAME TROY, VT. ROUTE 101
 NO. RS 0311(1) PLOTTED MARCH 1985
 SURVEYED BY ASC FEB.-MARCH 1985
 SHEET 125 OF 225 SHEETS

SCALE 10 FEET

NOTED 11-02-91 ADS
 REVISIONS 1-14-92 RCM
 1-28-92 CTM