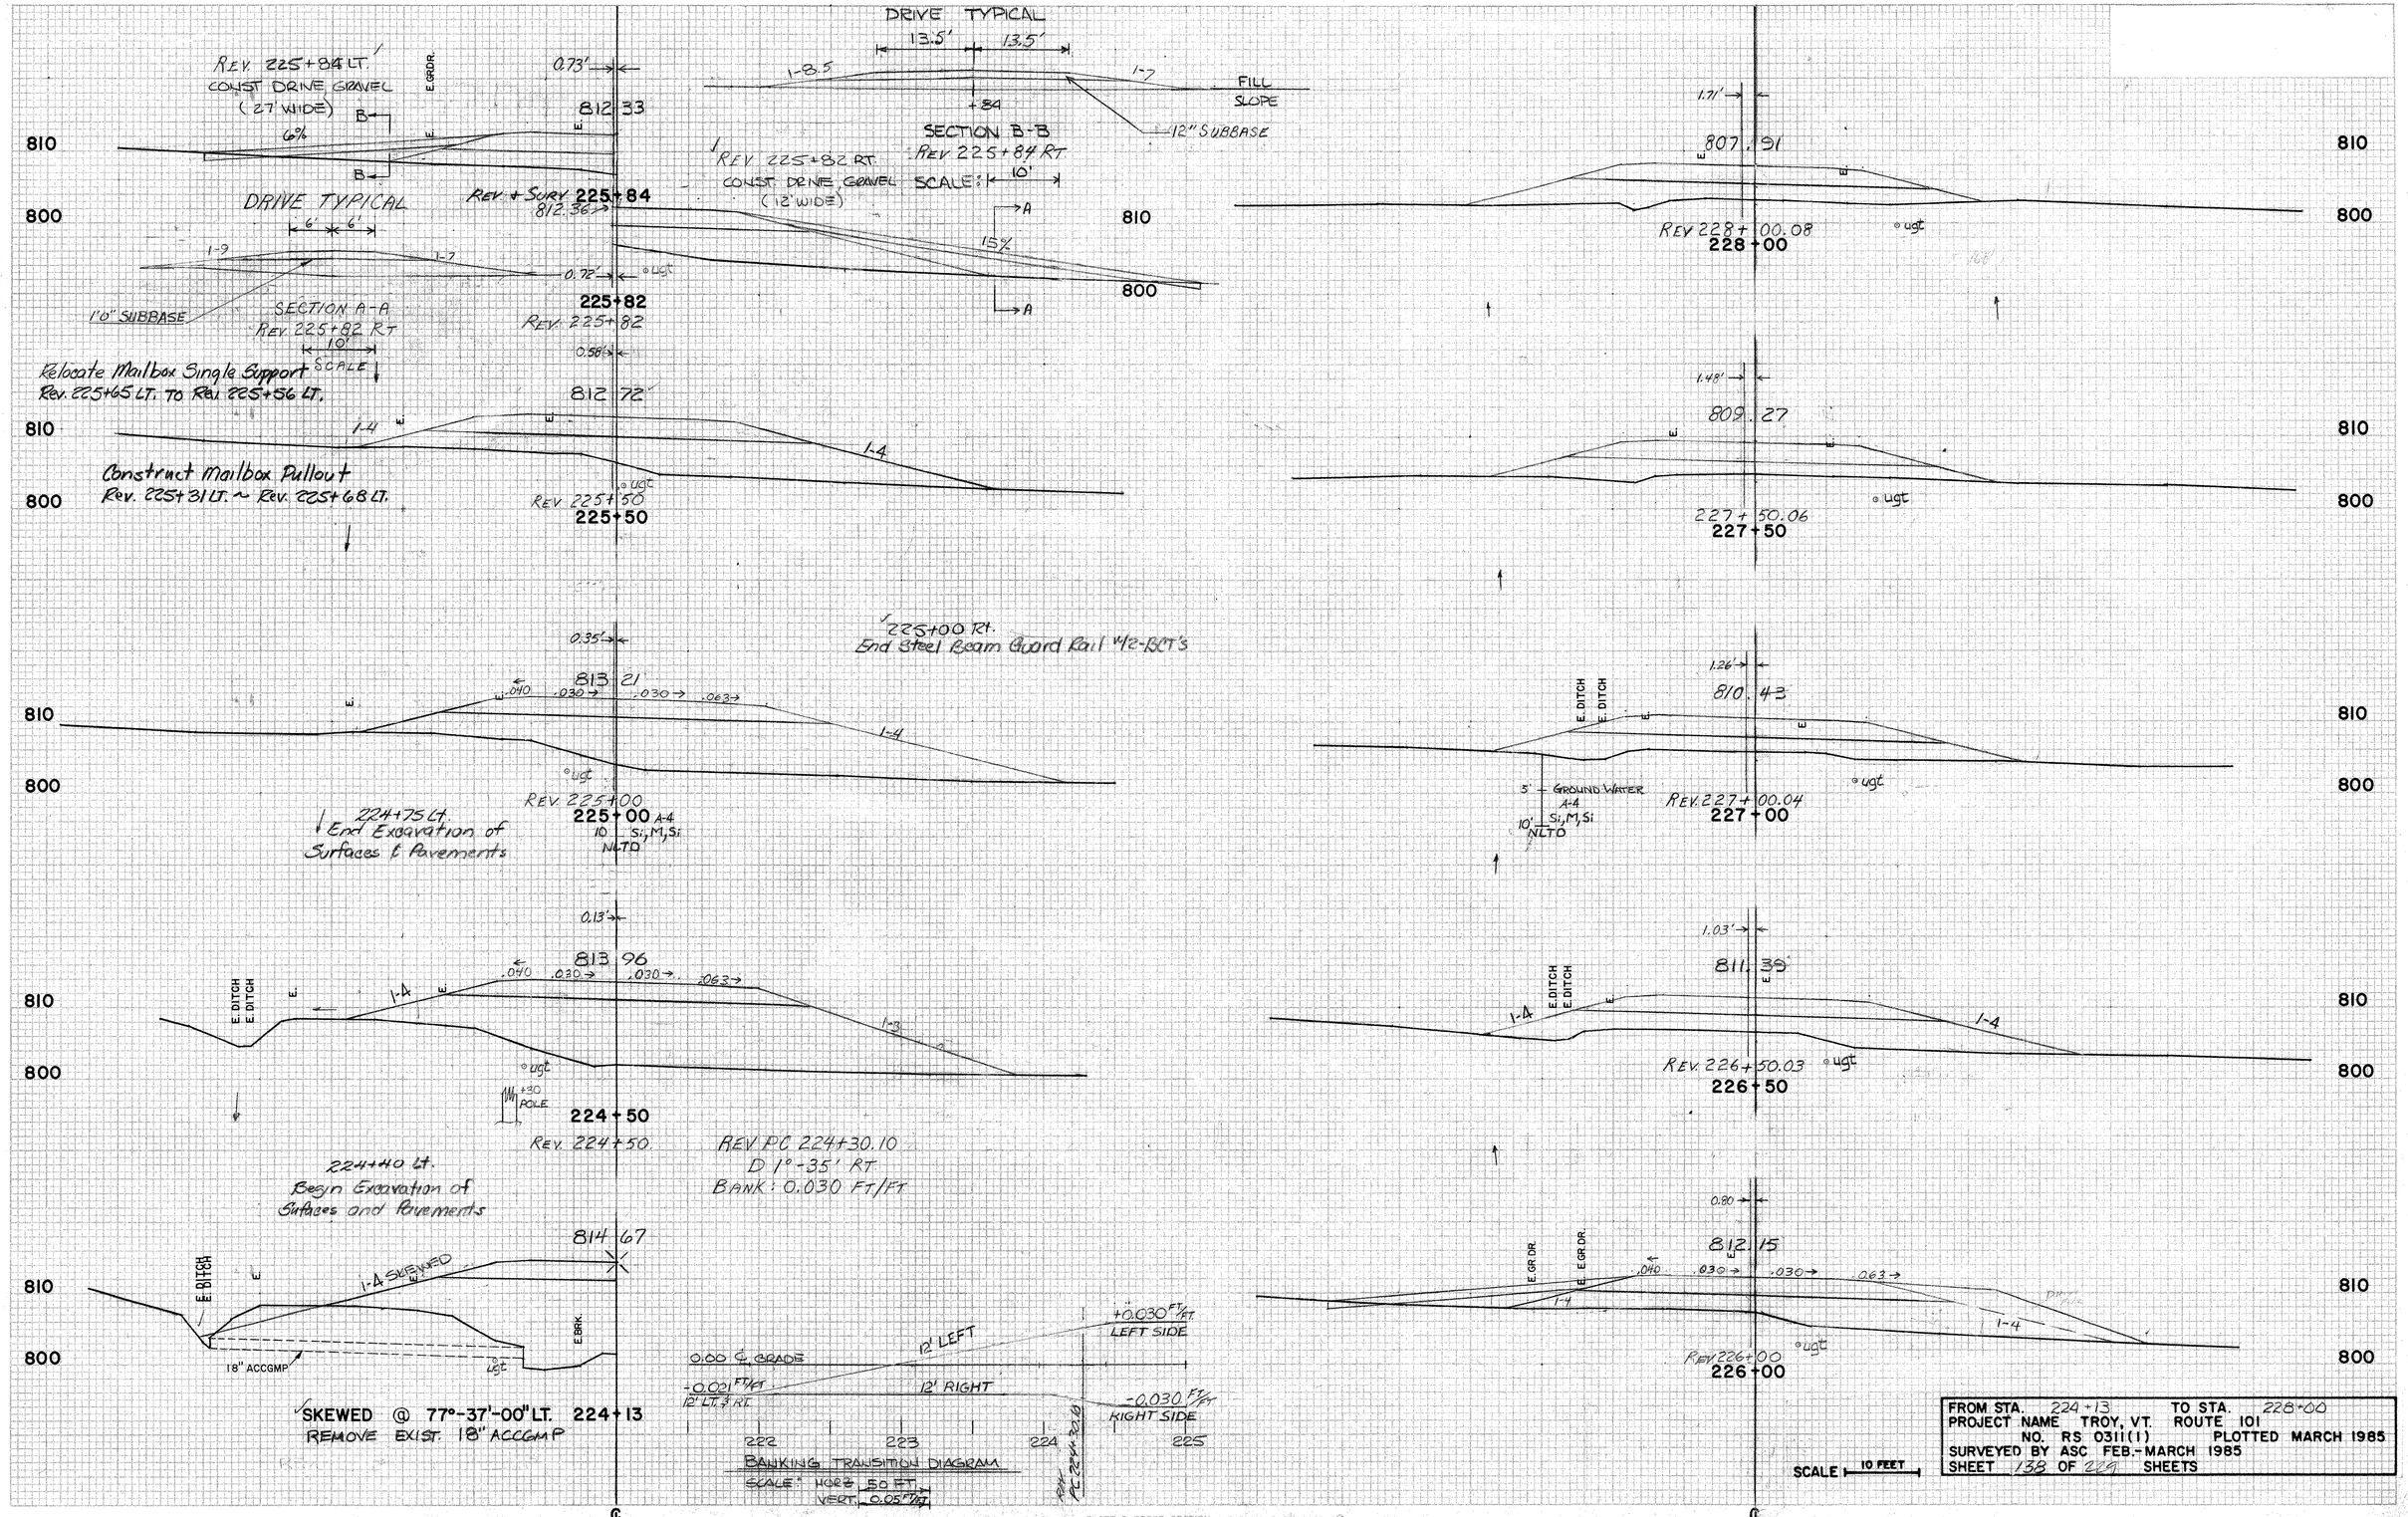

FROM STA. 224+13	TO STA. 228+00
PROJECT NAME TROY, VT.	ROUTE 101
NO. RS 0311(1)	PLOTTED MARCH 1985
SURVEYED BY ASC FEB.-MARCH 1985	
SHEET 138 OF 229	SHEETS

FINAL SURVEY — SURVEYED, PLOTTED, PROFILE, AREAS, AREAS CHECKED — NOTE BOOK NO. — BY — DATE

ORIGINAL SURVEY — SURVEYED, PLOTTED, PROFILE, AREAS, AREAS CHECKED — NOTE BOOK NO. — BY — DATE

PLATE 3. CROSS SECTION U.S.P.R. & N.R. STANDARD
DITTMAN CORPORATION