
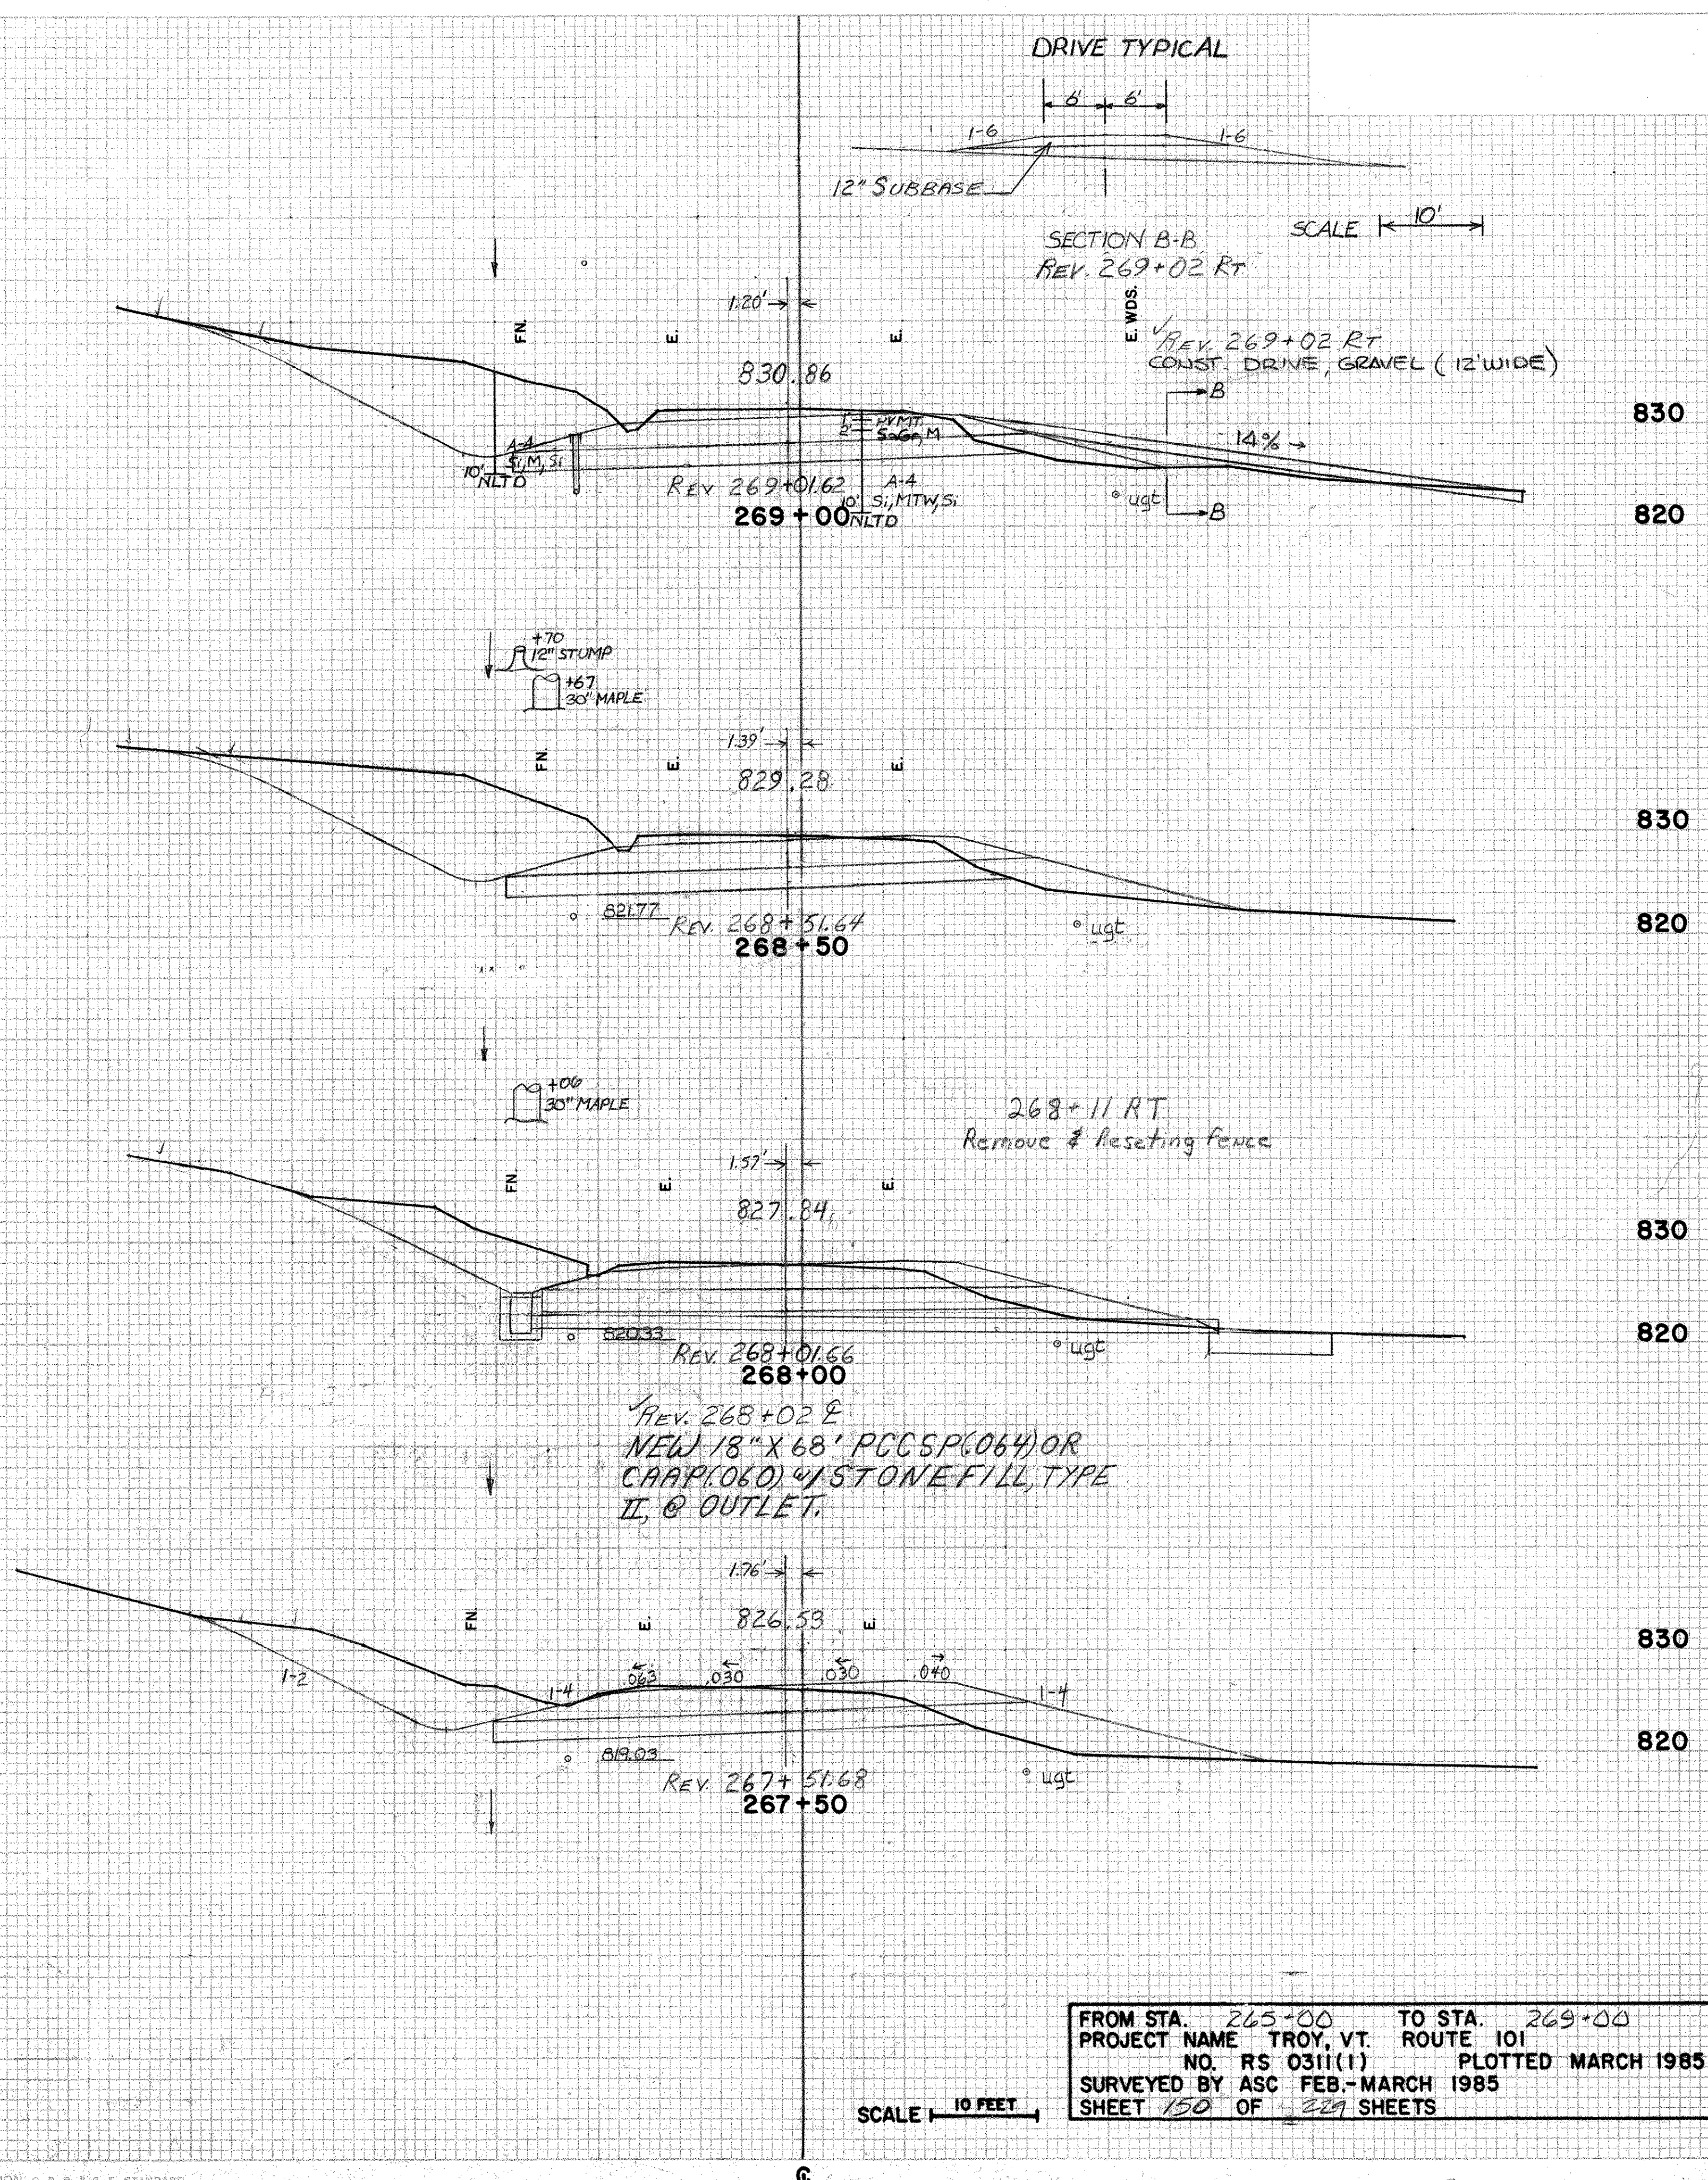


DATE	
BY	
FINAL SURVEY PLOTTED	
NOTE BOOK	
NO.	

DATE	
BY	
ORIGINAL SURVEY PLOTTED	
NOTE BOOK	
NO.	

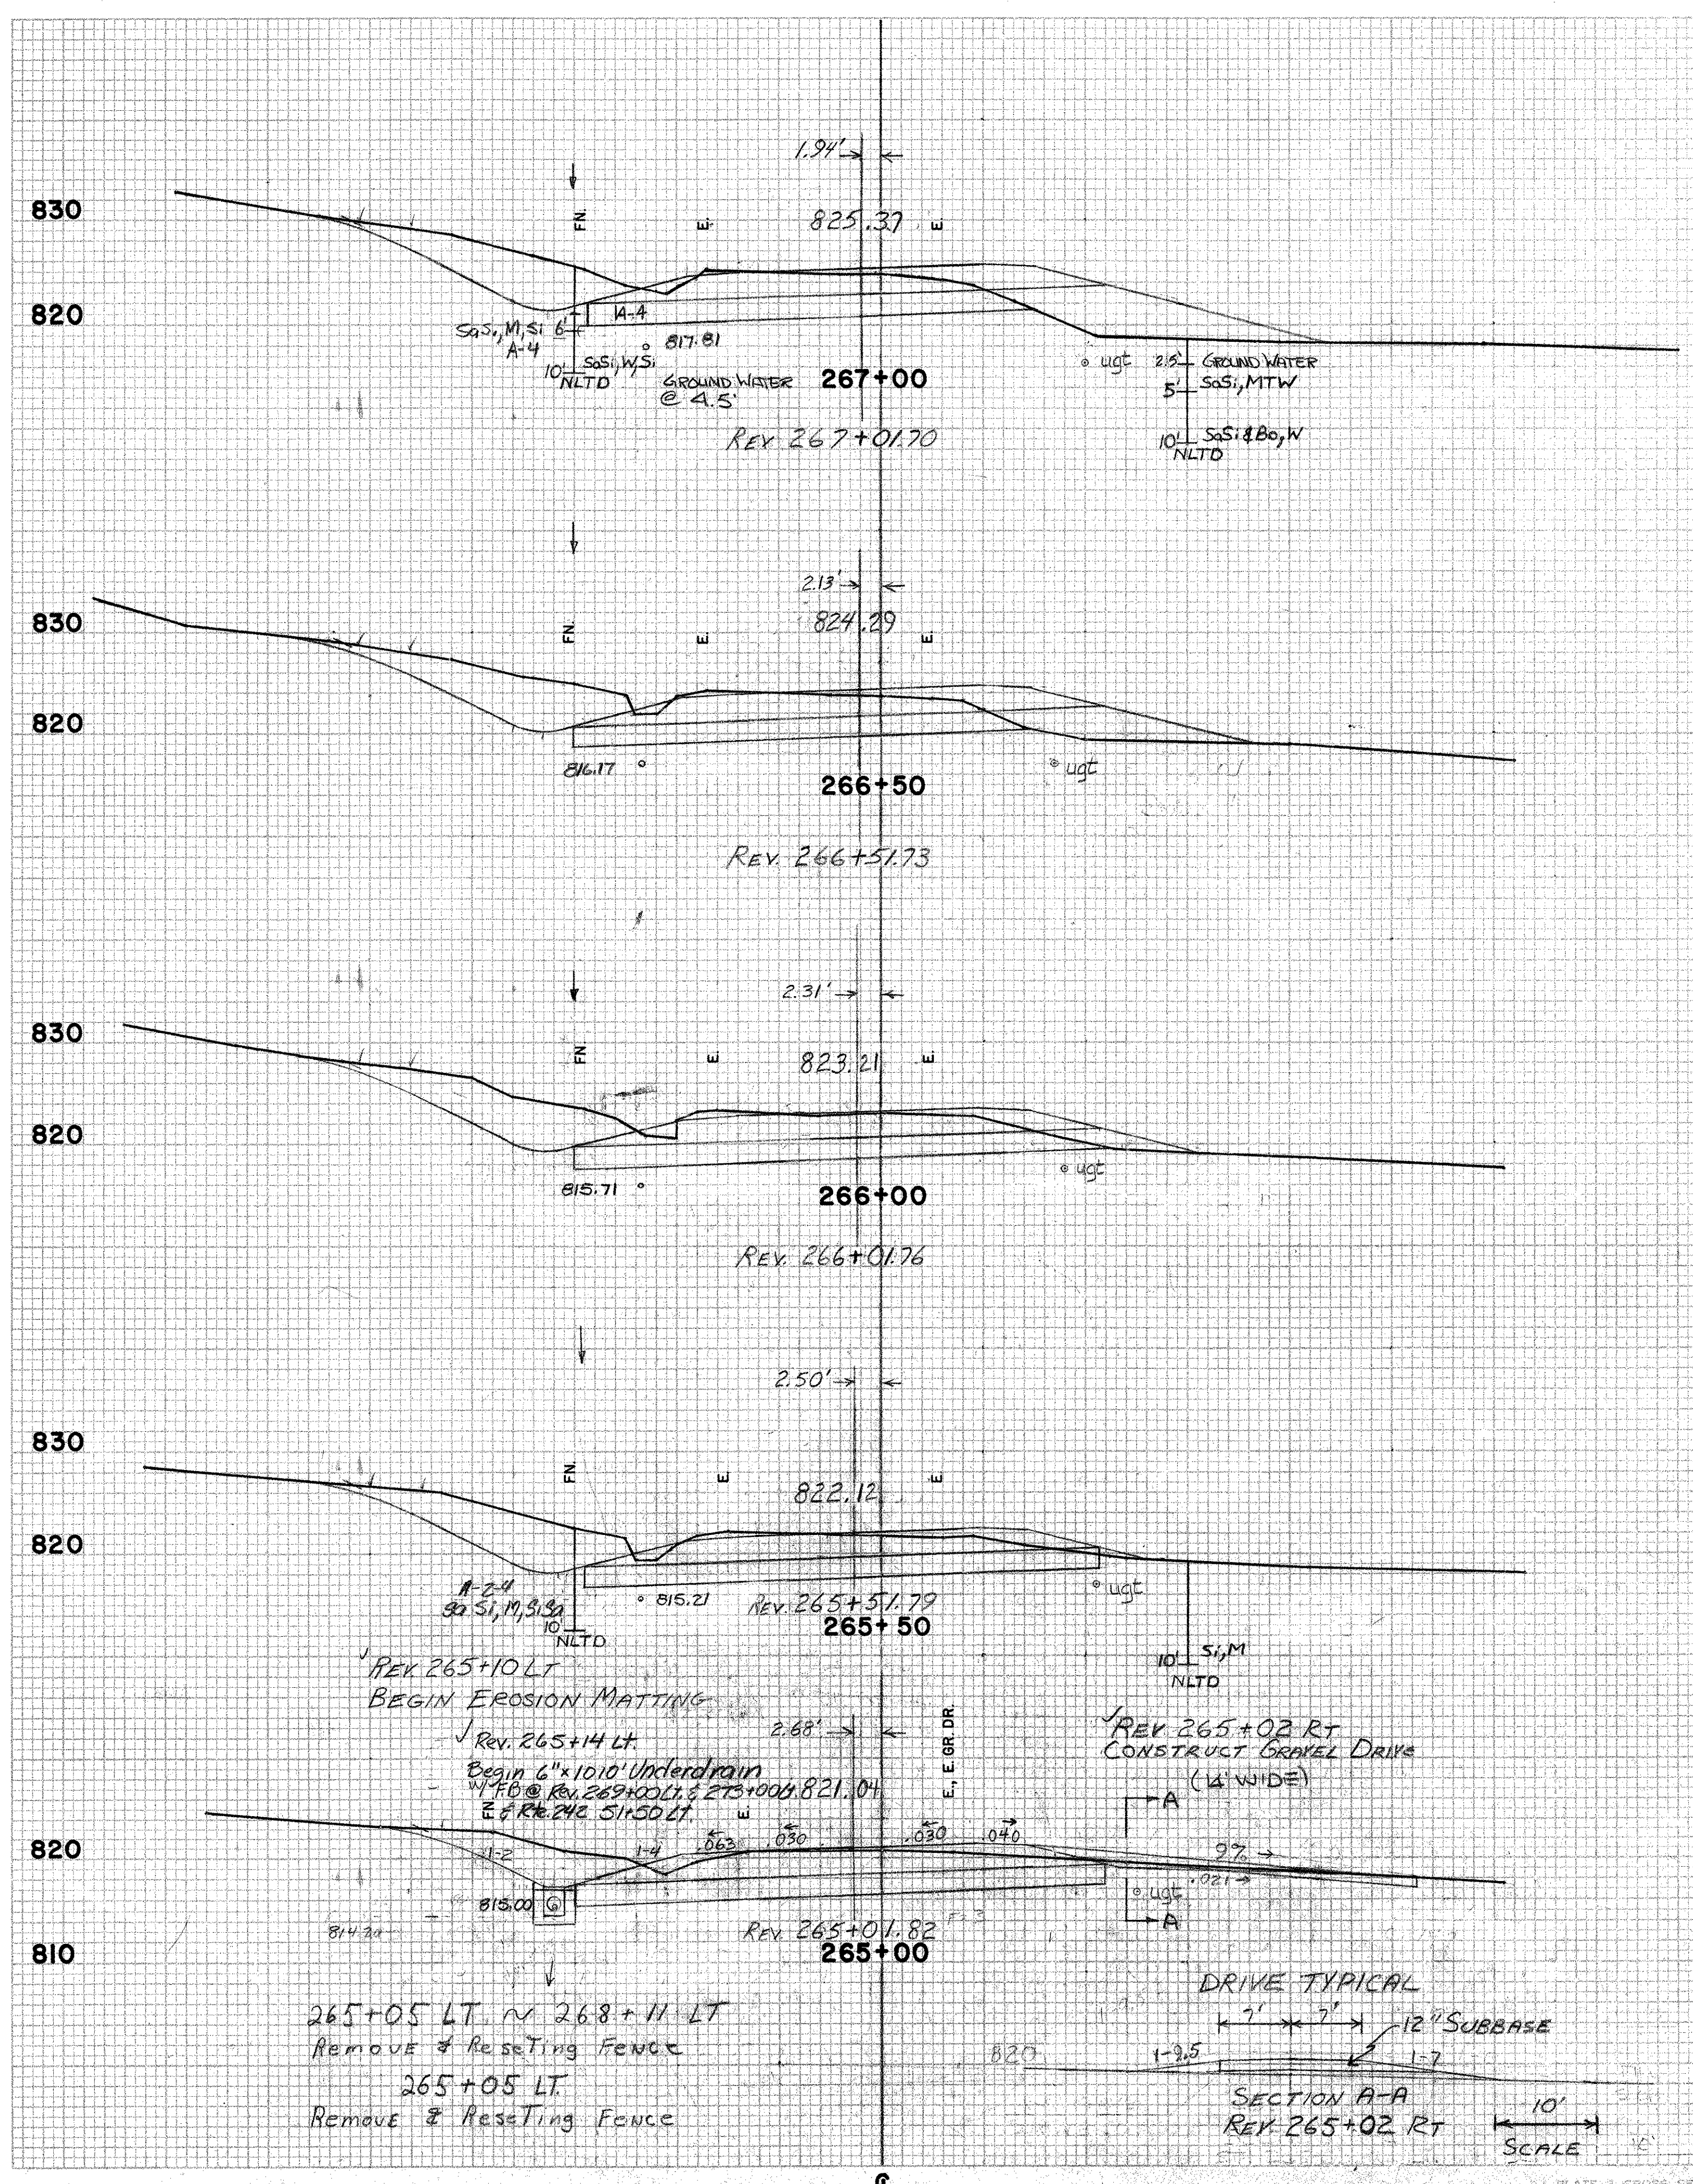

FROM STA. 265+00 TO STA. 269+00  
PROJECT NAME TROY, VT. ROUTE 101  
NO. RS 0311(1) PLOTTED MARCH 1985  
SURVEYED BY ASC FEB.-MARCH 1985  
SHEET 150 OF 229 SHEETS