


DATE: _____
 BY: _____
 SURVEYED: _____
 PLOTTED: _____
 FINAL SURVEY: _____
 NOTE BOOK: _____
 NO. _____
 AREAS CHECKED: _____

DATE: _____
 BY: _____
 SURVEYED: _____
 PLOTTED: _____
 ORIGINAL SURVEY: _____
 NOTE BOOK: _____
 NO. _____
 AREAS CHECKED: _____

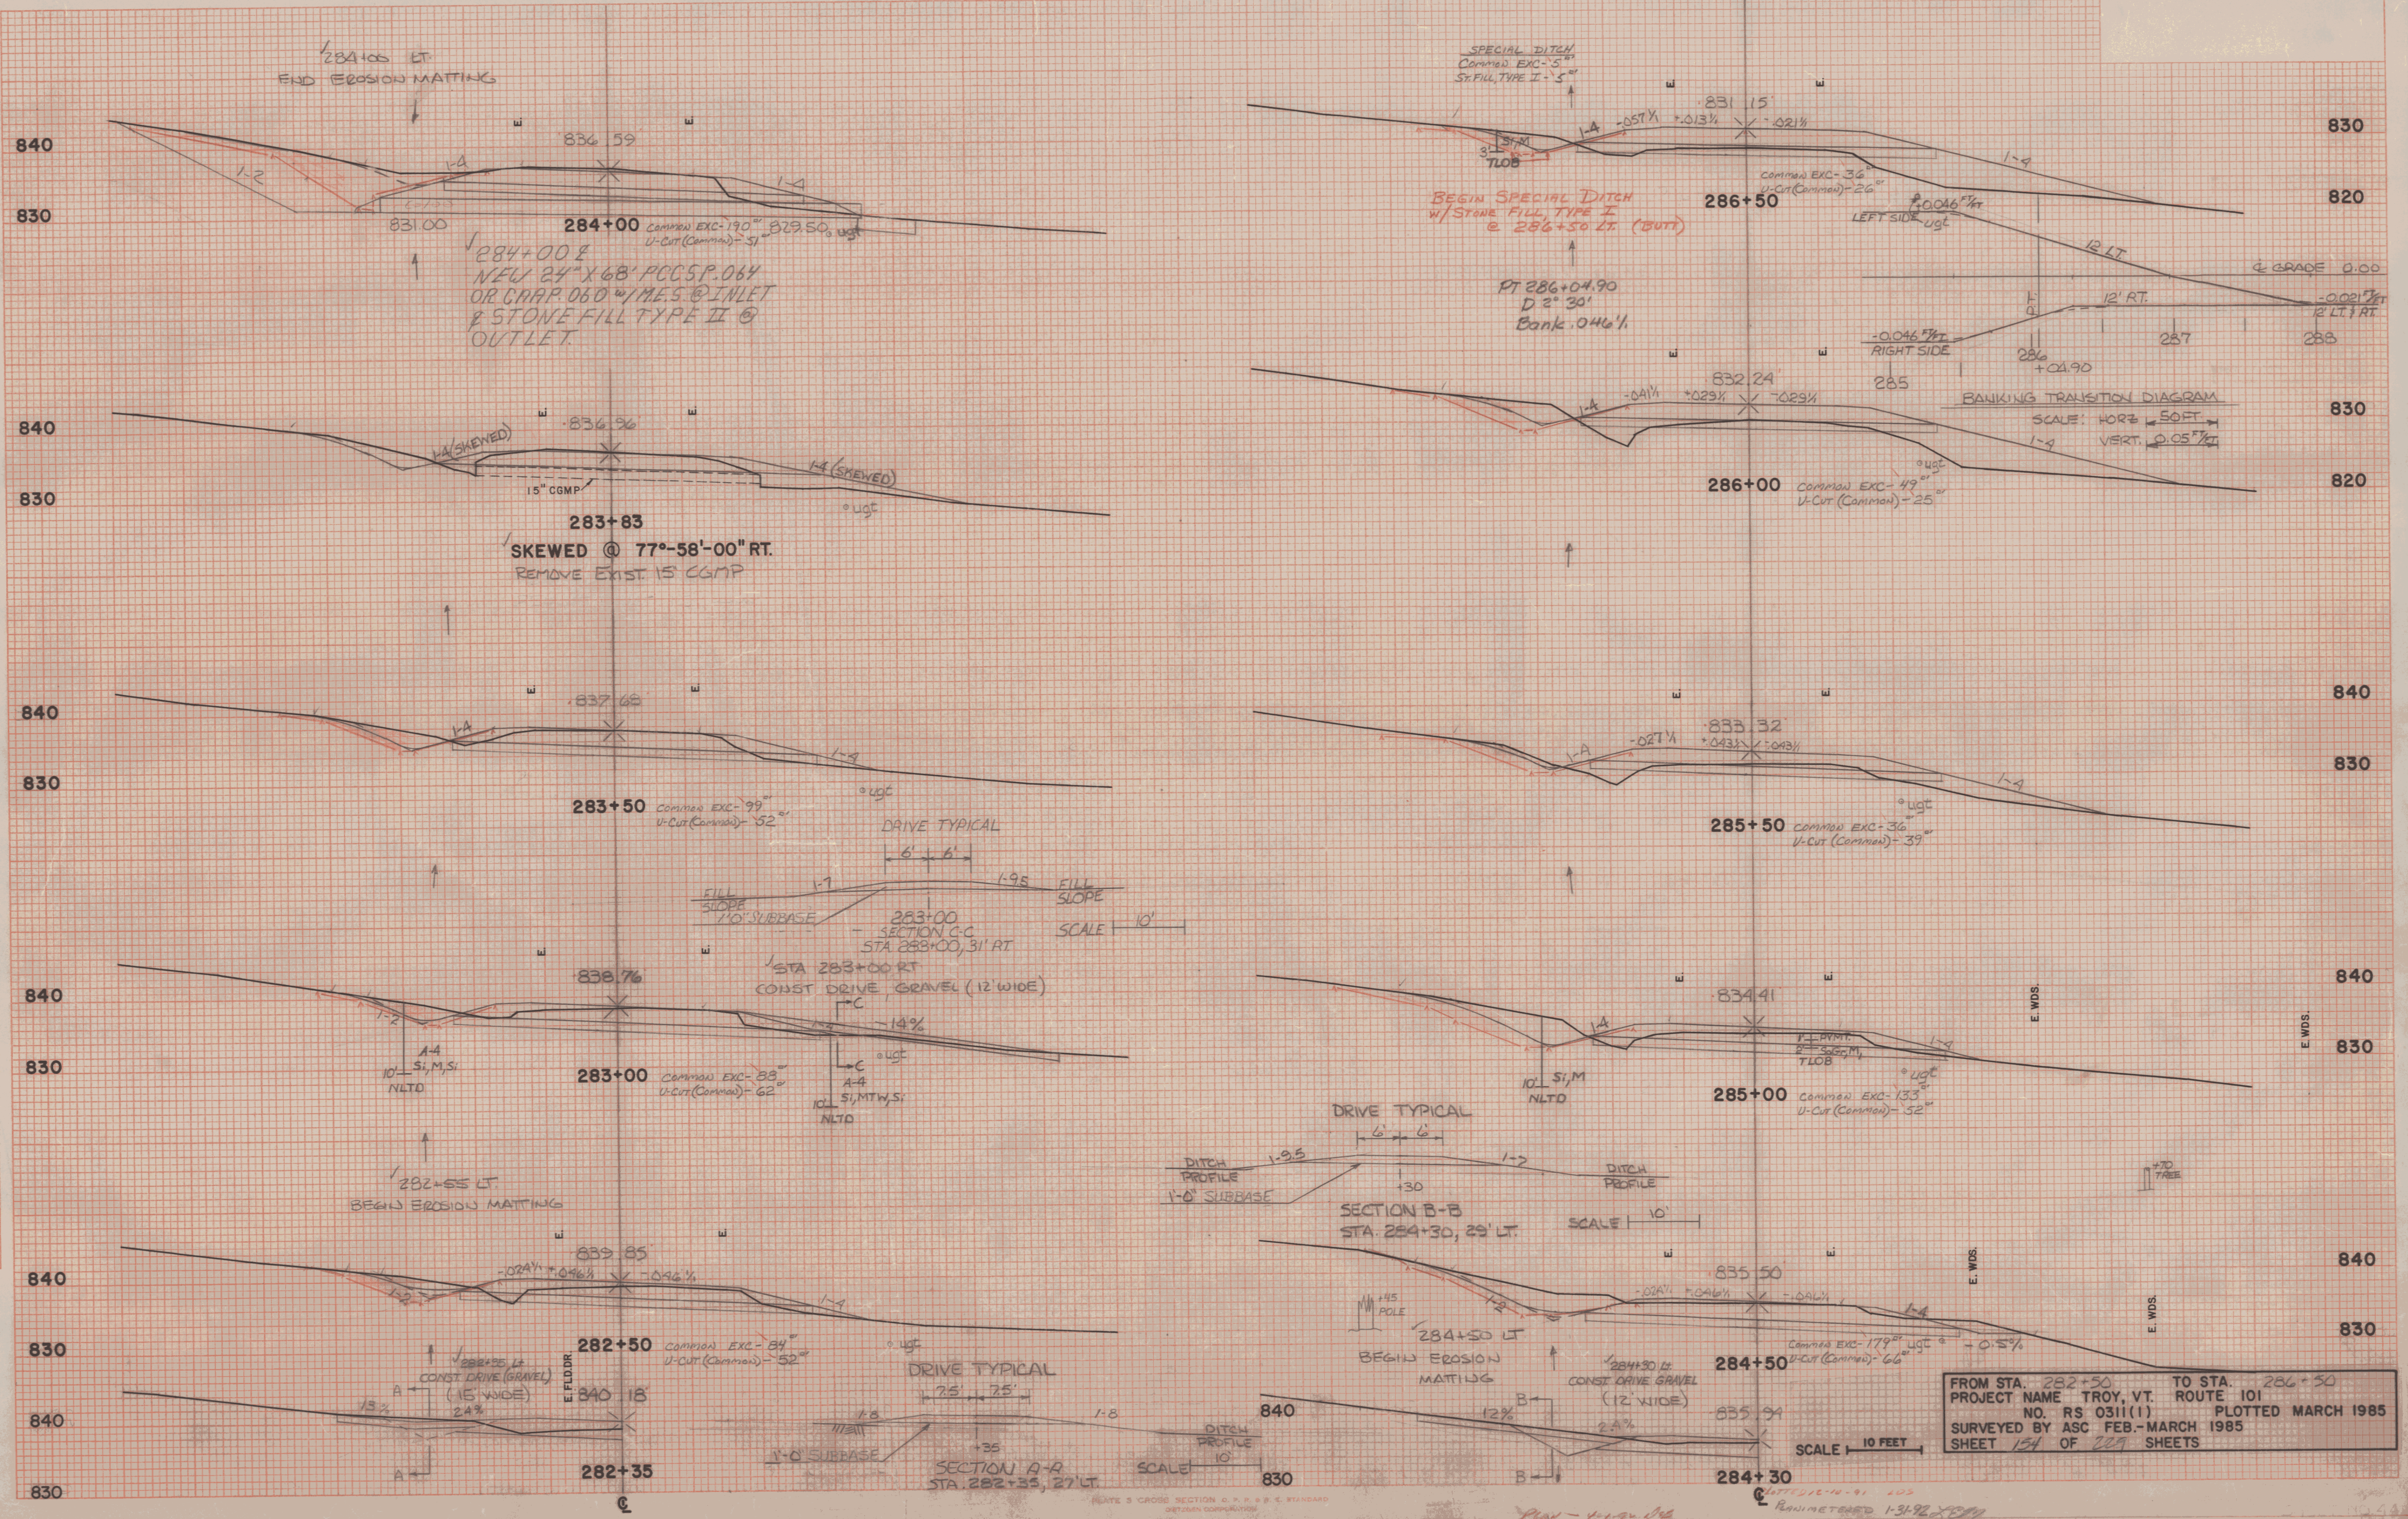

284+00
 NEW 24" X 68" PCC SP. 064
 OR CRAP. 060" M.E.S. @ INLET
 & STONE FILL TYPE II @
 OUTLET.

283+83
 SKEWED @ 77°-58'-00" RT.
 REMOVE EXIST. 15" CGMP

DRIVE TYPICAL
 6' + 6'

283+00
 SECTION C-C
 STA. 288+00, 31' RT.
 SCALE 10'

283+00 RT
 CONST DRIVE GRAVEL (12' WIDE)

DRIVE TYPICAL
 6' + 6'

SECTION B-B
 STA. 284+30, 29' LT.
 SCALE 10'

284+50 LT
 BEGN EROSION
 MATTING

DRIVE TYPICAL
 7.5' + 7.5'

SECTION A-A
 STA. 282+35, 27' LT.
 SCALE 10'

FROM STA. 282+50 TO STA. 286+50
 PROJECT NAME TROY, VT. ROUTE 101
 NO. RS 0311(1) PLOTTED MARCH 1985
 SURVEYED BY ASC FEB.-MARCH 1985
 SHEET 151 OF 229 SHEETS