




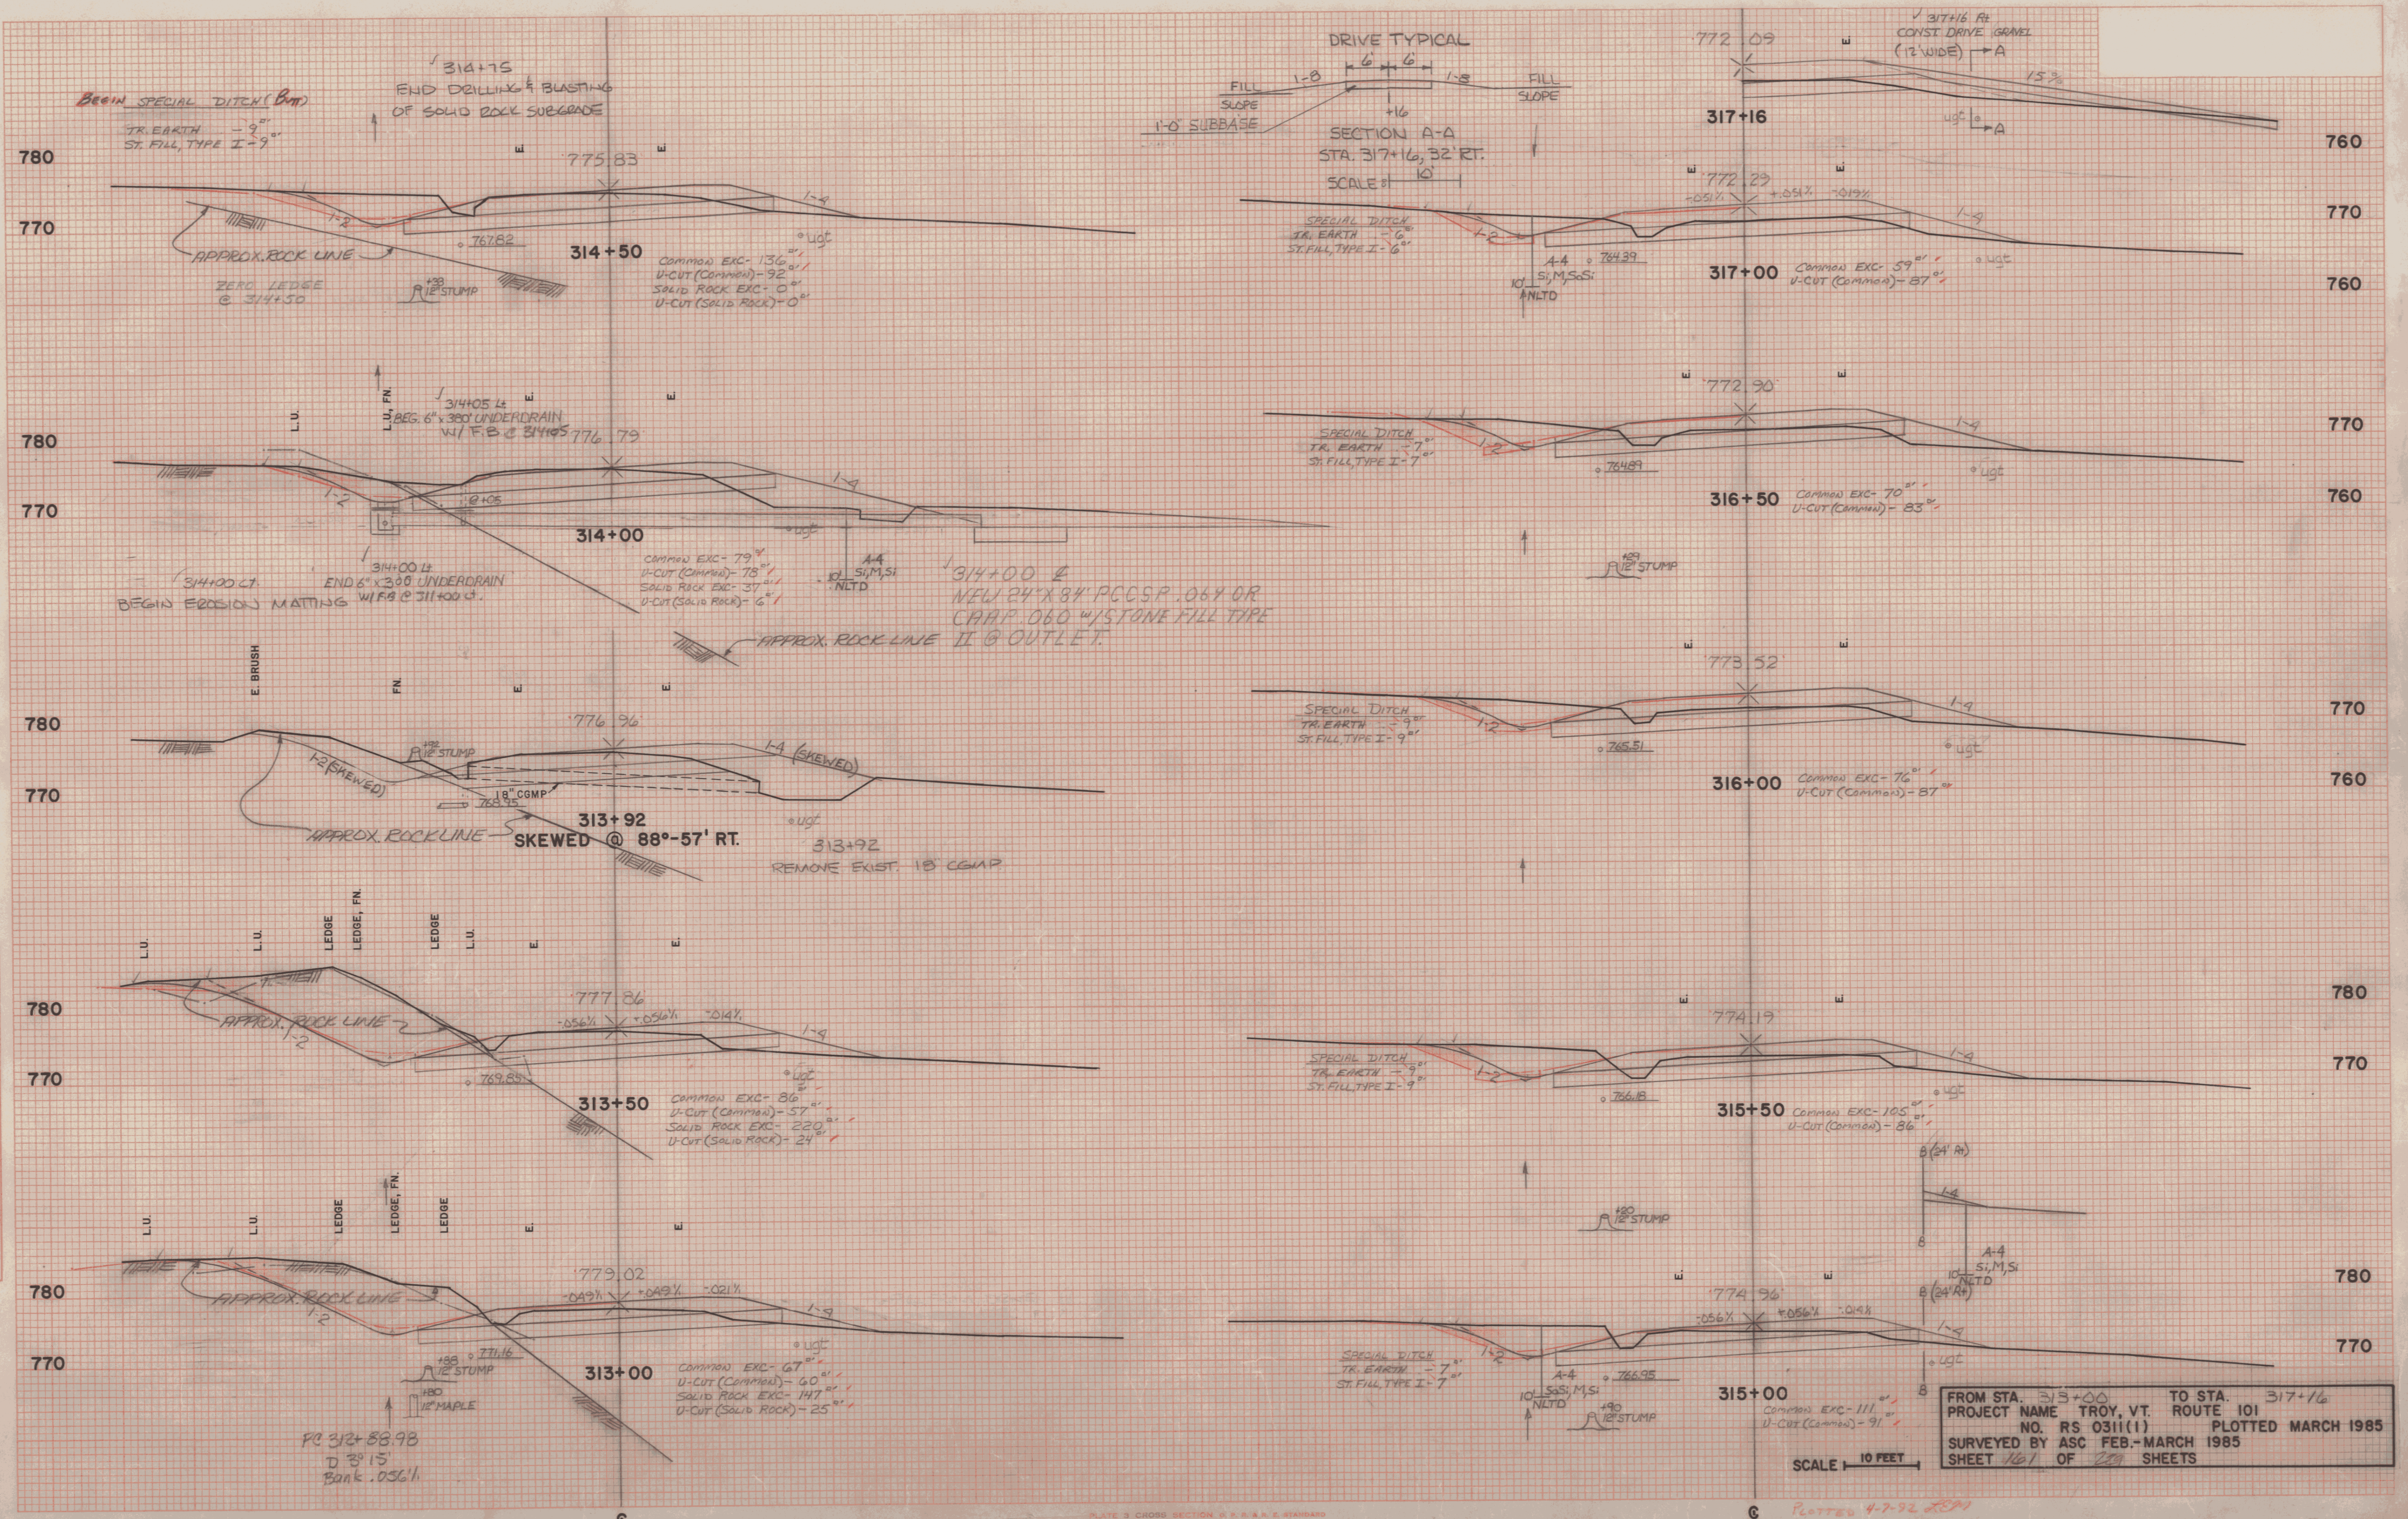

FROM STA. 313+00 TO STA. 317+16
 PROJECT NAME TROY, VT. ROUTE 101
 NO. RS 0311(1) PLOTTED MARCH 1985
 SURVEYED BY ASC FEB.-MARCH 1985
 SHEET 161 OF 229 SHEETS

SCALE 1" = 10 FEET

Plotted 4-7-92 LCP
 RANIMETERED 4-8-92 LCP
 PLAN 4-9-92 LCP