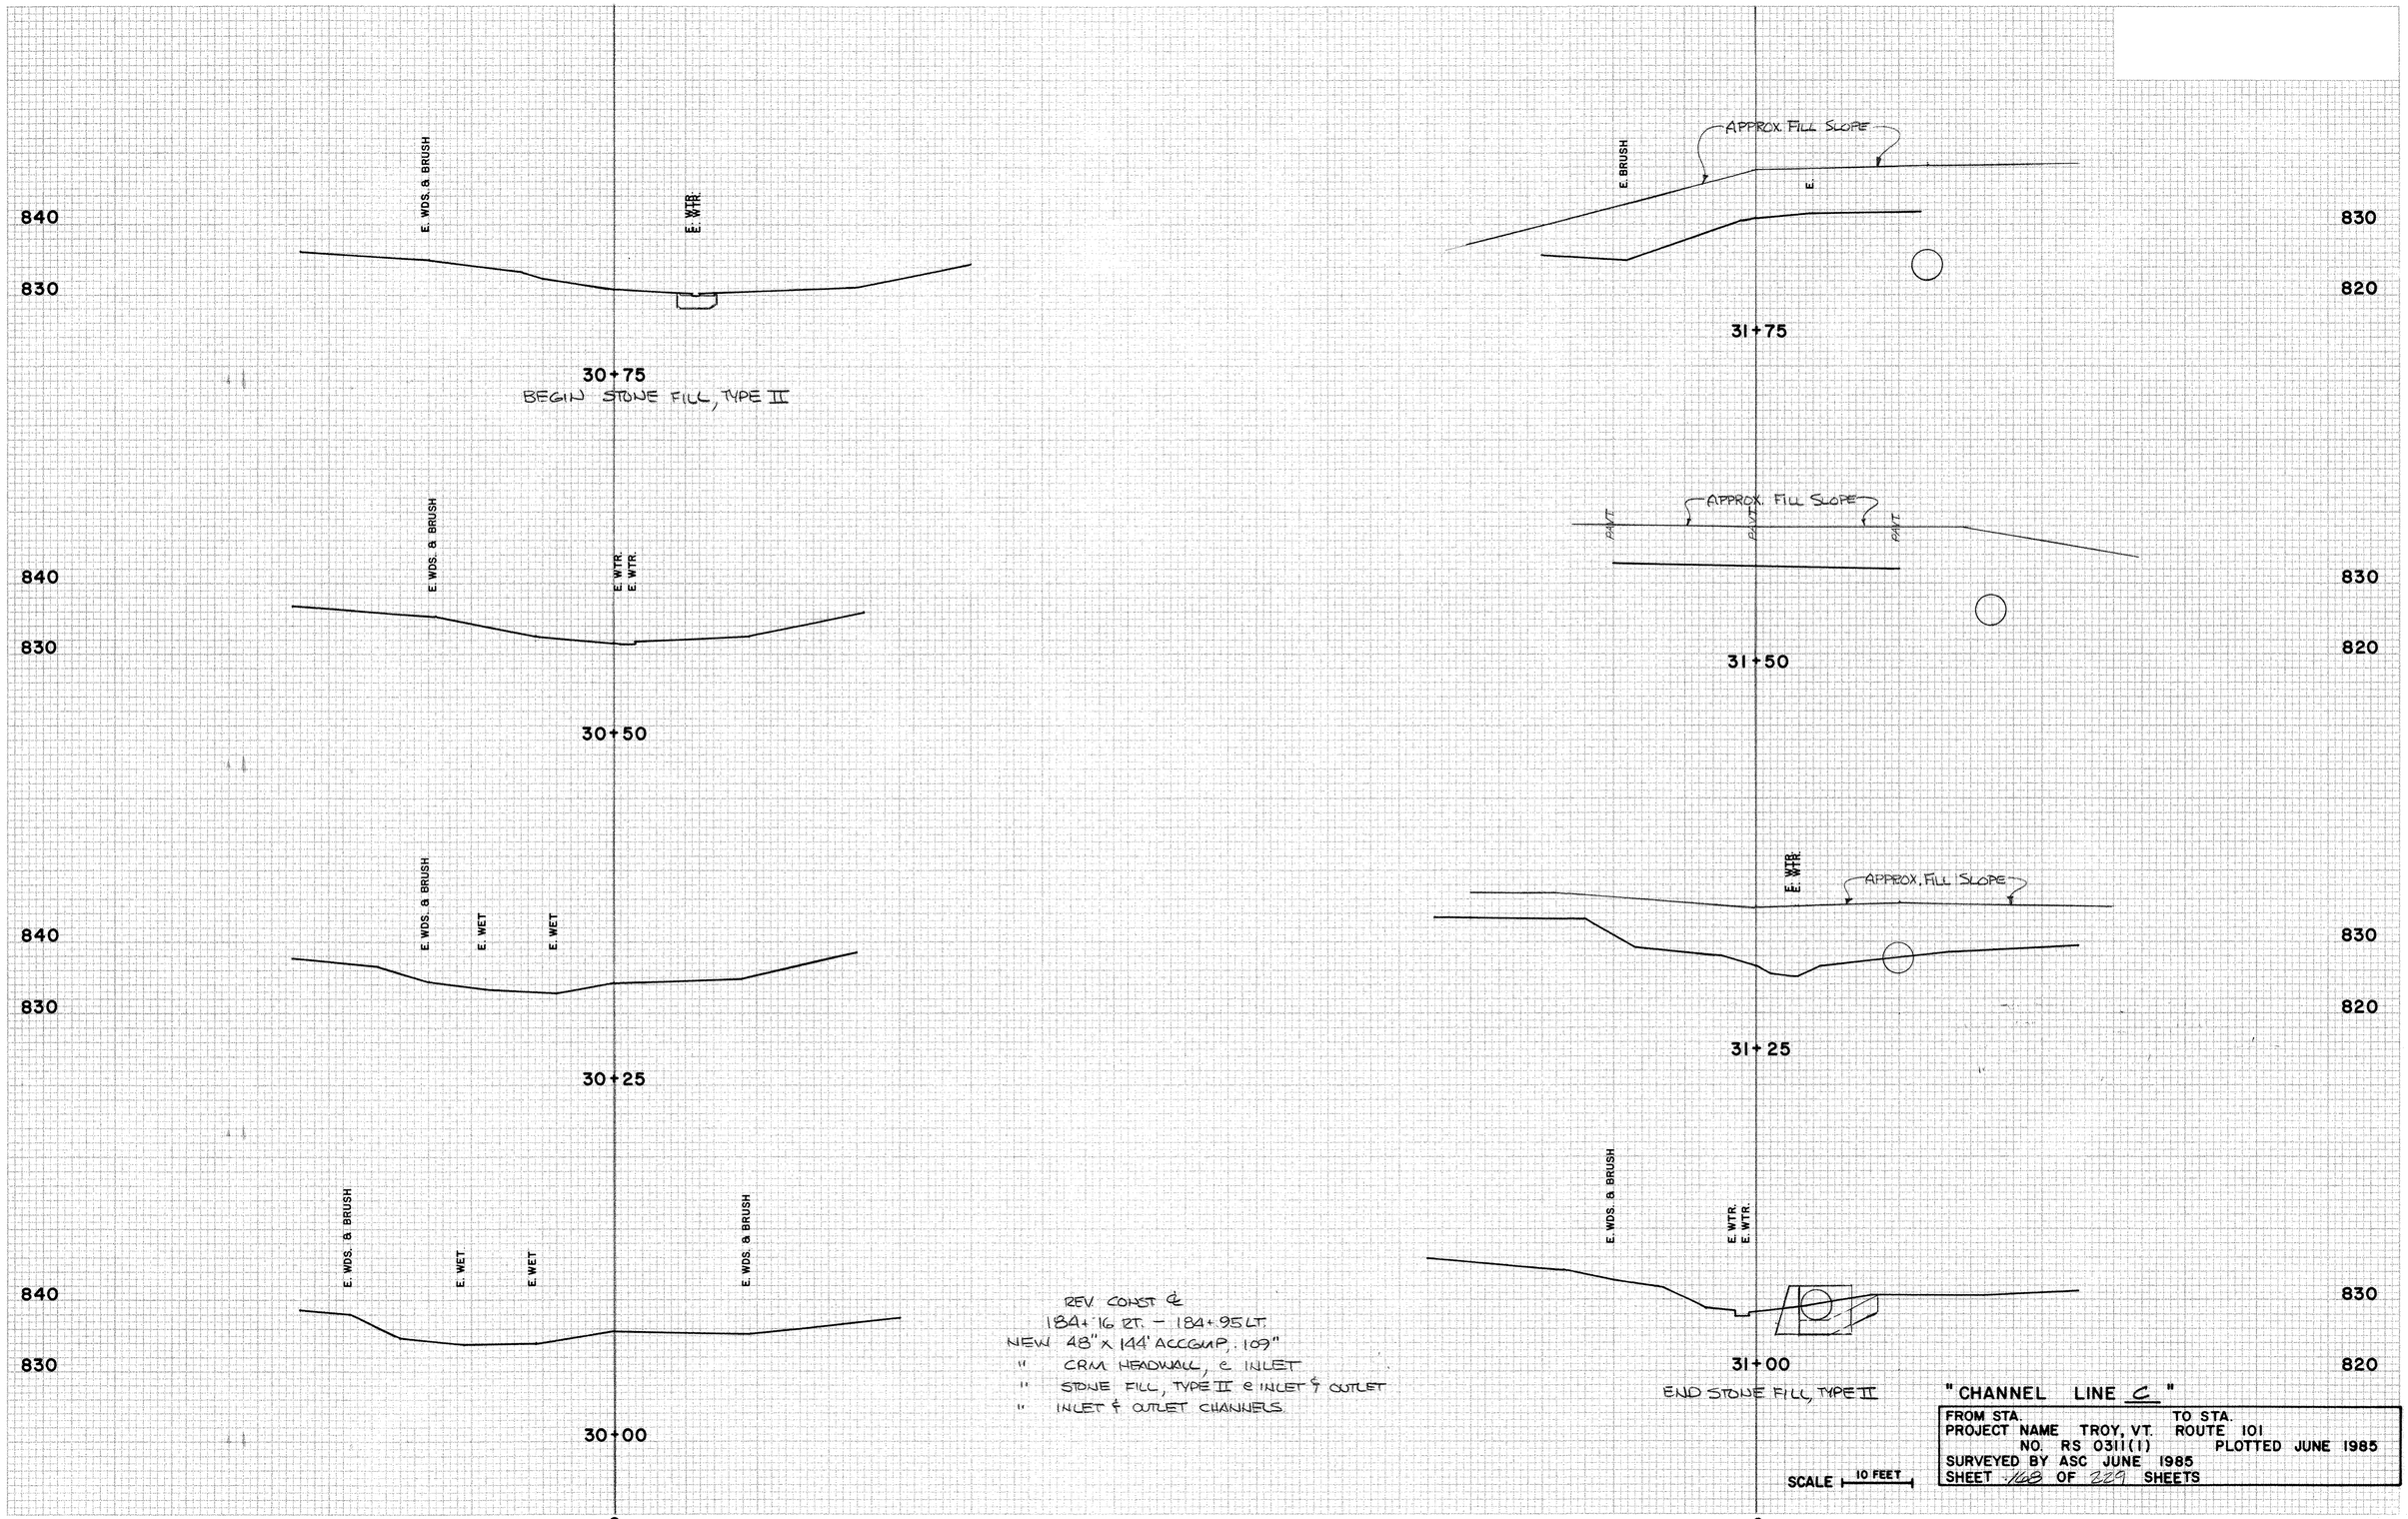

"CHANNEL LINE C"

FROM STA.	TO STA.
PROJECT NAME TROY, VT.	ROUTE 101
NO. RS 0311(1)	PLOTTED JUNE 1985
SURVEYED BY ASC JUNE 1985	
SHEET 168 OF 229 SHEETS	

FINAL SURVEY — NOTE BOOK No. — SURVEYED / PLOTTED / TRACED / AREAS / AREAS CHECKED — BY — DATE

ORIGINAL SURVEY — NOTE BOOK No. — SURVEYED / PLOTTED / TRACED / AREAS / AREAS CHECKED — BY — DATE

PLATE 5 CROSS SECTION B. & R. & N. Y. STANDARD DIVISION CORPORATION

PLOTTED BY CLD 06-85