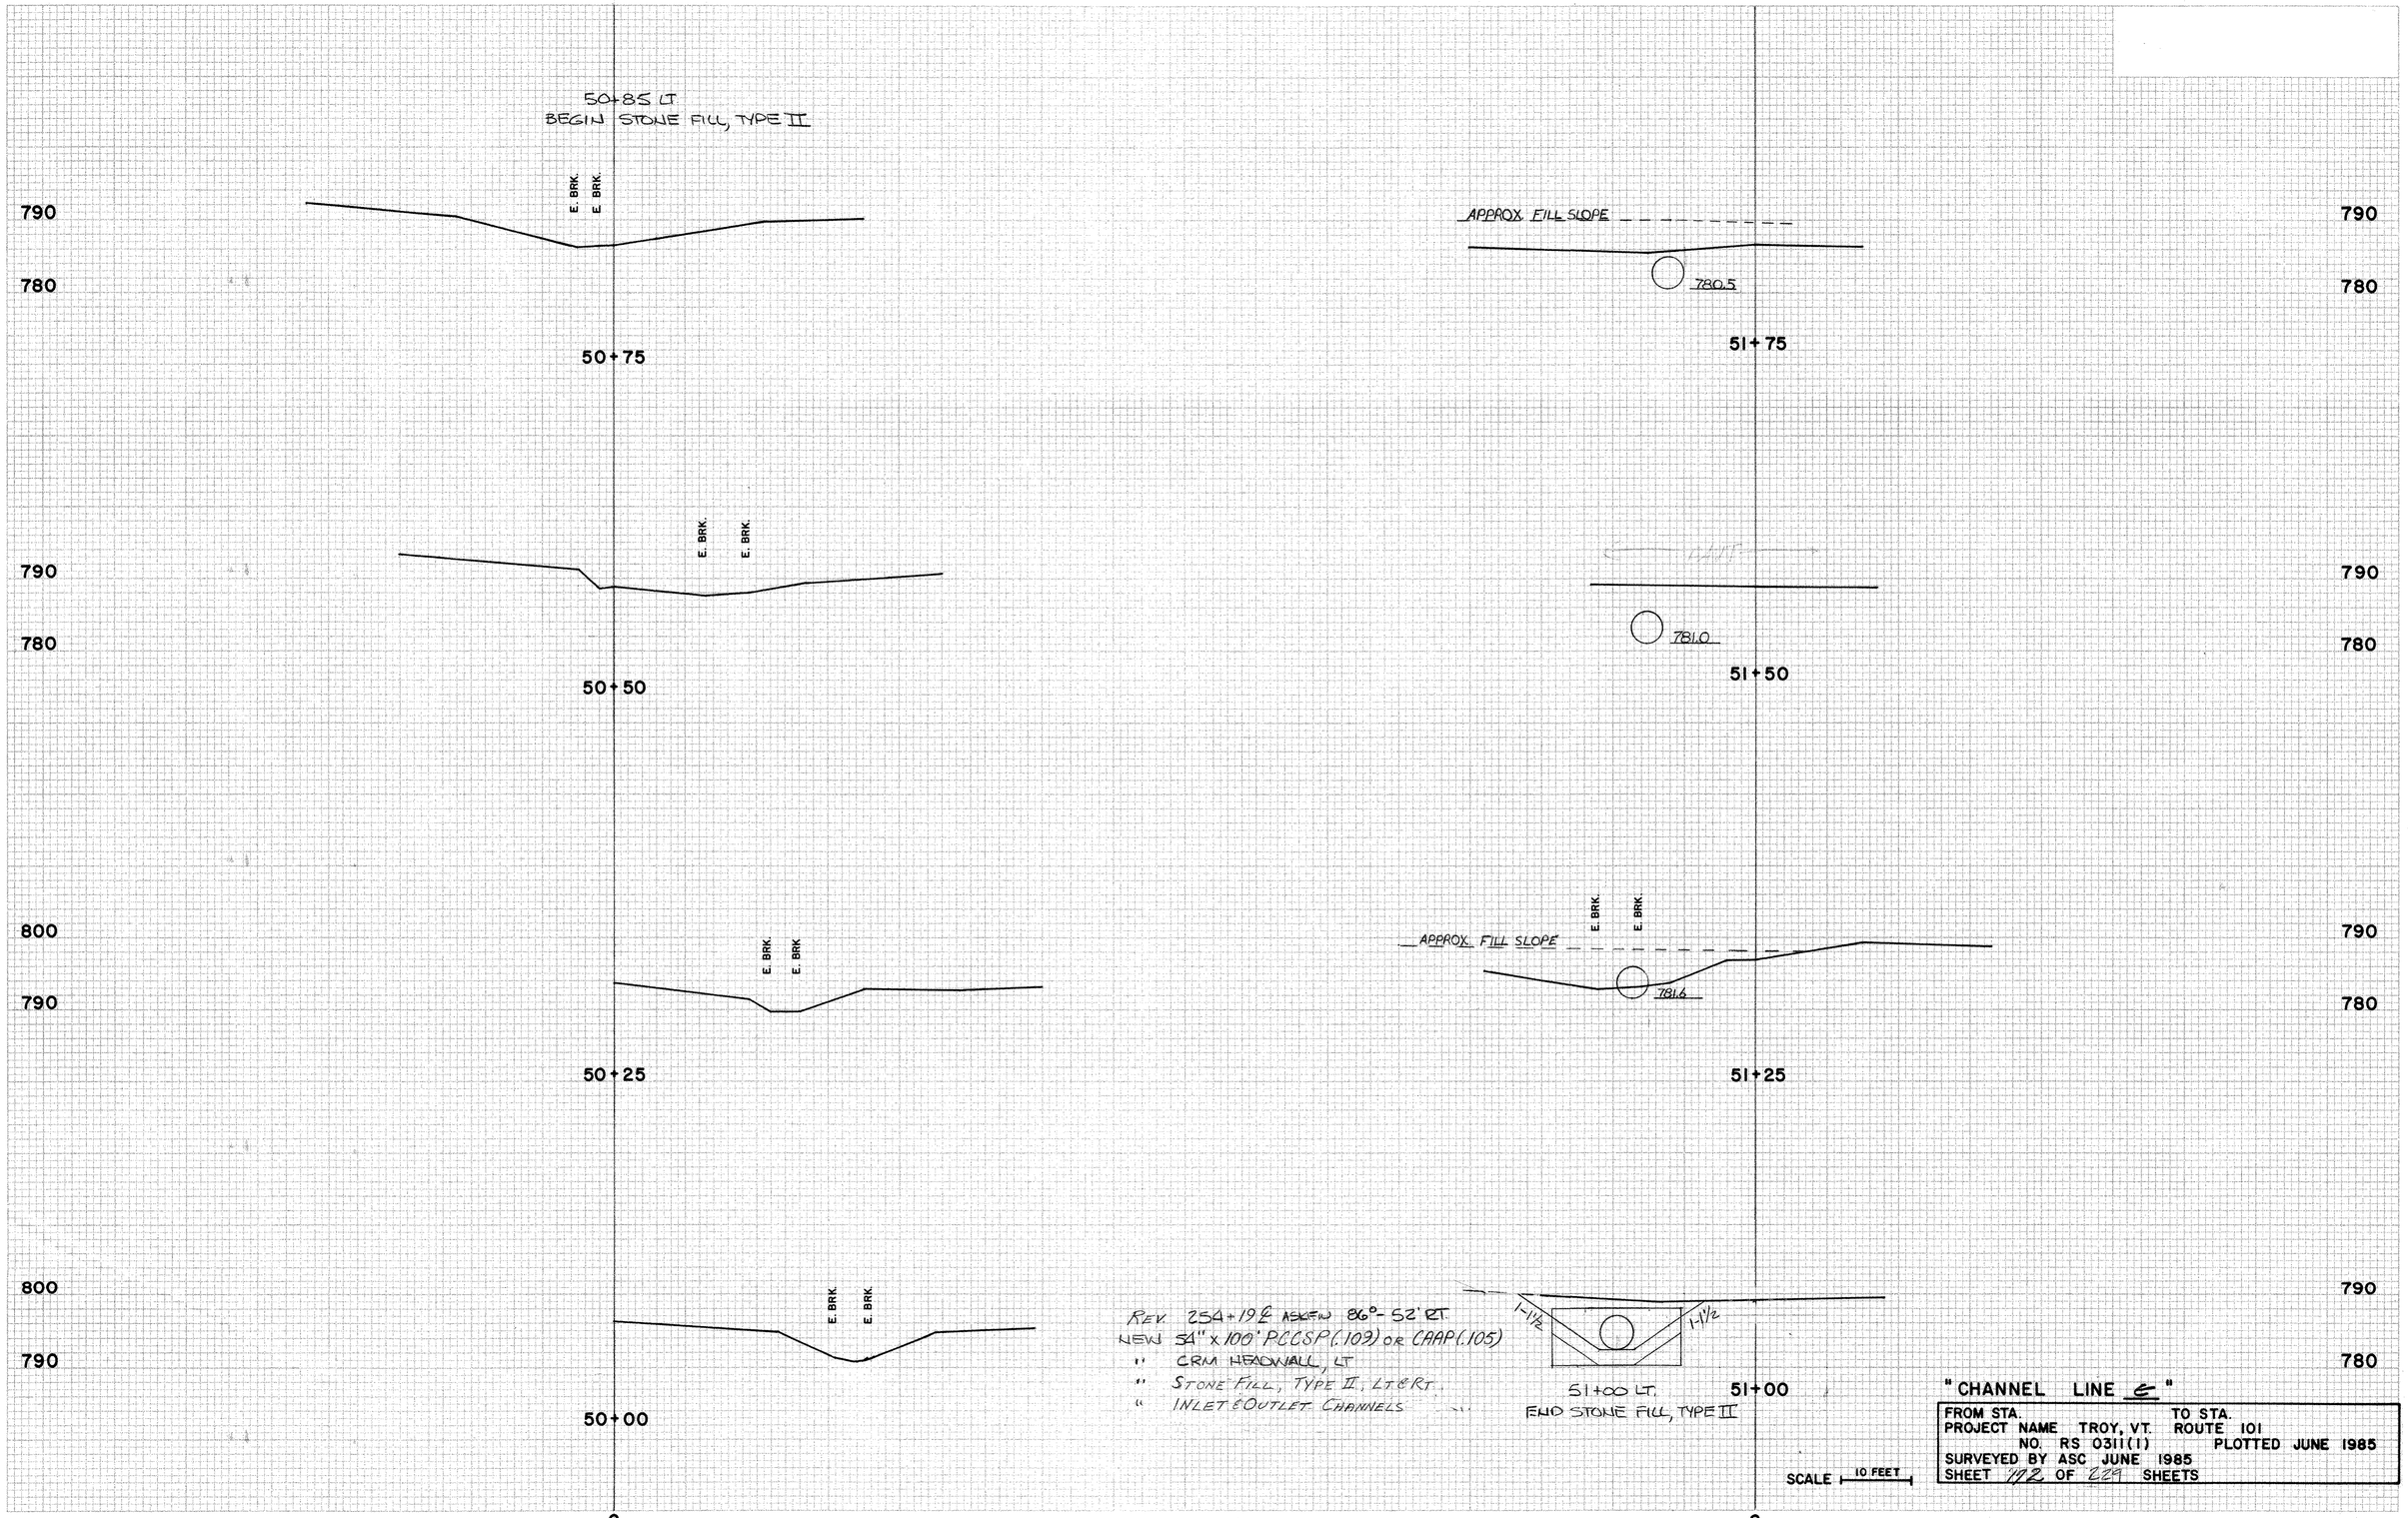

REV. 254+19 ℄ ASKEW 86°- 52' RT.
NEW 54" x 100' PCCSP (.103) OR CAAP (.105)
" CRM HEADWALL, LT
" STONE FILL, TYPE II, LT & RT.
" INLET & OUTLET CHANNELS

"CHANNEL LINE ℄"

FROM STA.	TO STA.
PROJECT NAME TROY, VT.	ROUTE 101
NO. RS 0311(1)	PLOTTED JUNE 1985
SURVEYED BY ASC JUNE 1985	
SHEET 112 OF 229 SHEETS	

FINAL SURVEY	SURVEYED	DATE
	PLOTTED	
NOTE BOOK	TEMPLATE	
	TRAVERSE	
NO.	AREAS CHECKED	

ORIGINAL SURVEY	SURVEYED	DATE
	PLOTTED	
NOTE BOOK	TEMPLATE	
	TRAVERSE	
NO.	AREAS CHECKED	

PLATE 3 CROSS SECTIONS U.S. B. & R. S. STANDARD
OATSDEN CORPORATION

PLOTTED BY CLD 06-85