


DATE  
BY  
SURVEYED  
PLOTTED  
NOTE BOOK  
AREAS CHECKED

DATE  
BY  
SURVEYED  
PLOTTED  
NOTE BOOK  
AREAS CHECKED

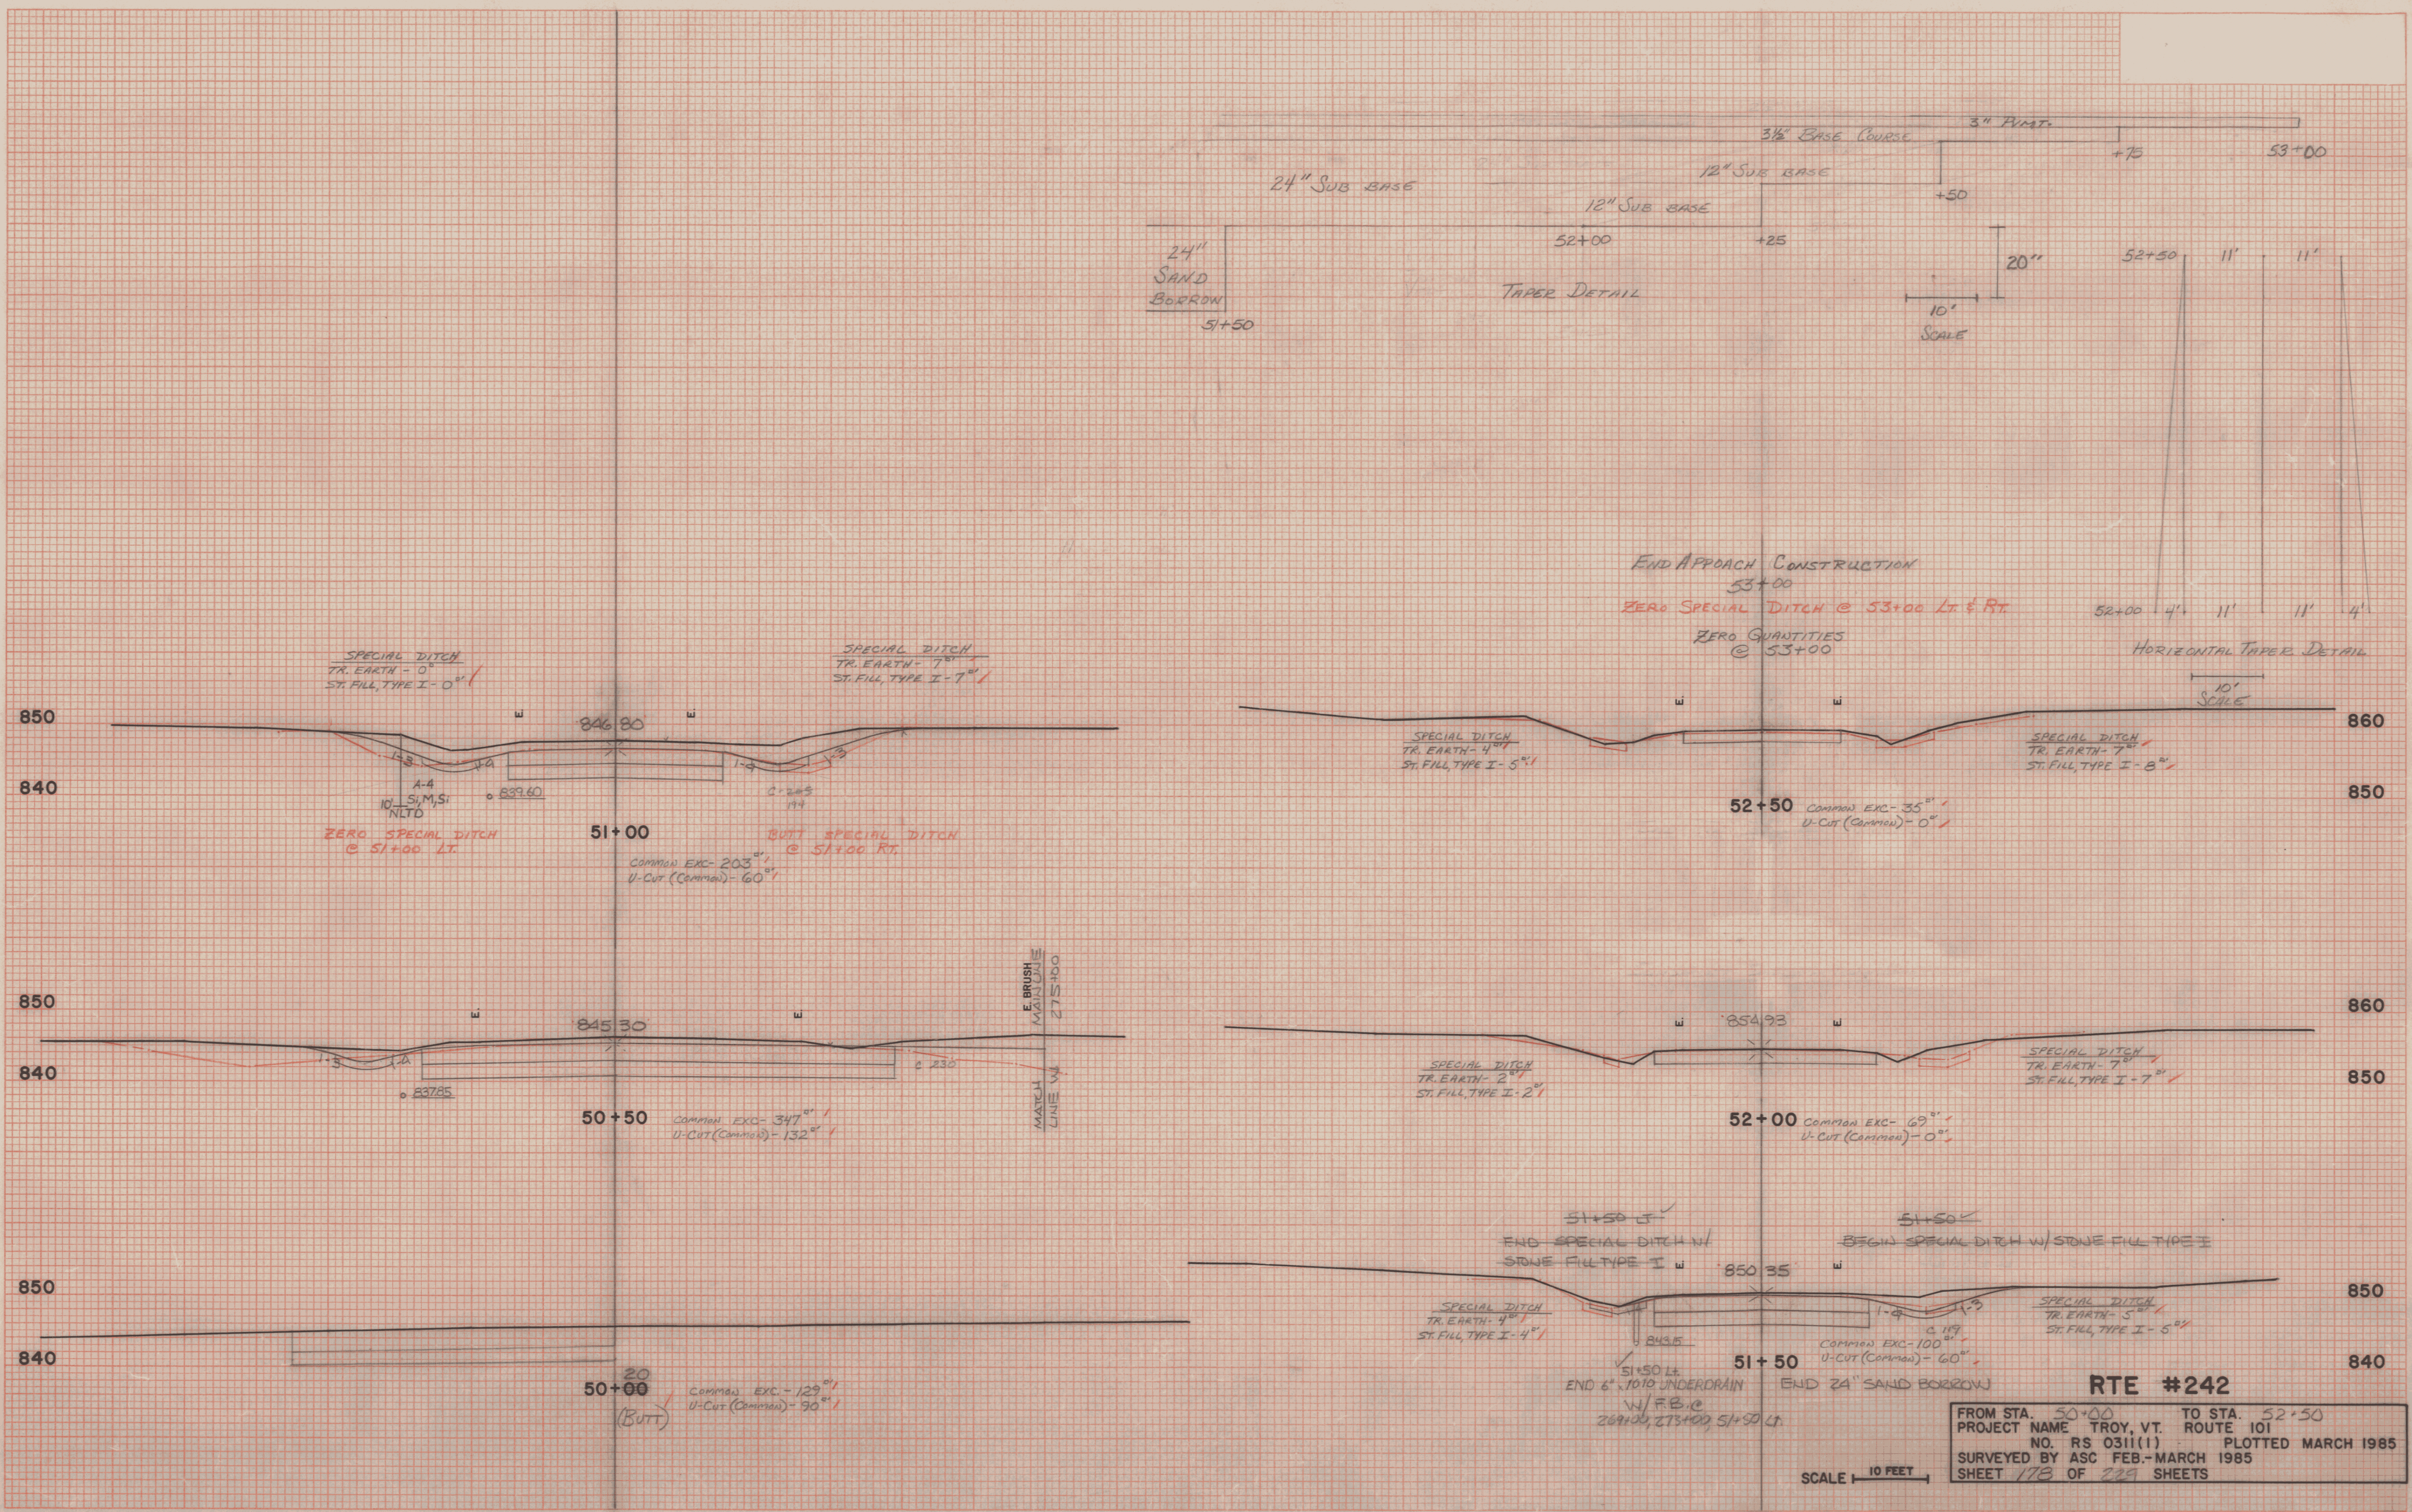

**RTE #242**  
 FROM STA. 50+00 TO STA. 52+50  
 PROJECT NAME TROY, VT. ROUTE 101  
 NO. RS 0311(1) PLOTTED MARCH 1985  
 SURVEYED BY ASC FEB.-MARCH 1985  
 SHEET 17B OF 229 SHEETS

SCALE 10 FEET

Plotted 4-29-85  
 Rechecked 4-29-85  
 I.L.A.W. 4-10-85