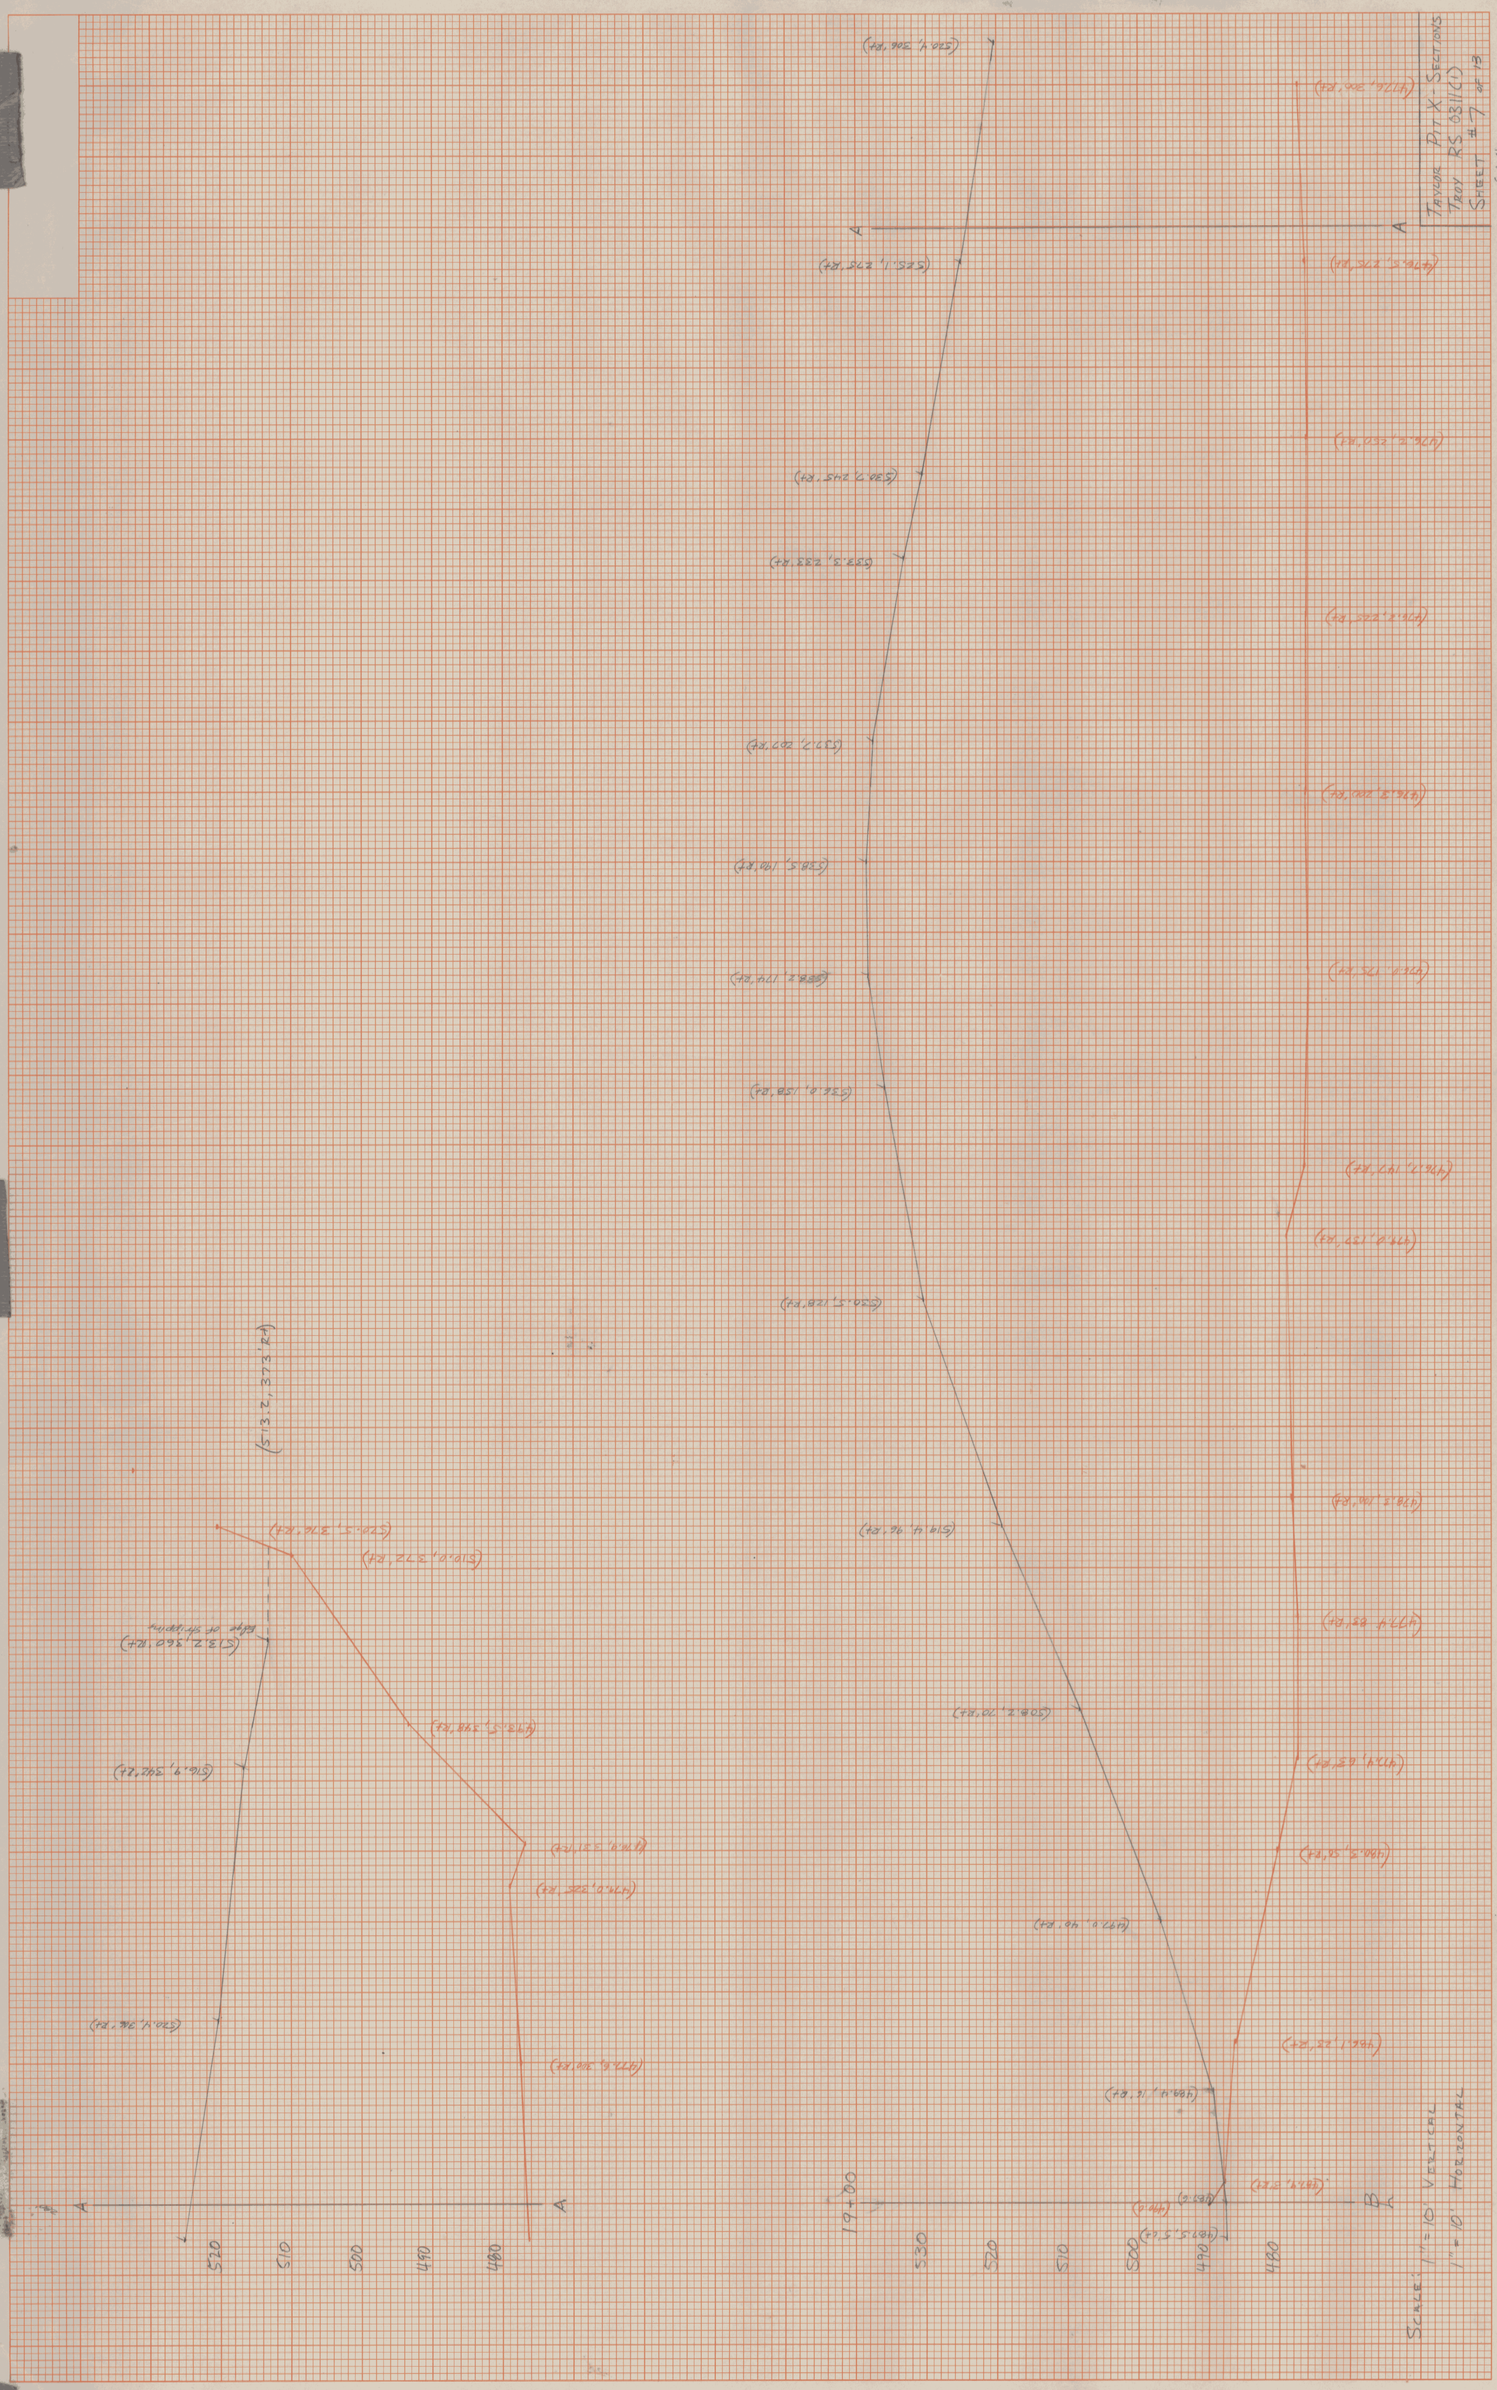
Taylor Pit X Sections
Troy RS 0811(1)
Sheet #7 of 19
S.L.N.
8-21-91
25745
Plate 3 Cross Section O.P.A.R.E. Standard
Dietzgen Corporation
Scale: 1"=10' Vertical
1"=10' Horizontal
Original Survey
Note Book
Final Survey
Note Book
Surveyed
Plotted
Template
Areas
Areas Checked
No.
Date
By
A
B
10+00
520
510
500
490
480
530
520
510
500
490
480
(513.2, 373.2)
Edge of Shoulder