TAYLOR PIT X-SECTIONS
TROY, RS OR 110
STREET # 8 OF 13

8-21-91

2 5 8 2 5

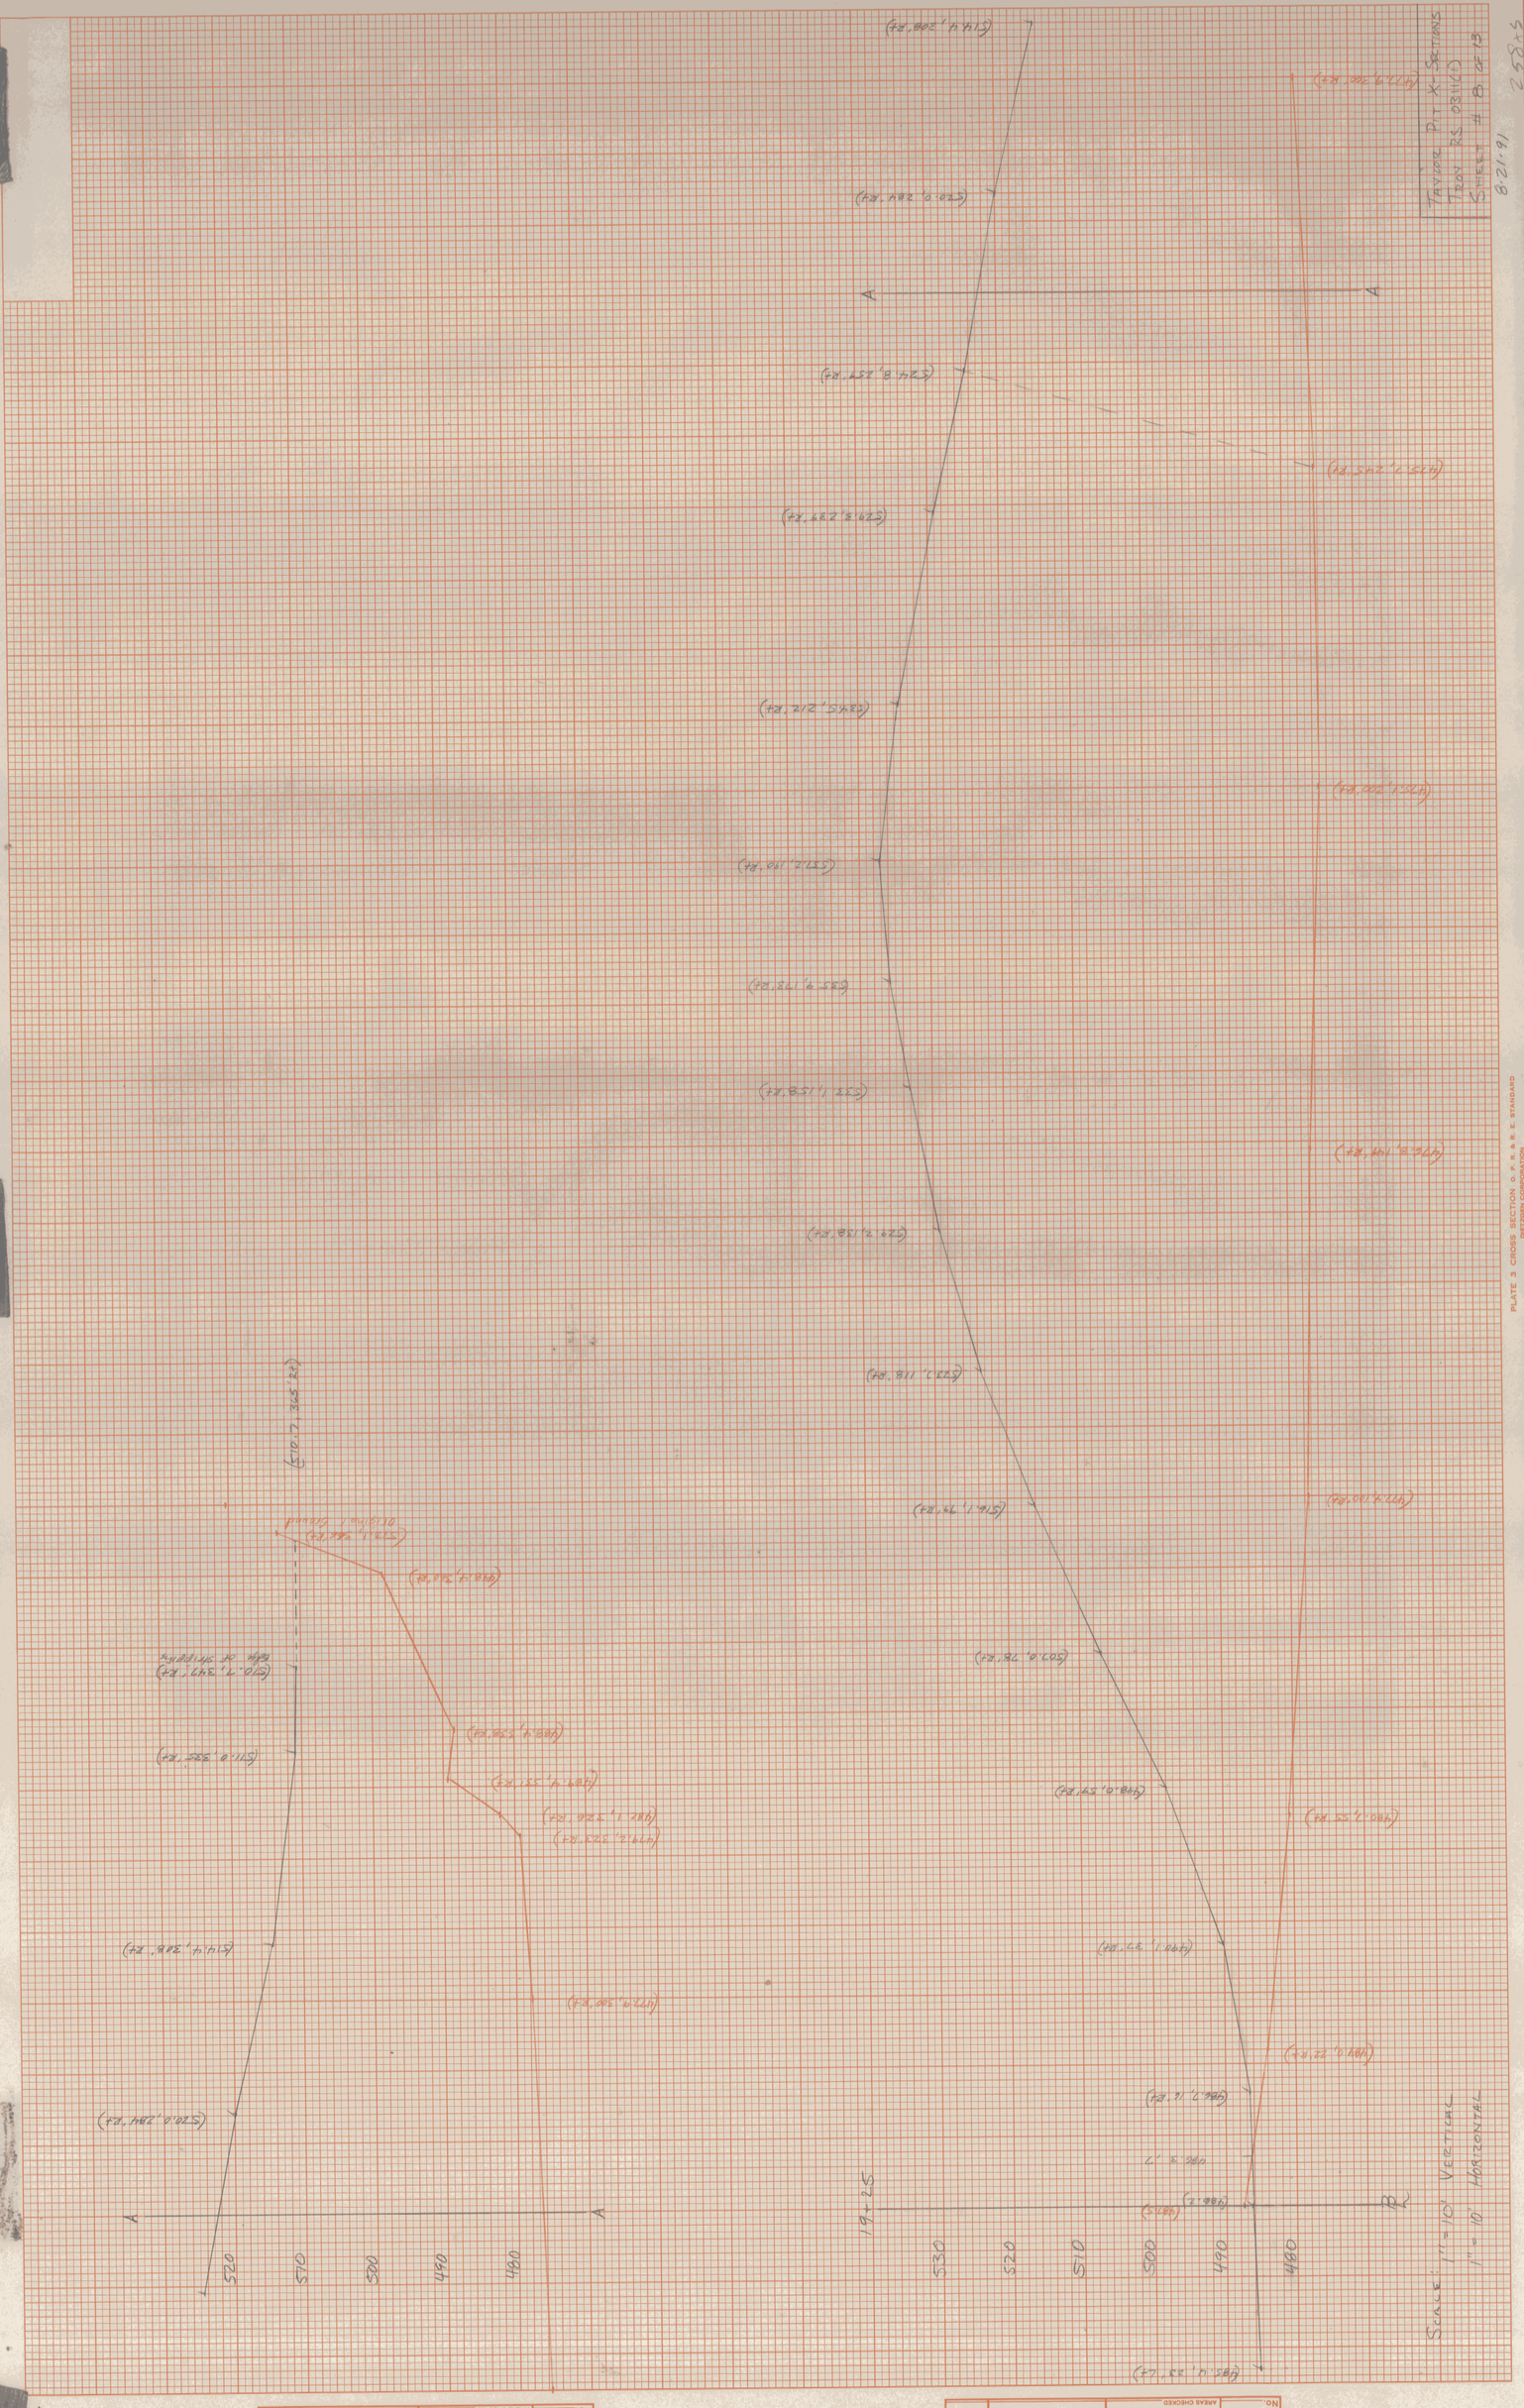

PLATE 3 CROSS SECTION O.R.N.W.R. STANDARD
PRIMARY CONTRACTOR

ORIGINAL SURVEY NOTE BOOK			
SURVEYED		BY	DATE
NOTTED			
TEMPLATE			
AREAS			
AREAS CHECKED			
NO.			

FINAL SURVEY NOTE BOOK			
SURVEYED		BY	DATE
NOTTED			
TEMPLATE			
AREAS			
AREAS CHECKED			
NO.			