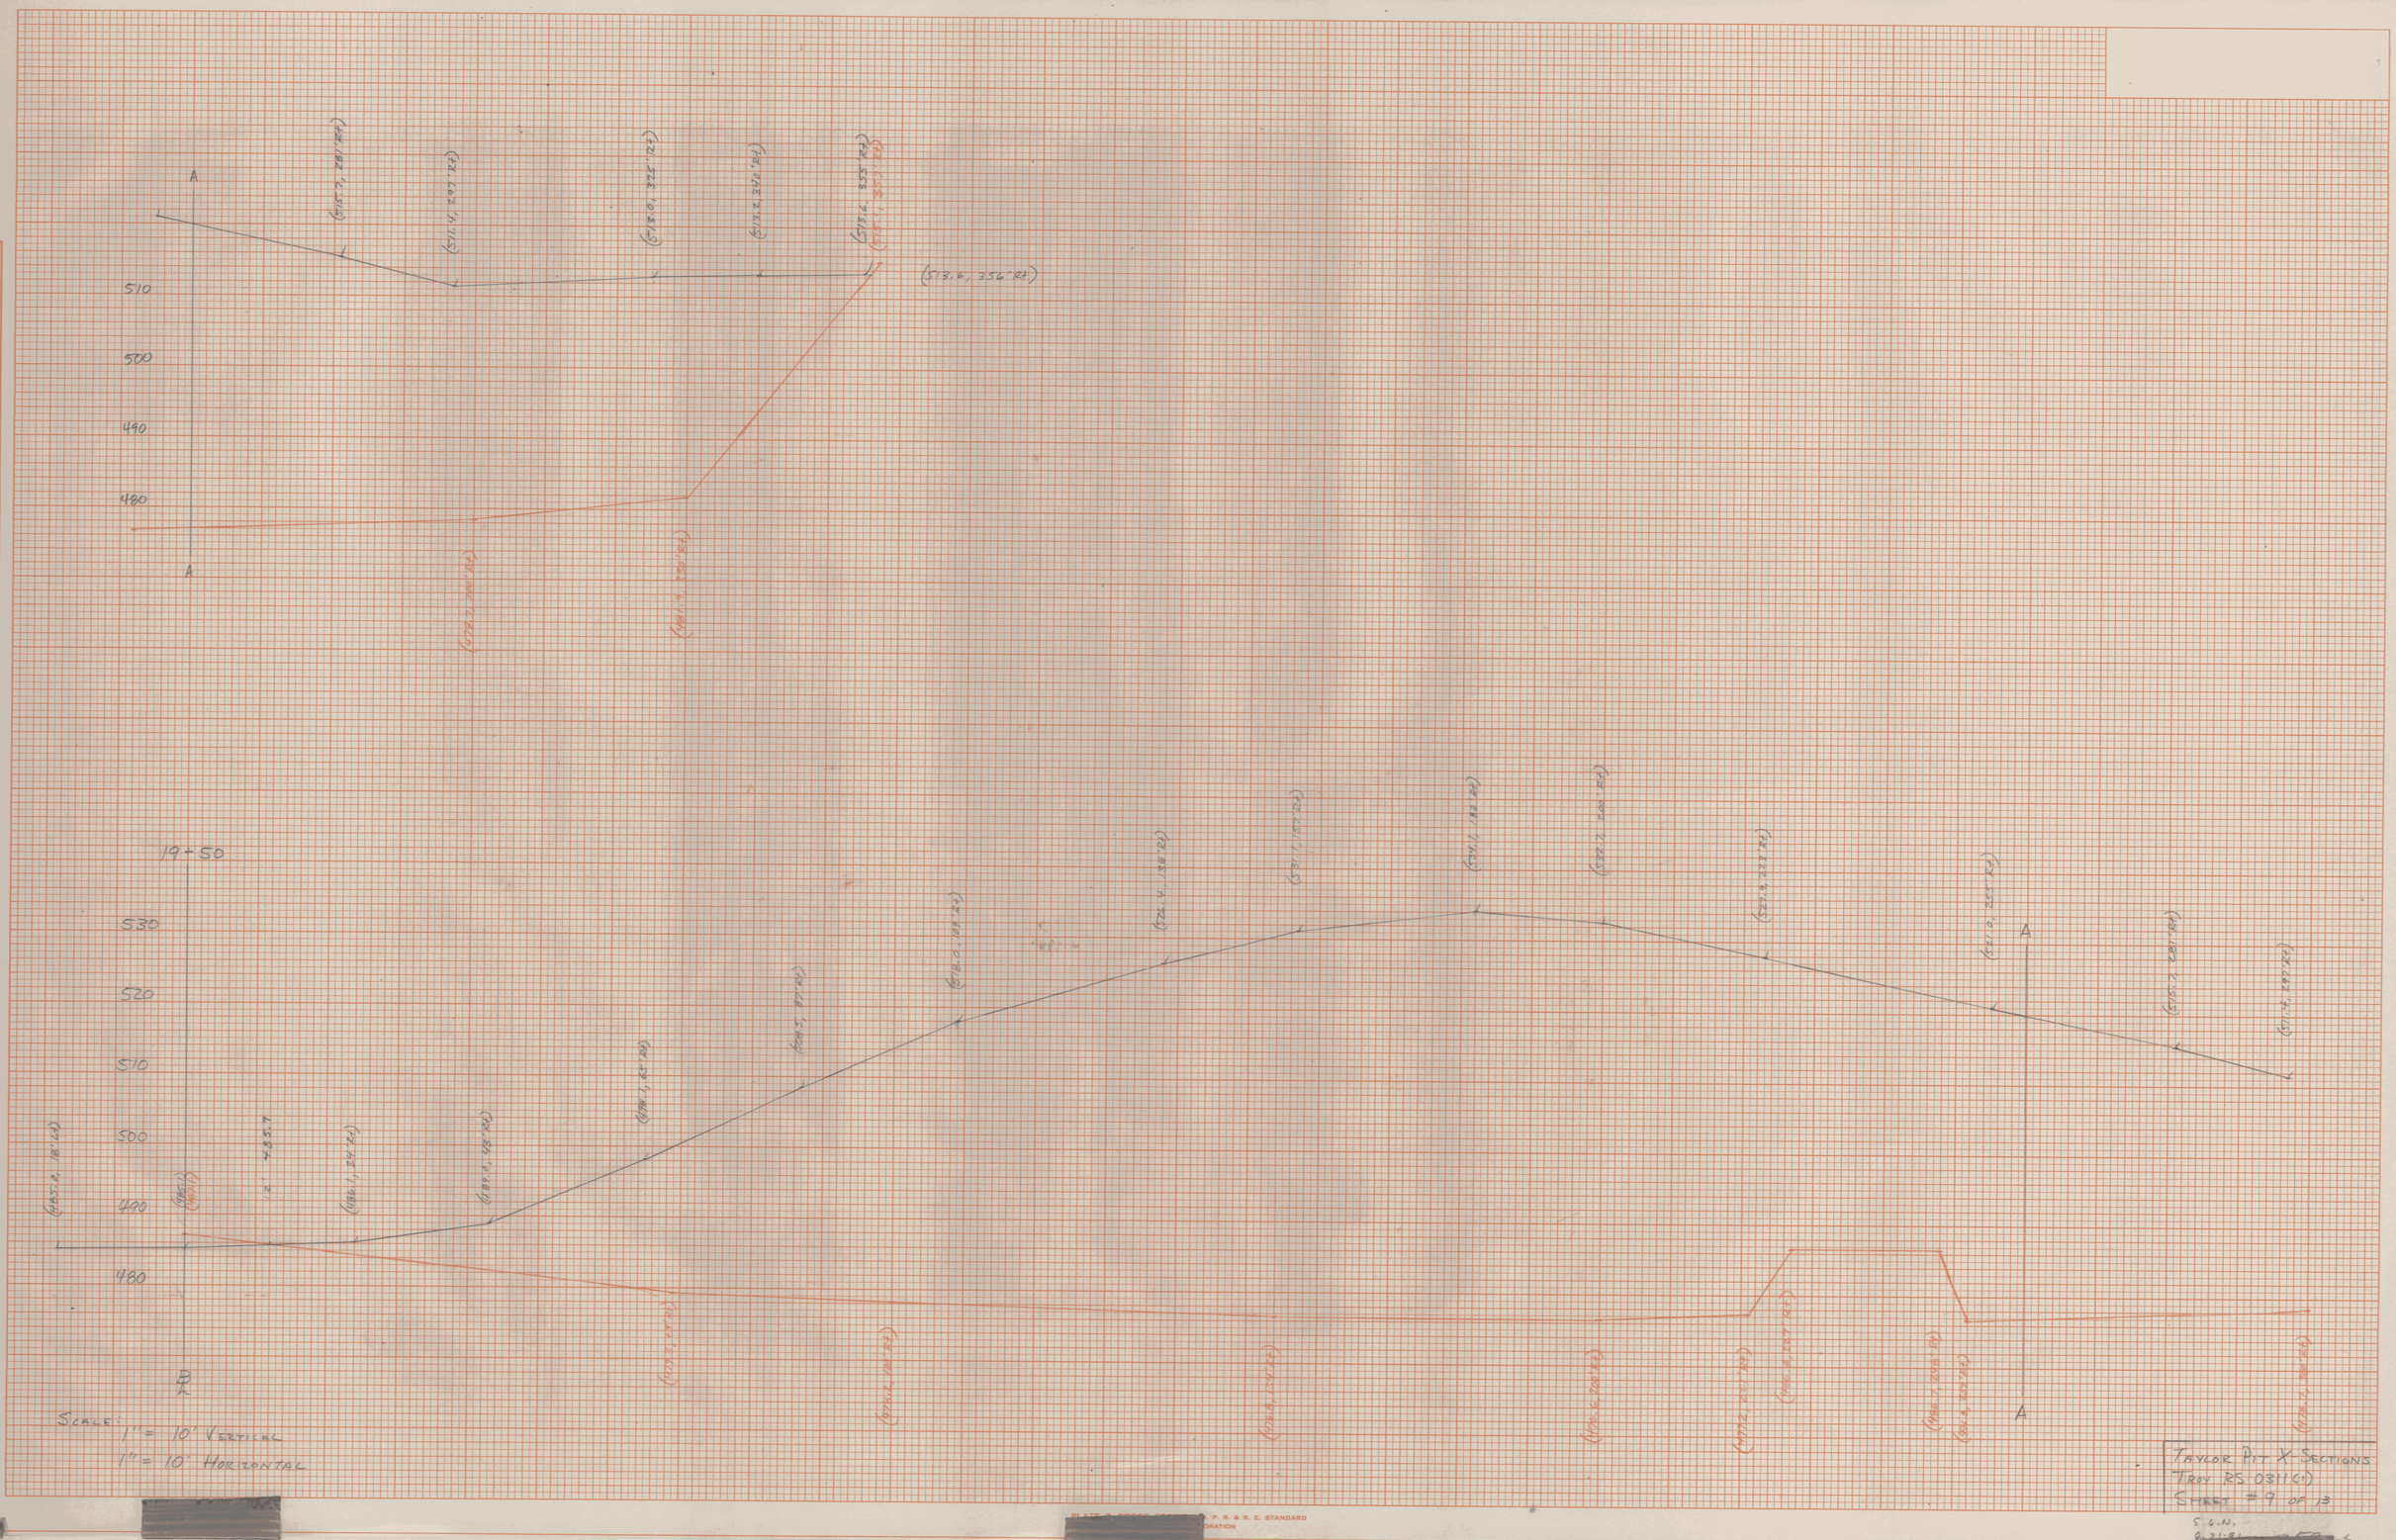
FINAL SURVEY
NOTE BOOK
No.
SURVEYED
PLOTTED
TEMPLATE
AREAS
AREAS CHECKED
BY
DATE
ORIGINAL SURVEY
NOTE BOOK
No.
SURVEYED
PLOTTED
TEMPLATE
AREAS
AREAS CHECKED
BY
DATE
A
510
500
490
480
A
(515.7, 281'RT)
(511.4, 297'RT)
(518.0, 324'RT)
(513.2, 340'RT)
(513.4, 355'RT)
(513.6, 356'RT)
(478.2, 398'RT)
(481.7, 390'RT)
19+50
530
520
510
500
490
480
B
(485.8, 18'RT)
(485.1, 19'RT)
1Z 485.7
(486.1, 24'RT)
(487.6, 42'RT)
(488.1, 62'RT)
(488.5, 87'RT)
(488.0, 109'RT)
(487.4, 128'RT)
(487.1, 157'RT)
(484.1, 182'RT)
(482.7, 208'RT)
(477.9, 222'RT)
(477.0, 252'RT)
A
(482.7, 281'RT)
(482.7, 297'RT)
(477.2, 297'RT)
(477.2, 280'RT)
(478.2, 280'RT)
(478.2, 280'RT)
A
SCALE:
1" = 10' VERTICAL
1" = 10' HORIZONTAL
TAYLOR PIT X SECTIONS
TROY RS 031161
SHEET #9 OF 13
S.G.N.
P. R. & R. E. STANDARD
ORATION