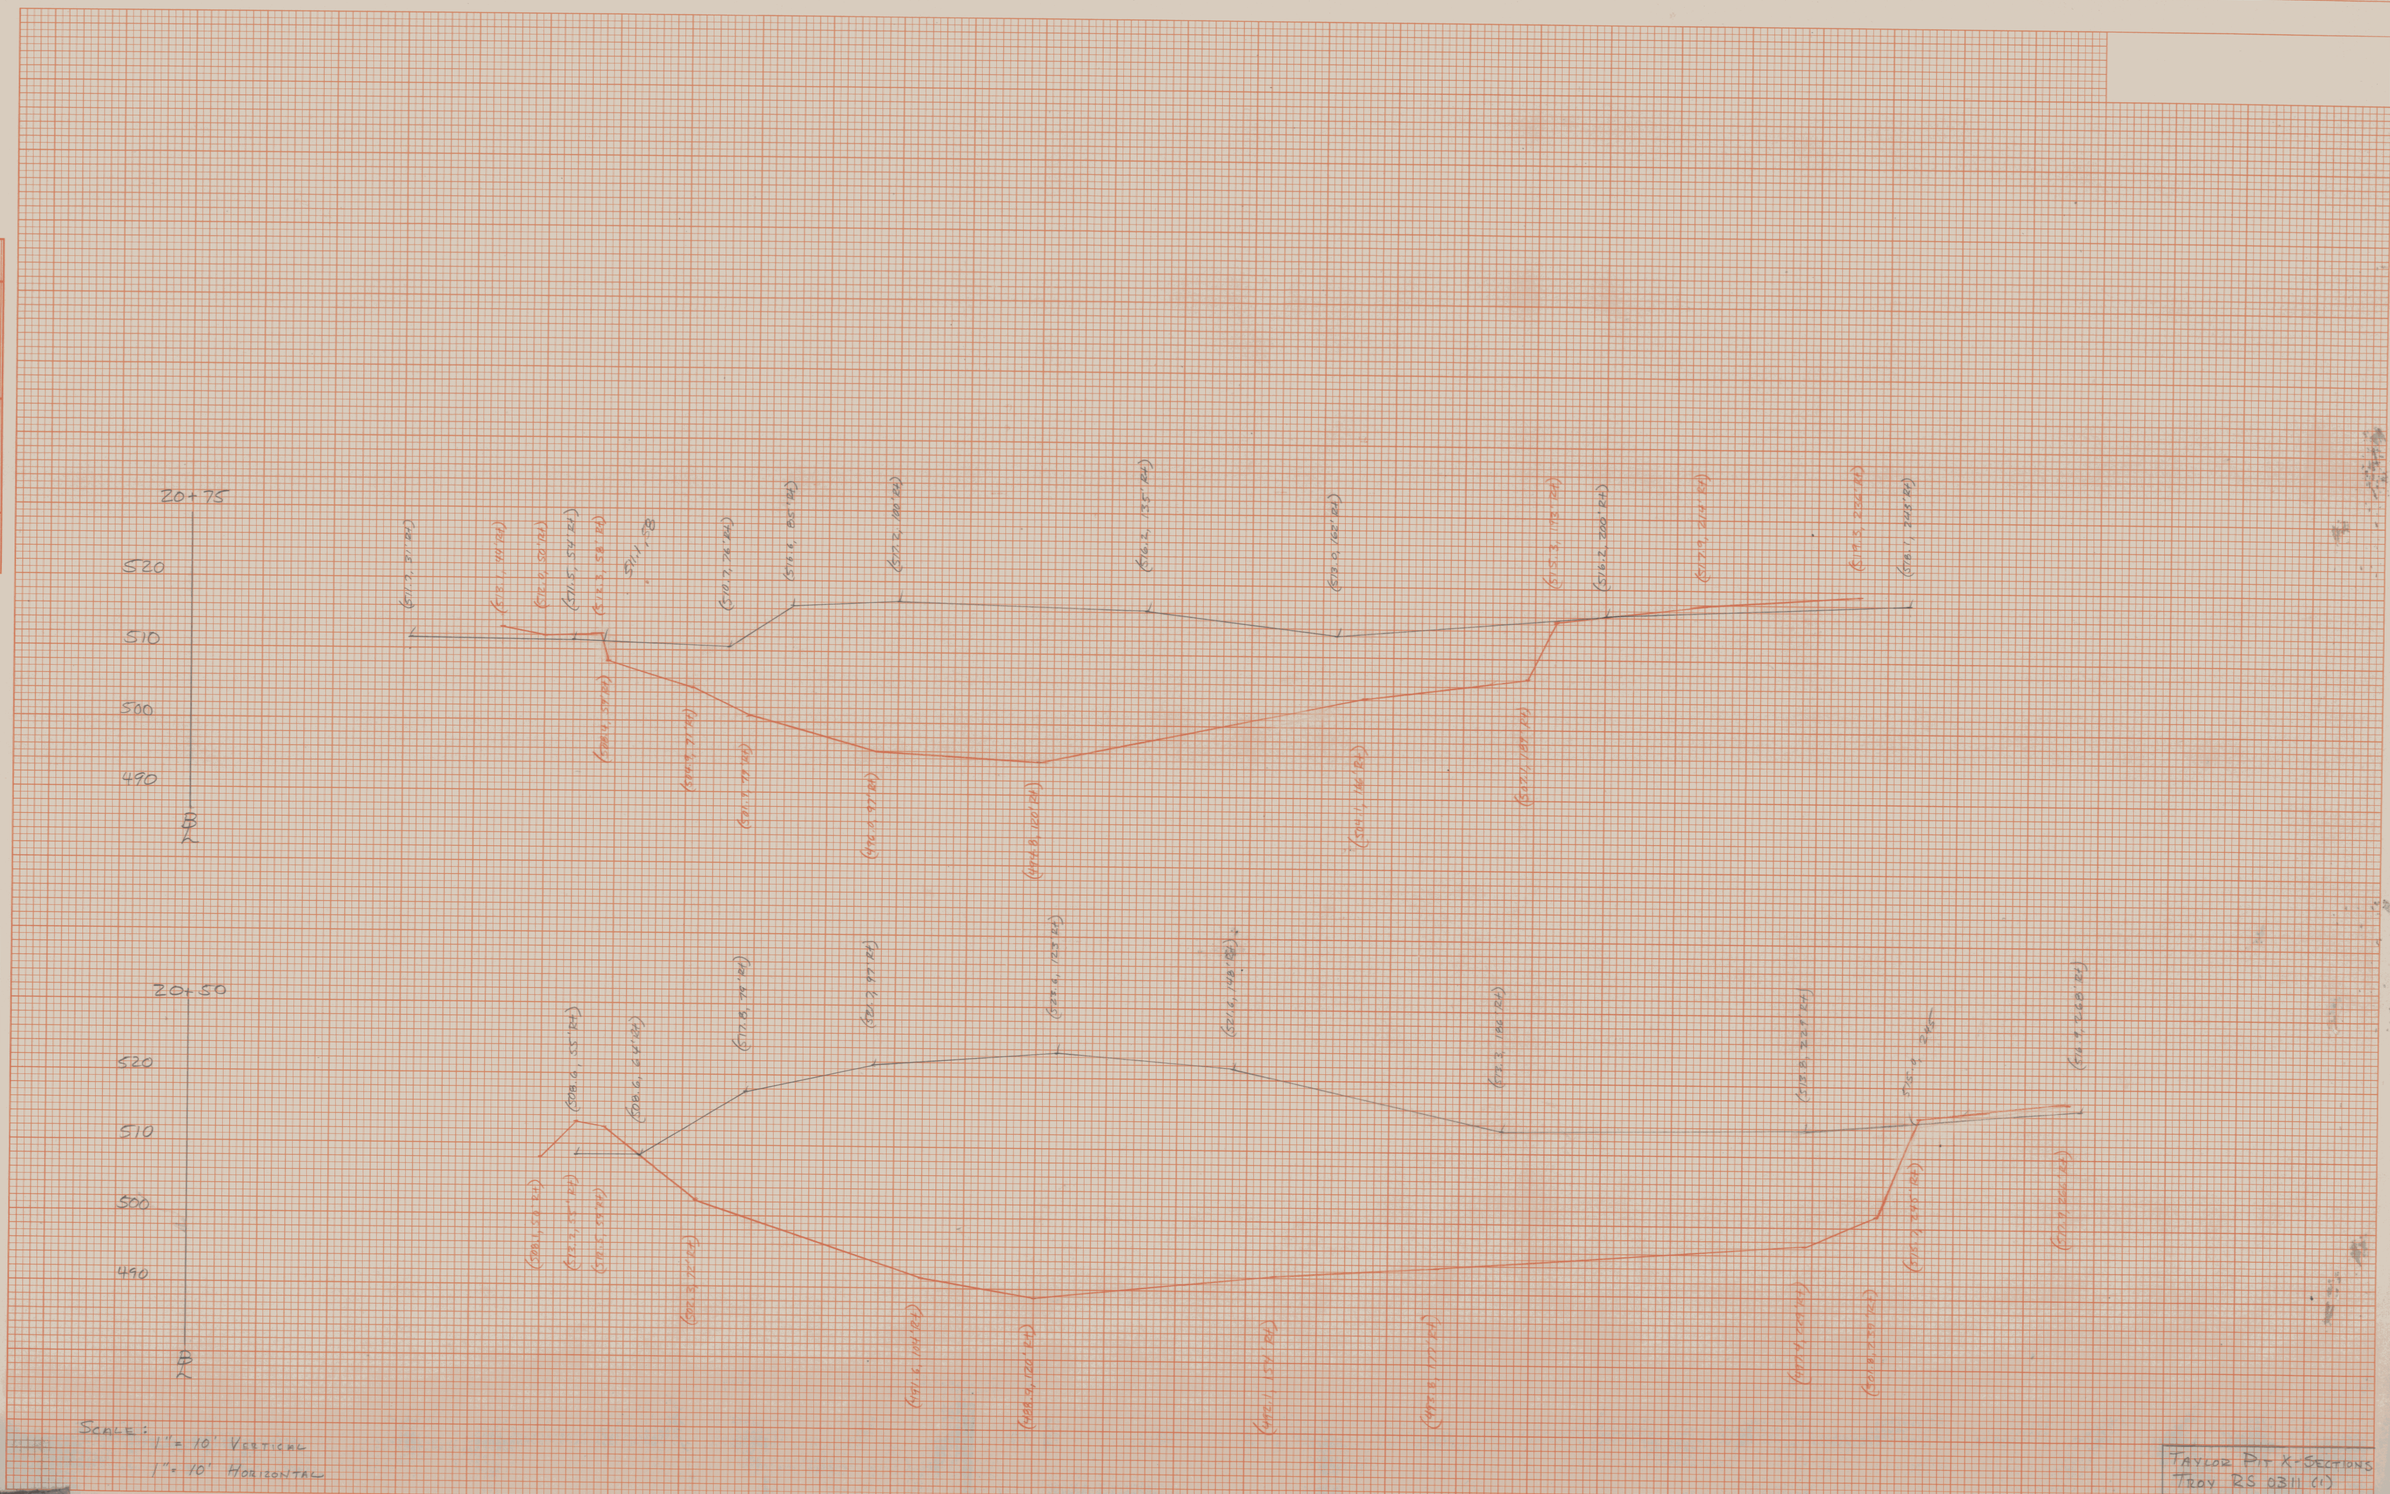
20+75
520
510
500
490
BL
(517.7, 74' RH)
(513.1, 119' RH)
(512.0, 52' RH)
(511.5, 57' RH)
(511.3, 58' RH)
511.1, 78
(510.7, 74' RH)
(516.4, 85' RH)
(517.2, 100' RH)
(516.2, 135' RH)
(518.0, 162' RH)
(515.3, 192' RH)
(516.2, 200' RH)
(517.9, 217' RH)
(519.5, 224' RH)
(518.1, 248' RH)
20+50
520
510
500
490
BL
(508.1, 57' RH)
(512.2, 54' RH)
(511.5, 53' RH)
(508.6, 55' RH)
(508.6, 80' RH)
(517.8, 74' RH)
(518.4, 97' RH)
(522.6, 121' RH)
(521.6, 148' RH)
(517.7, 188' RH)
(512.8, 223' RH)
(515.2, 241' RH)
(514.4, 248' RH)
(511.9, 266' RH)
(508.3, 72' RH)
(497.6, 101' RH)
(488.0, 120' RH)
(492.1, 151' RH)
(492.8, 171' RH)
(497.4, 201' RH)
(508.2, 219' RH)
SCALE:
1" = 10' VERTICAL
1" = 10' HORIZONTAL
TAYLOR PIT X-SECTIONS
TROY RS 0311 (1)
SHEET #12 of 13
S.G.N.
8-22-91
FINAL SURVEY
NOTE BOOK No.
SURVEYED
PLOTTED
TEMPLATE
AREAS
AREAS CHECKED
BY
DATE
ORIGINAL SURVEY
NOTE BOOK No.
SURVEYED
PLOTTED
TEMPLATE
AREAS
AREAS CHECKED
BY
DATE