FINAL SURVEY
NOTE BOOK
No.
SURVEYED
PLOTTED
TEMPLATE
AREAS
AREAS CHECKED
BY
DATE

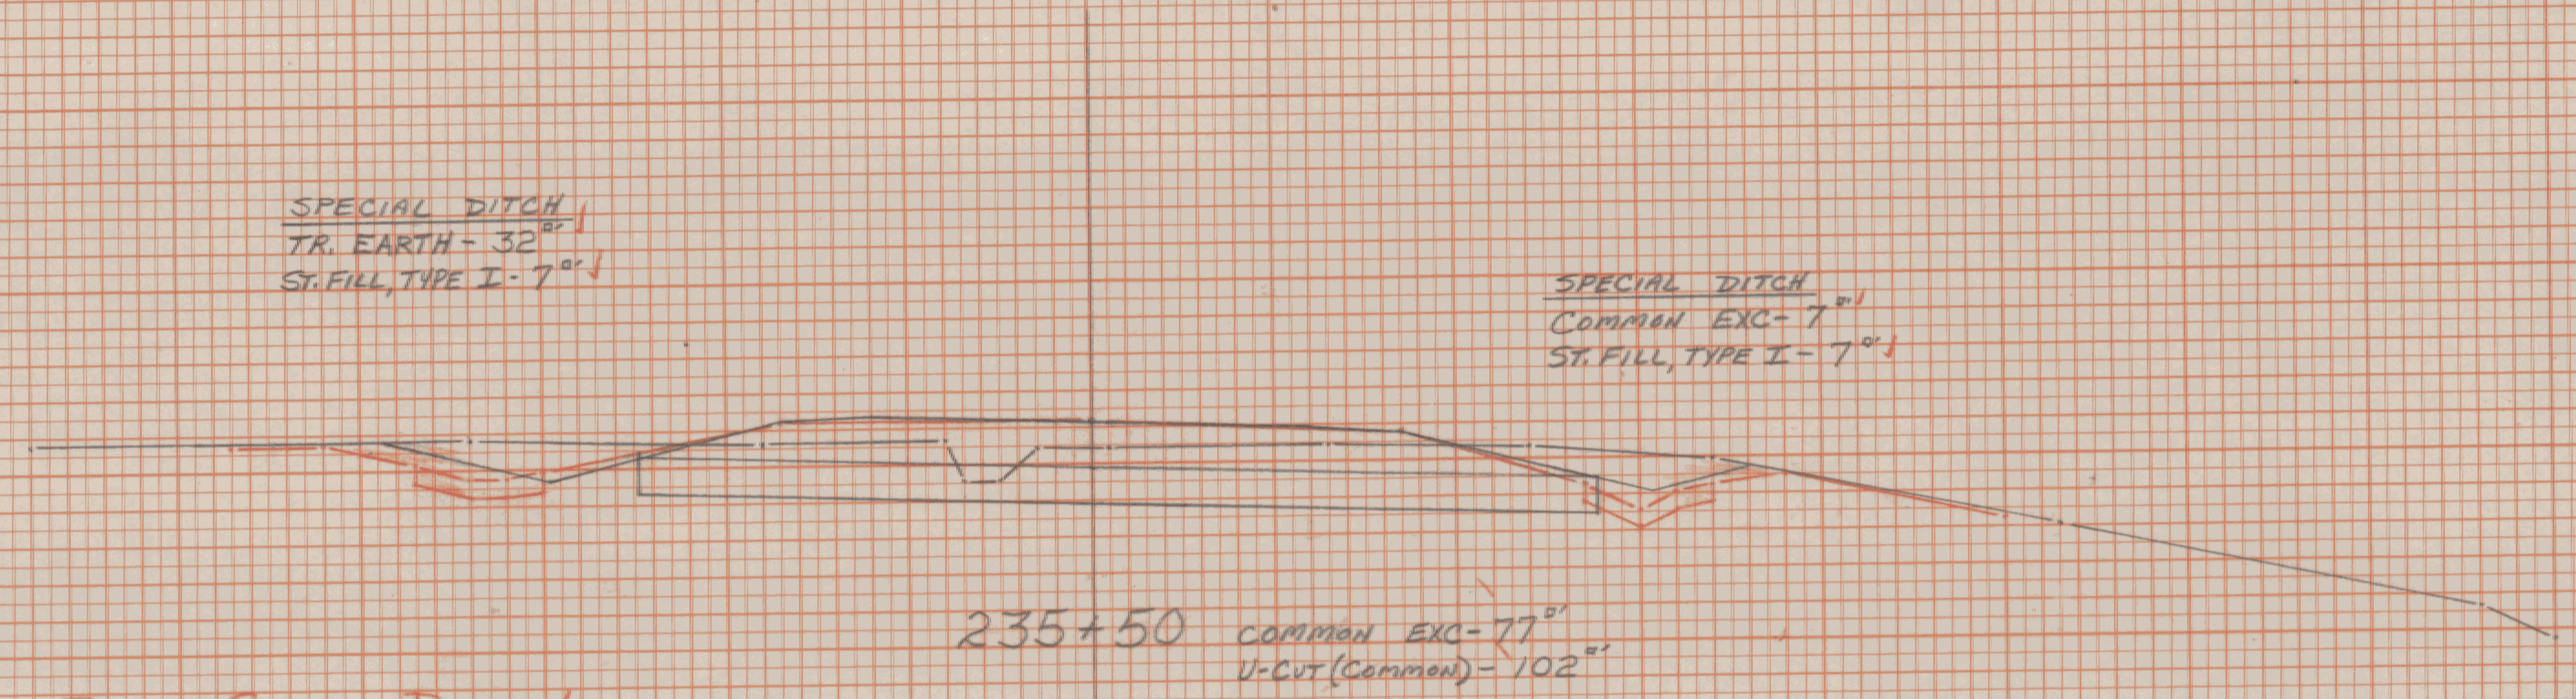
SPECIAL DITCH
TR. EARTH - 32⁰⁰ ✓
ST. FILL, TYPE I - 7⁰⁰ ✓
SPECIAL DITCH
COMMON EXC - 7⁰⁰ ✓
ST. FILL, TYPE I - 7⁰⁰ ✓
770
760
235+50
COMMON EXC - 77⁰⁰
U-CUT (COMMON) - 102⁰⁰

BEGIN SPECIAL DITCH LT.
W/STONE FILL, TYPE I
235+35 (BUTT)

END SPECIAL DITCH LT.
235+0 (BUTT)

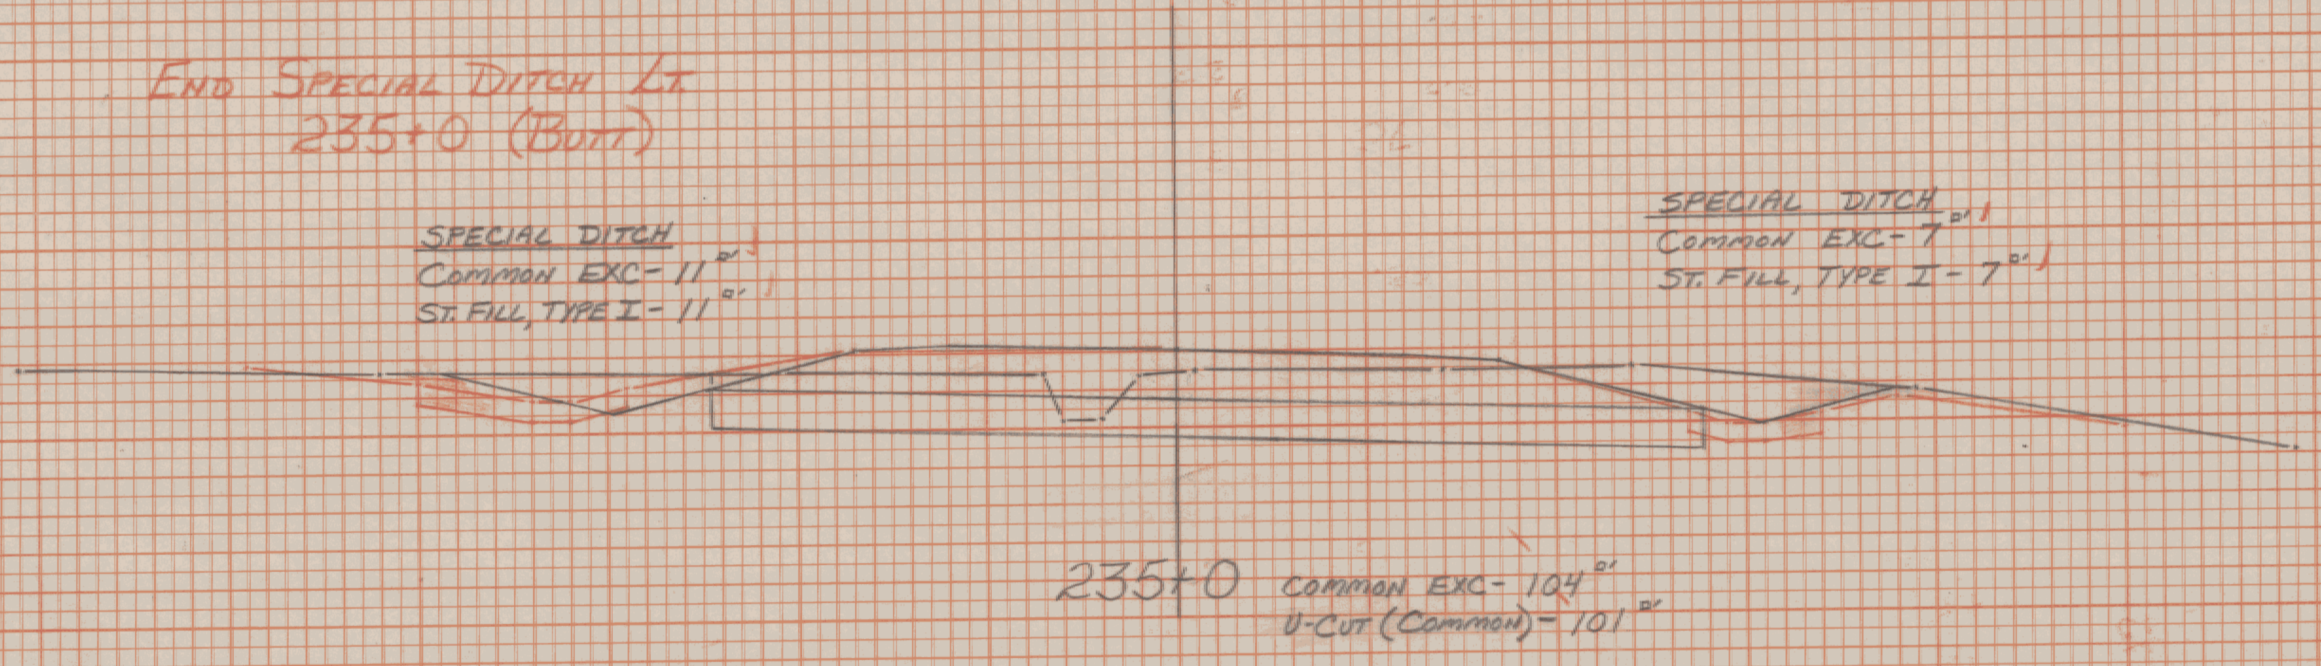
SPECIAL DITCH
COMMON EXC - 11⁰⁰ ✓
ST. FILL, TYPE I - 11⁰⁰ ✓
SPECIAL DITCH
COMMON EXC - 7⁰⁰ ✓
ST. FILL, TYPE I - 7⁰⁰ ✓
780
770
235+0
COMMON EXC - 104⁰⁰
U-CUT (COMMON) - 101⁰⁰

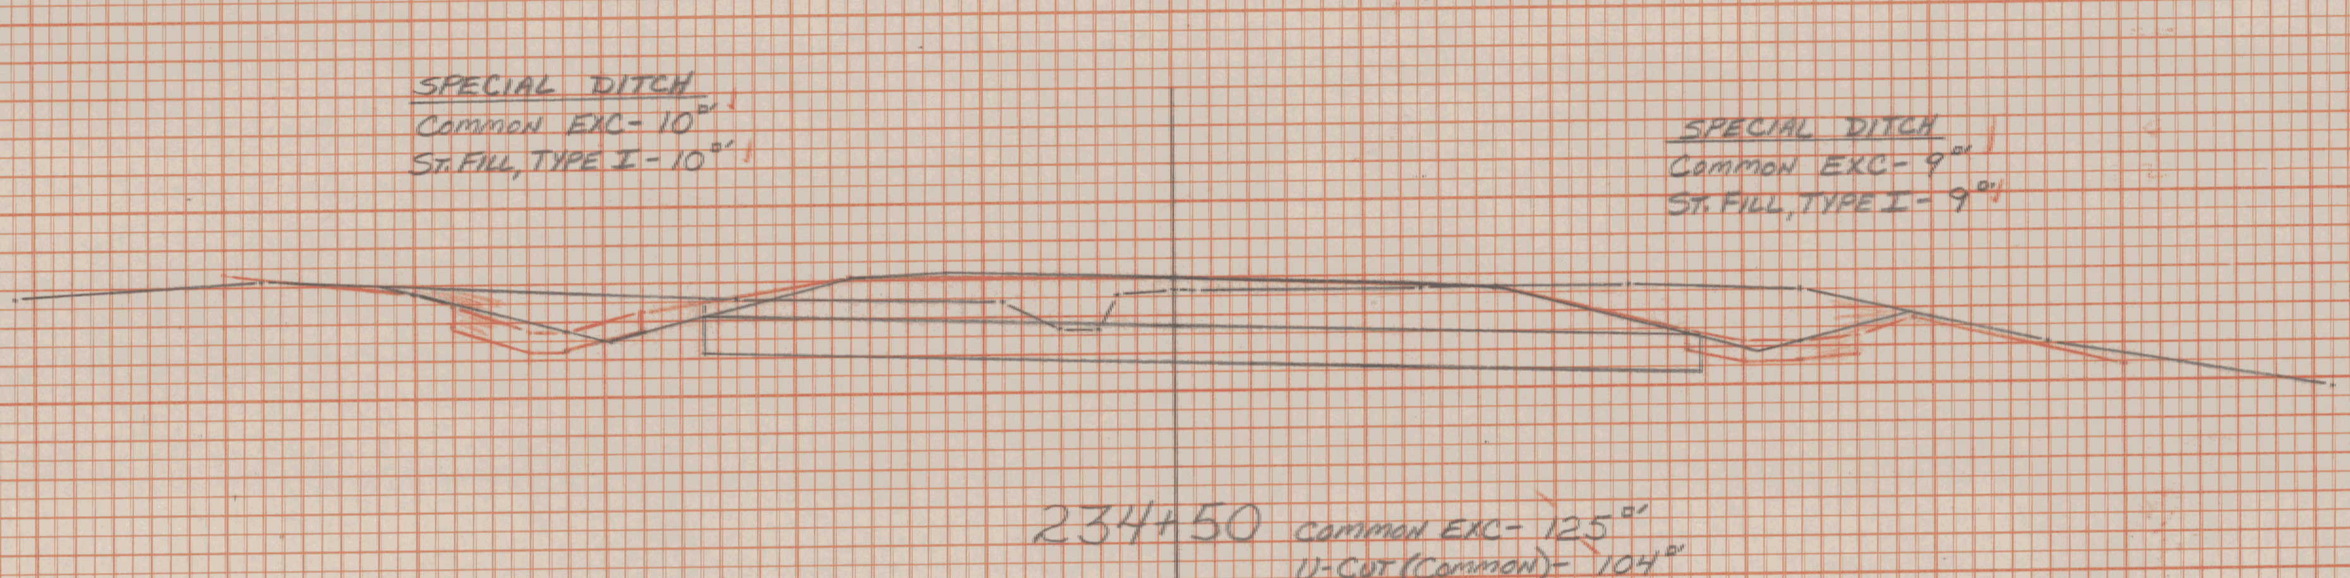
SPECIAL DITCH
COMMON EXC - 10⁰⁰ ✓
ST. FILL, TYPE I - 10⁰⁰ ✓
SPECIAL DITCH
COMMON EXC - 9⁰⁰ ✓
ST. FILL, TYPE I - 9⁰⁰ ✓
780
770
234+50
COMMON EXC - 125⁰⁰
U-CUT (COMMON) - 104⁰⁰

ORIGINAL SURVEY
NOTE BOOK
No.
SURVEYED
PLOTTED
TEMPLATE
AREAS
AREAS CHECKED
BY
DATE

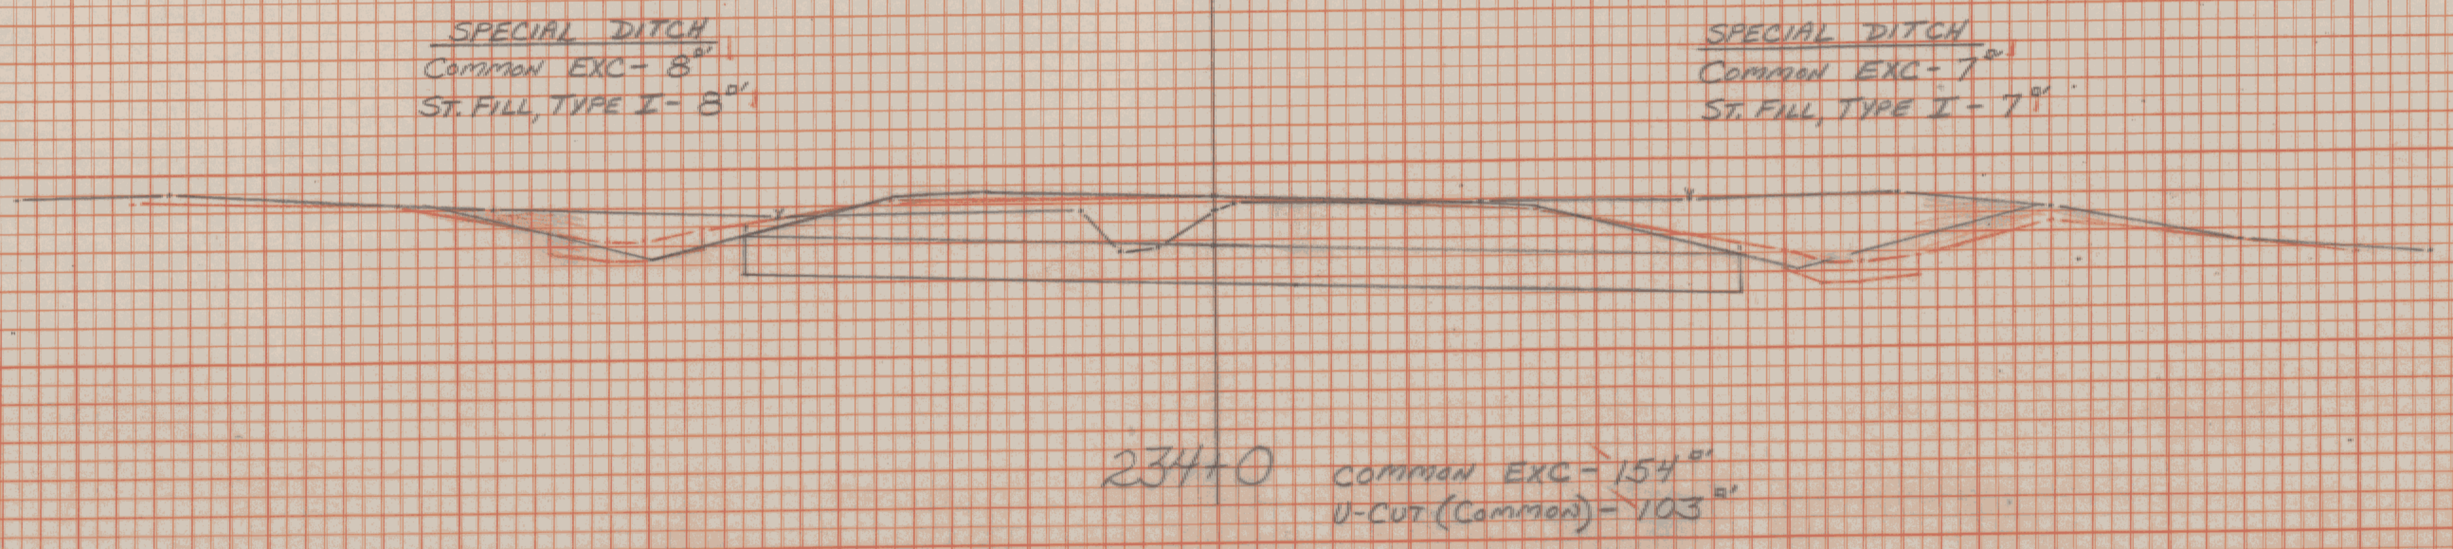
SPECIAL DITCH
COMMON EXC - 8⁰⁰
ST. FILL, TYPE I - 8⁰⁰
SPECIAL DITCH
COMMON EXC - 7⁰⁰
ST. FILL, TYPE I - 7⁰⁰
780
770
234+0
COMMON EXC - 154⁰⁰
U-CUT (COMMON) - 103⁰⁰

END SPECIAL DITCH LT.
237+50 (BUTT)

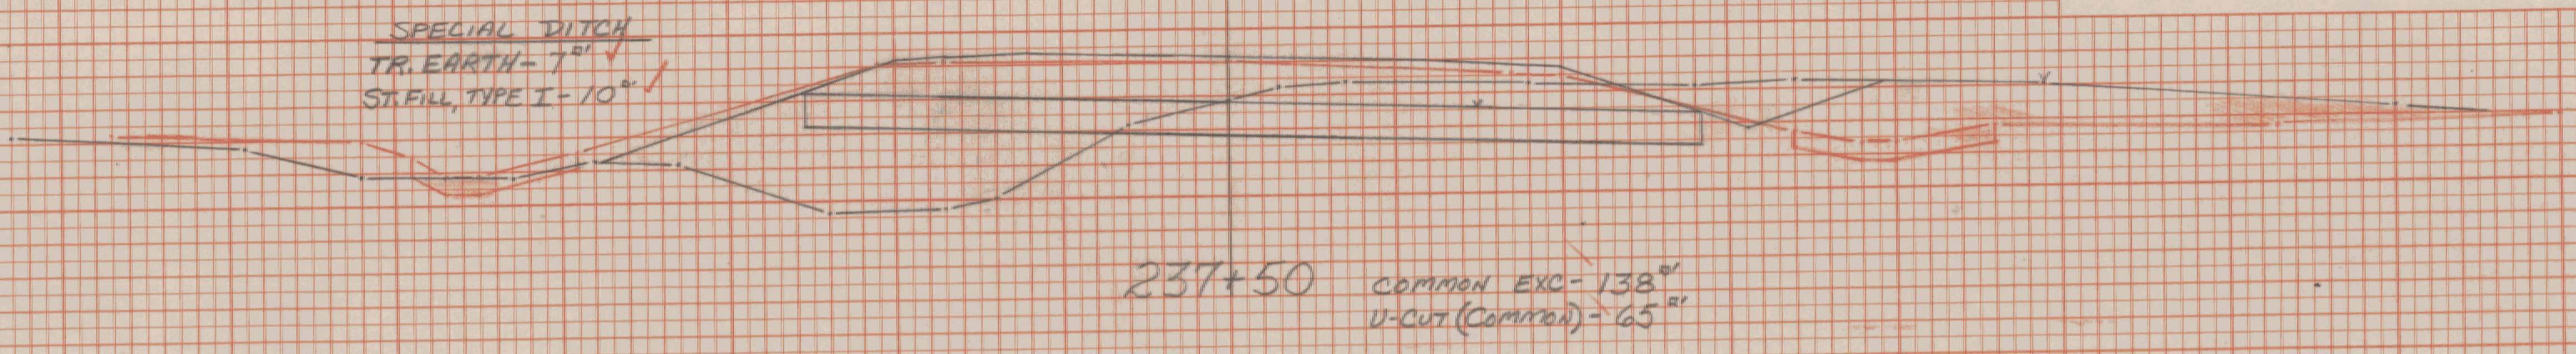
SPECIAL DITCH
TR. EARTH - 7⁰⁰ ✓
ST. FILL, TYPE I - 10⁰⁰ ✓
SPECIAL DITCH
COMMON EXC - 12⁰⁰ ✓
ST. FILL, TYPE I - 12⁰⁰ ✓
770
760
237+50
COMMON EXC - 138⁰⁰
U-CUT (COMMON) - 65⁰⁰

BEGIN SPECIAL DITCH RT.
W/STONE FILL, TYPE I
237+35 (BUTT)

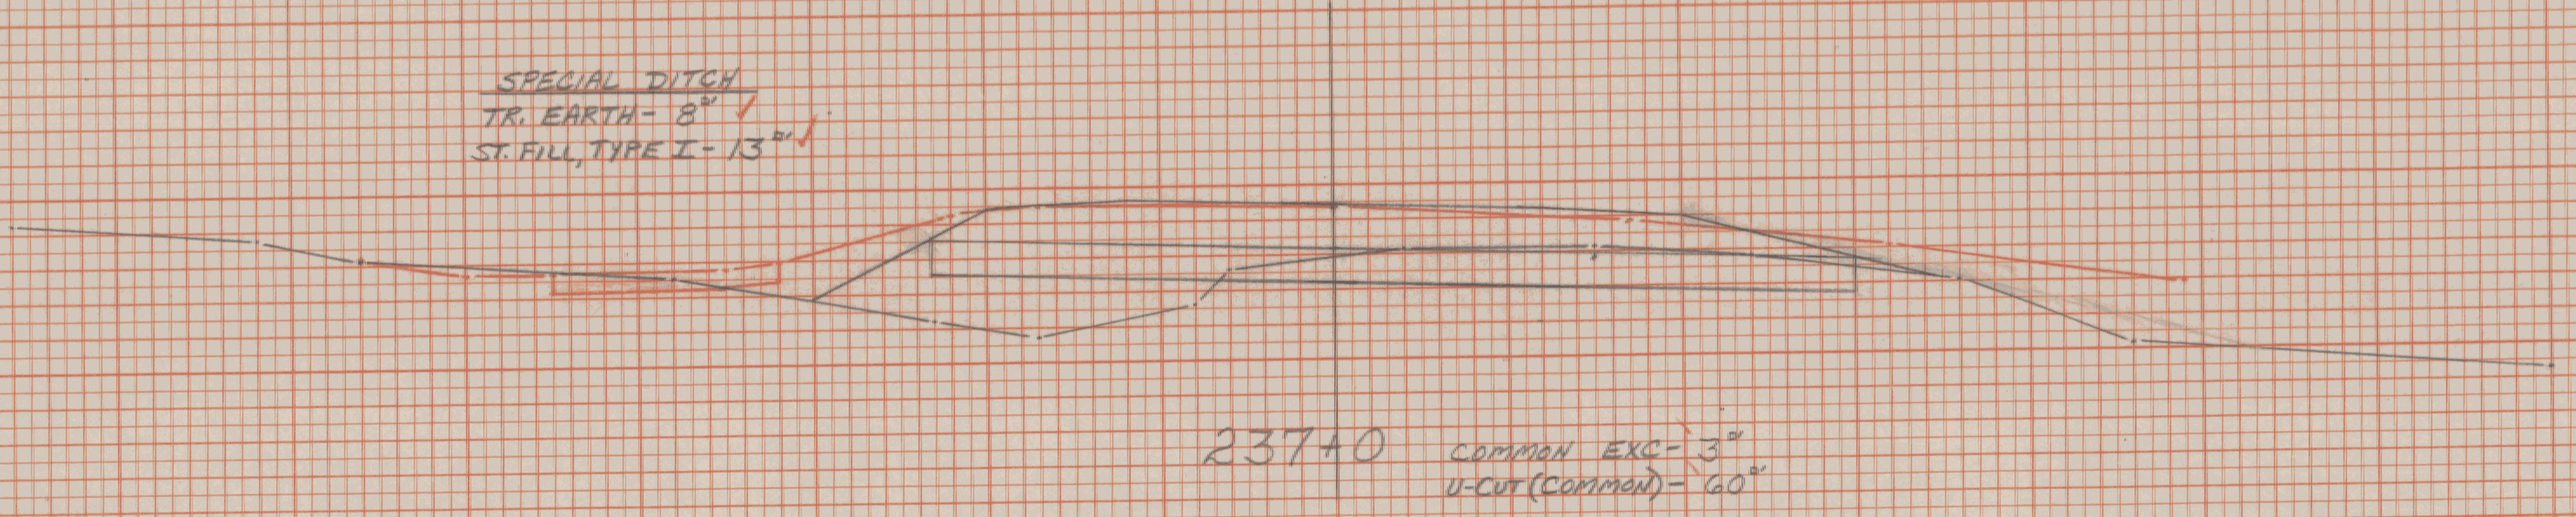
SPECIAL DITCH
TR. EARTH - 8⁰⁰ ✓
ST. FILL, TYPE I - 13⁰⁰ ✓
770
760
237+0
COMMON EXC - 3⁰⁰
U-CUT (COMMON) - 60⁰⁰

END SPECIAL DITCH RT.
236+75 (BUTT)

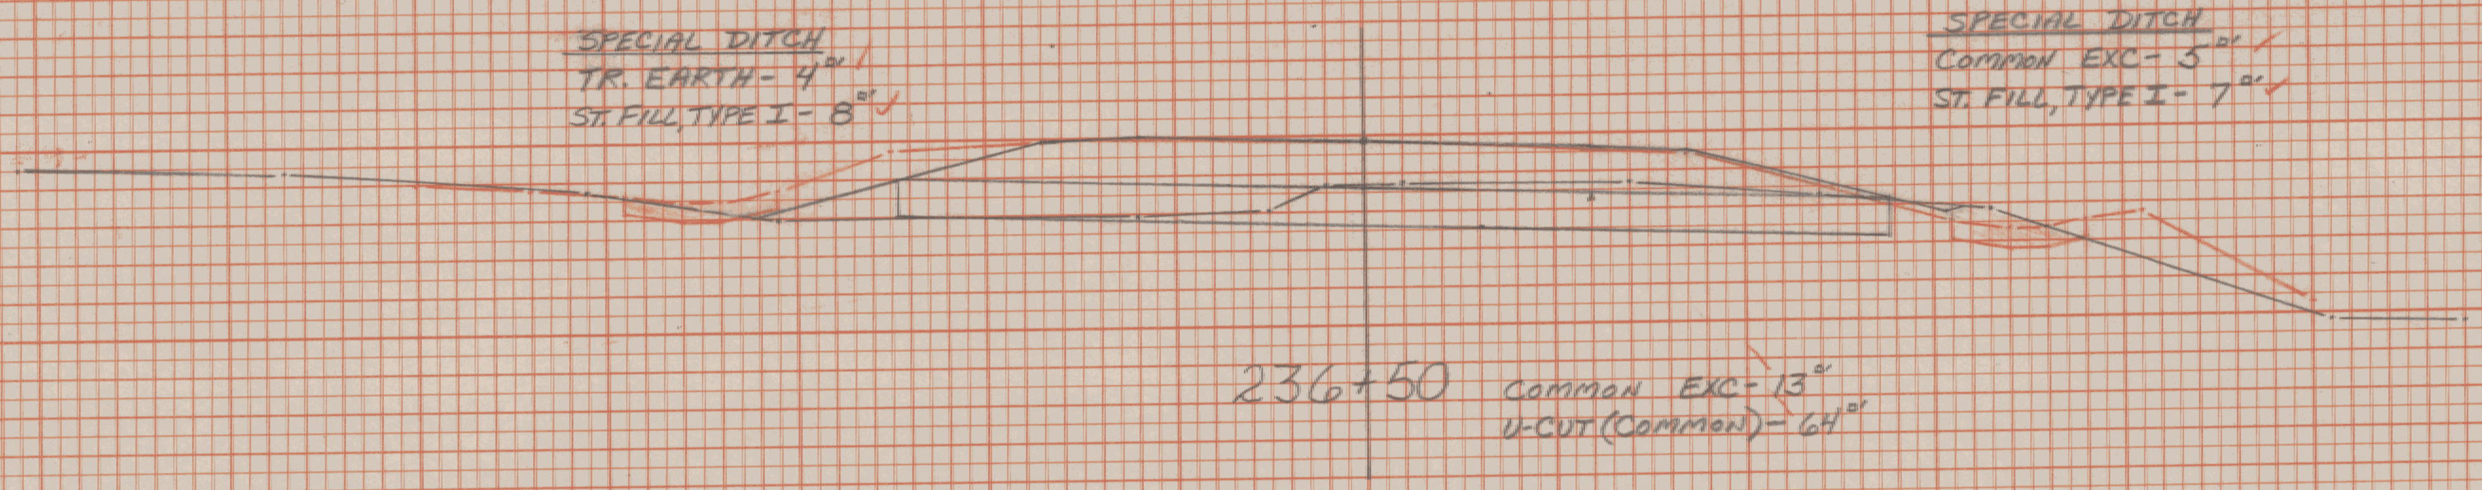
SPECIAL DITCH
TR. EARTH - 4⁰⁰ ✓
ST. FILL, TYPE I - 8⁰⁰ ✓
SPECIAL DITCH
COMMON EXC - 5⁰⁰ ✓
ST. FILL, TYPE I - 7⁰⁰ ✓
770
760
236+50
COMMON EXC - 13⁰⁰
U-CUT (COMMON) - 64⁰⁰

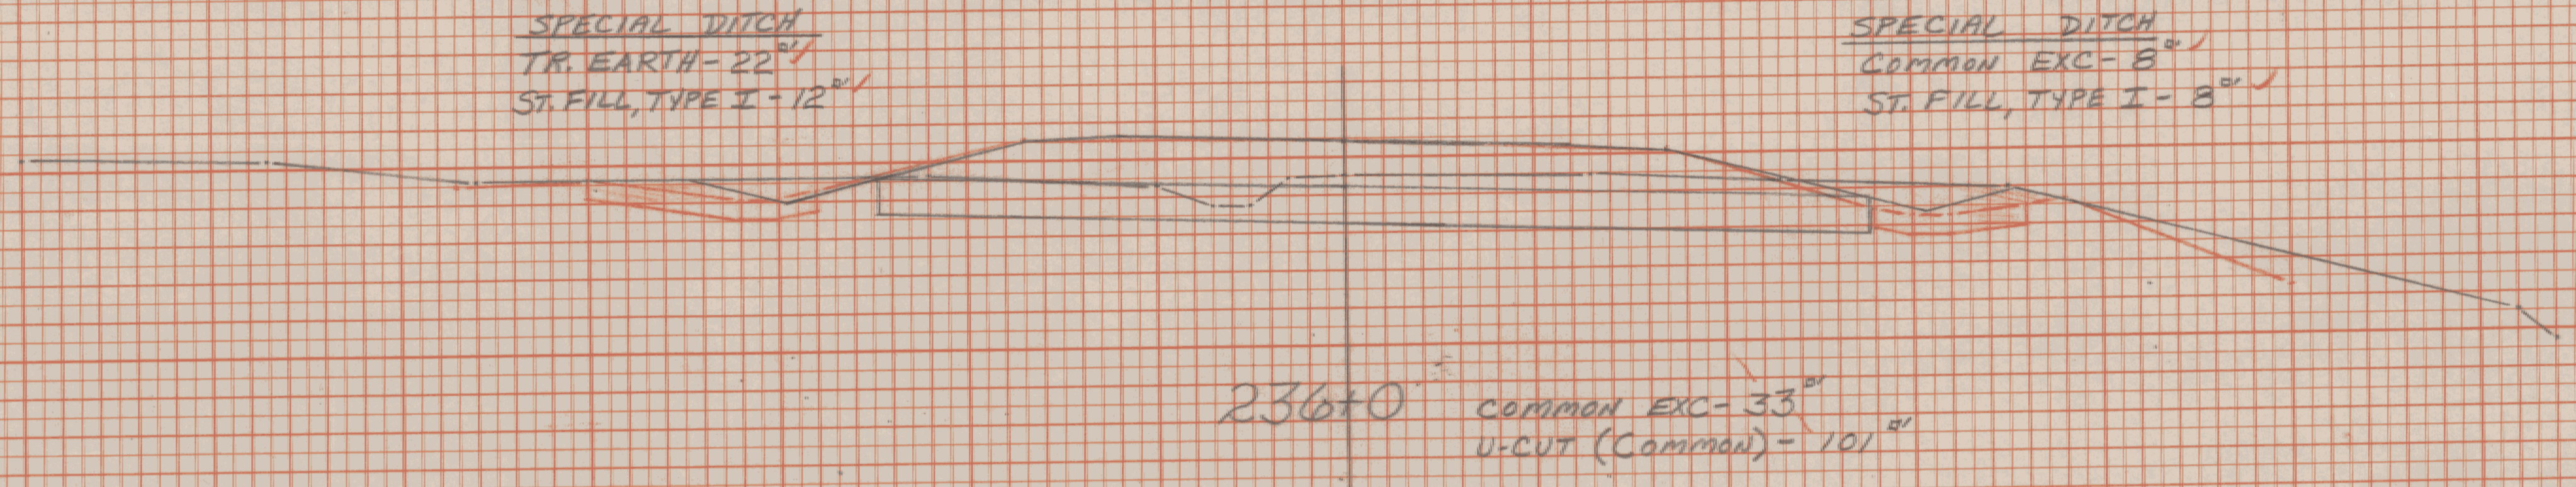
SPECIAL DITCH
TR. EARTH - 22⁰⁰ ✓
ST. FILL, TYPE I - 12⁰⁰ ✓
SPECIAL DITCH
COMMON EXC - 8⁰⁰ ✓
ST. FILL, TYPE I - 8⁰⁰ ✓
770
760
236+0
COMMON EXC - 33⁰⁰
U-CUT (COMMON) - 101⁰⁰

TROY RS 0311(1)
REVISED SECTIONS
234+0 ~ 237+50

PLATE 3 CROSS SECTION O. P. R. & R. E. STANDARD
DIETZGEN CORPORATION

Pld - 3-31-92 D&B

TEMPLATED 12-16-91 LEM
PLOTTED 12-17-91 LEM
PLANIMETERED 1-22-92 LEM

SHEET 8 of 18

278 REV