


DATE
BY
SUBMITTED
PLOTTED
BY
AREAS CHECKED
FINAL SURVEY NOTE BOOK No.

DATE
BY
SUBMITTED
PLOTTED
BY
AREAS CHECKED
ORIGINAL SURVEY NOTE BOOK No.

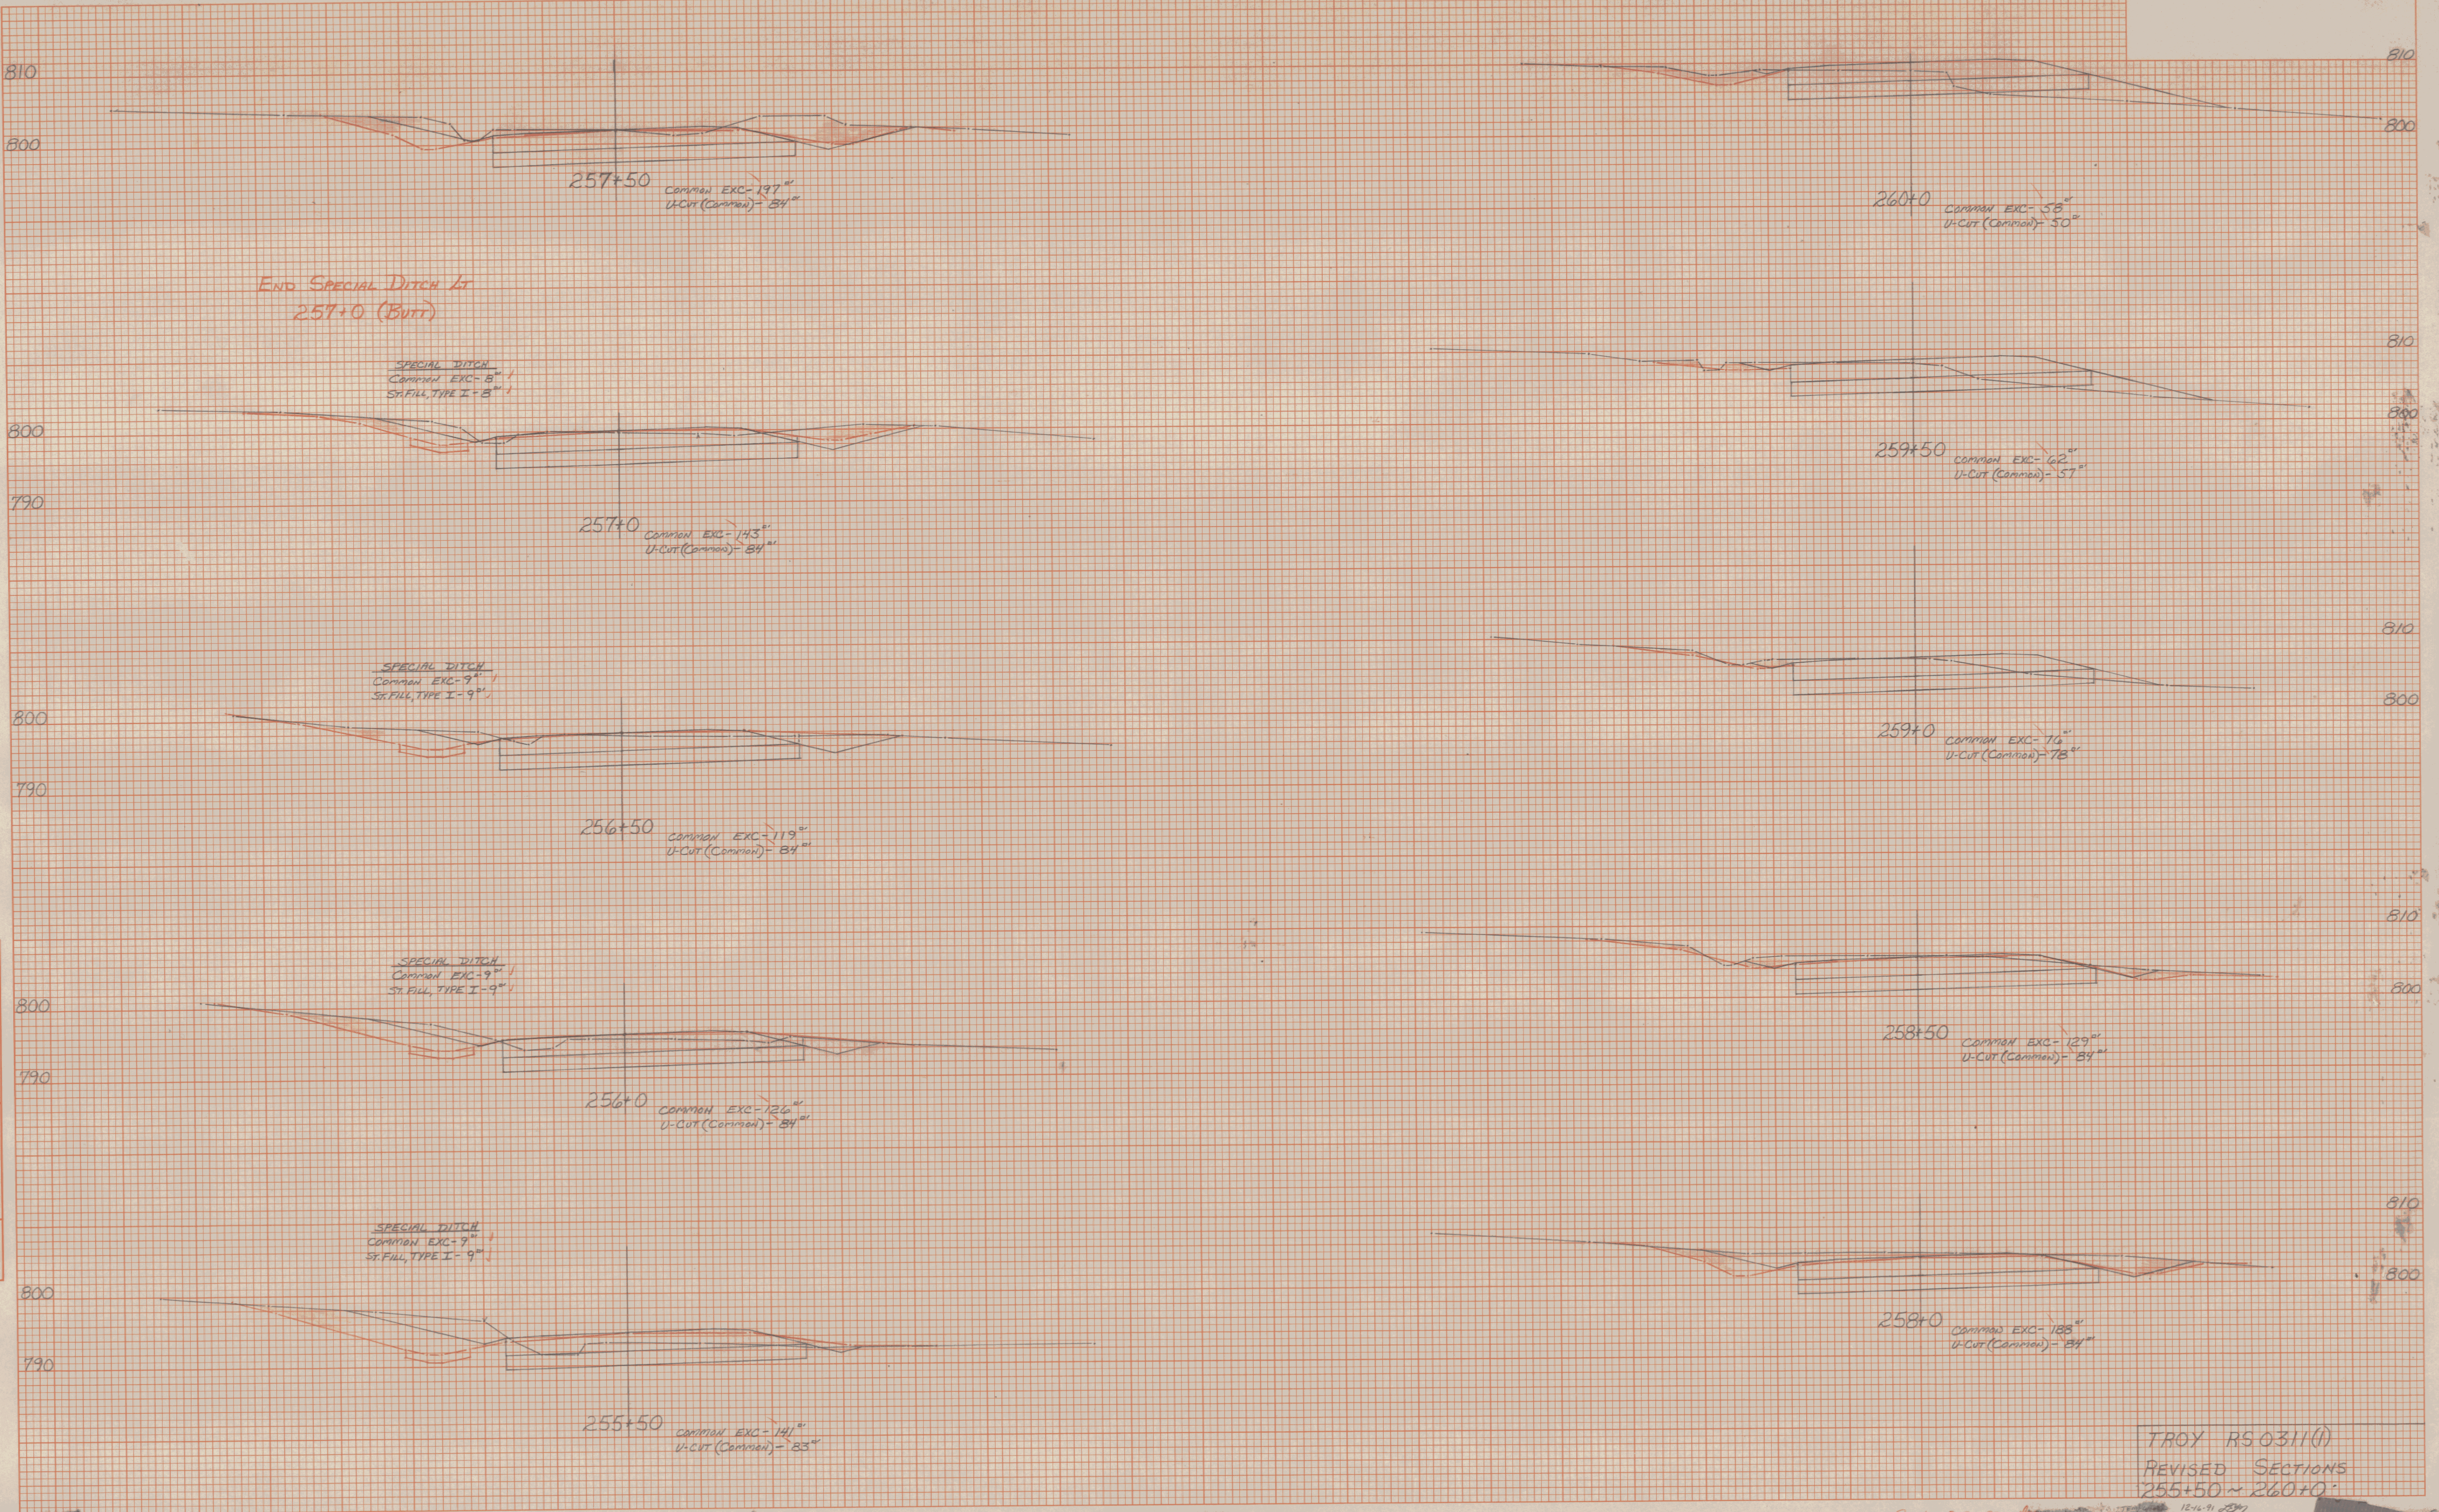

TROY RS 0311(1)
REVISED SECTIONS
255+50 ~ 260+0

12-11-91
12-17-91
1-24-92

