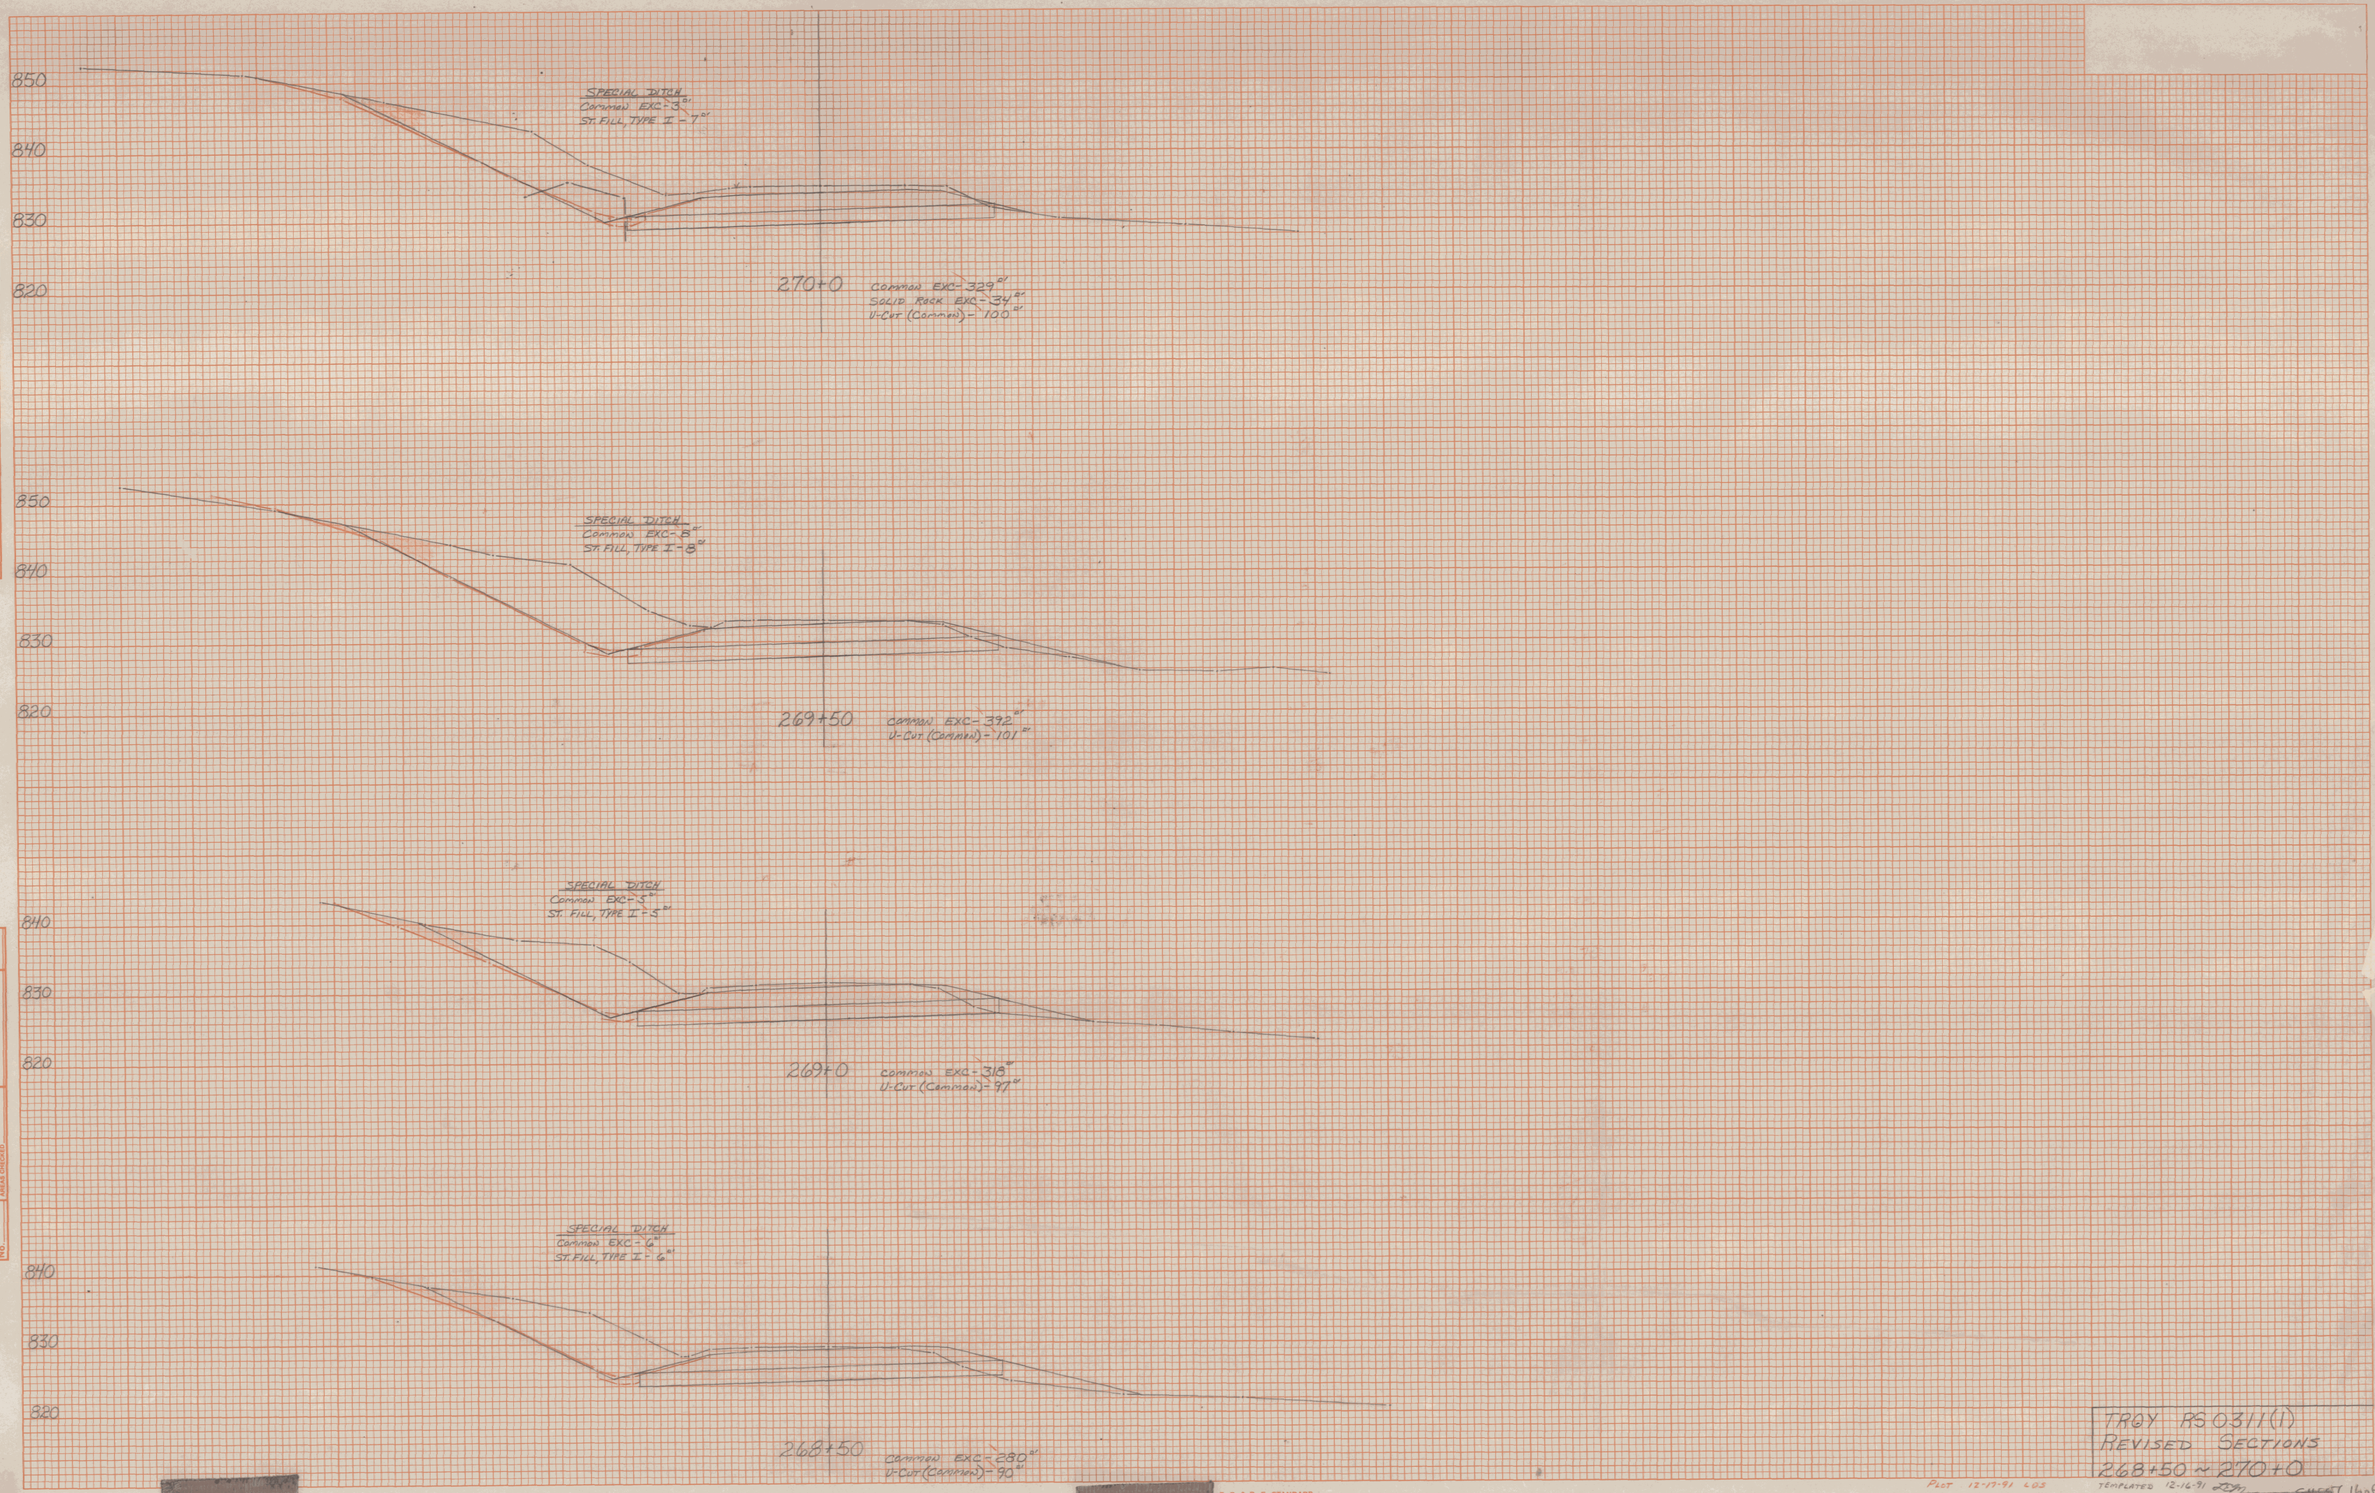

FINAL SURVEY NOTE BOOK No.
SURVEYED
PLOTTED
TEMPLATE
AREAS
AREAS CHECKED
BY
DATE

ORIGINAL SURVEY NOTE BOOK No.
SURVEYED
PLOTTED
TEMPLATE
AREAS
AREAS CHECKED
BY
DATE

TROY RS 0311(1)
REVISED SECTIONS
268+50 ~ 270+0

P. R. & R. E. STANDARD
ORATION

PLOT 12-17-91 LDS
PLAN 4-1-92 LDS
TEMPLATED 12-16-91
PLANIMETERED [redacted]
SHEET 16 of 18