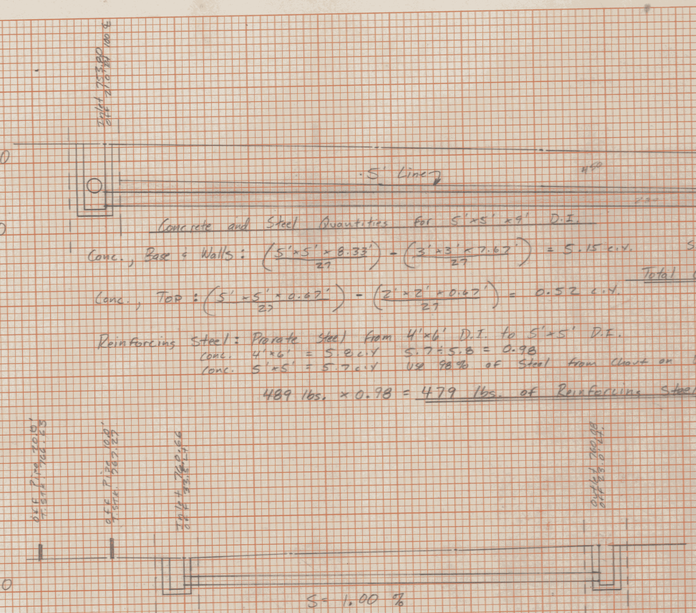

Concrete and Steel Quantities for 5'x5'x4' D.I.

Conc., Base & Walls: $\left(\frac{5'\times5'\times8.33'}{27}\right) - \left(\frac{3'\times3'\times7.67'}{27}\right) = 5.15$ c.y.

Conc., Top: $\left(\frac{5'\times5'\times0.67'}{27}\right) - \left(\frac{2'\times2'\times0.67'}{27}\right) = 0.52$ c.y.

Total Conc. Class B = 5.7 c.y.

Reinforcing Steel: Prorate Steel from 4'x6' D.I. to 5'x5' D.I.
Conc. 4'x6' = 5.2 c.y. 5.7 ÷ 5.2 = 0.98
Conc. 5'x5' = 5.7 c.y. Use 98% of Steel from Chart on D-6.

489 lbs. x 0.98 = 479 lbs. of Reinforcing Steel

S.G.N. 11-1-91

110+20 ~ 110+78 Lt. (DS196)
15" x 58' CSP (.064)
w/ RCDI @ Inlet
Book 25 Page 86

Trench Earth
Pipe 0'-5' = 243# x 3.8' x 1/27 = 29.7 c.y.
D.I. 0'-5' = 6'x6'x5' x 1/27 = 6.7 c.y.
Total Trench Earth = 36.4 c.y.
S.G.N. 7-25-91

S= 1.94 %

107+72 ~ 110+70 Rt. (DS195)
24" x 240' RCP Cl. III
w/RCDI @ Inlet
(Lalibarty's Drive Pipe)
Book 25 Page 82

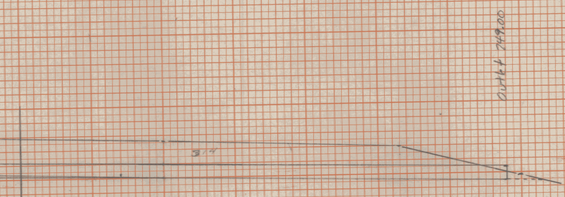

Trench Earth
Pipe 0'-5' = 1150# x 4.5' x 1/27 = 198.3 c.y.
Pipe over 5' = 347# x 4.5' x 1.5 = 1/27 = 86.8 c.y.
D.I. 0'-5' = 7'x7'x5' x 1/27 = 9.1 c.y.
D.I. over 5' = 7'x7'x5' x 1.5 x 1/27 = 13.6 c.y.
Total Trench Earth = 307.8 c.y.

Subbase of Gravel
200' x 1.5' x 4.5' x 1/27 = 50.0 c.y.
S.G.N. 7-25-91
To DI #96

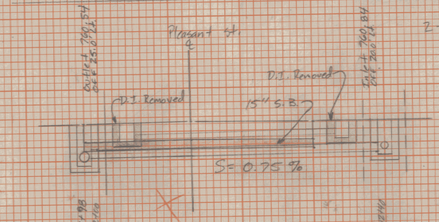

111+99 ~ 112+39 Lt.
15" - 40' CSP (.064)
w/ RCDI @ Inlet
(DS197)
Book 25 Page 90

Trench Rock
2 D.I's = 4'x4'x3'x2' x 1/27 = 3.6 c.y.
2 D.I's and Pipe in Same Trench.
D.I. in Road Way Lack Shoulder

Trench Earth
Pipe 0'-5' = 61# x 3.8' x 1/27 = 7.5 c.y.
D.I. 0'-5' = 6'x6'x5' x 1/27 = 6.7 c.y.
D.I. over 5' = 6'x6' x 0.75' x 1.5 x 1/27 = 1.5 c.y.
15.7' (T.E.) - 1.8 (1 D.I.) = 13.9 c.y. Total T.E.
S.G.N. 7-31-91

For Pleasant St. System See Drainage Sheet #36

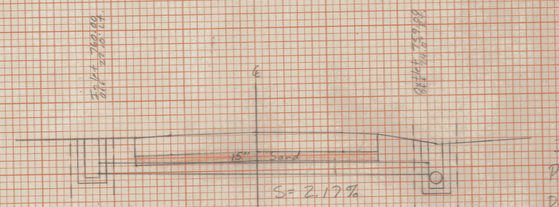

110+90 ℄ (DS193)
18" x 46' RCP Cl. III
W/RCDI @ Inlet
Book 25 Page 74

Trench Earth
Pipe 0'-5' = 92# x 3.9' x 1/27 = 13.4 c.y.
D.I. 0'-5' = 6'x6'x5' x 1/27 = 6.7 c.y.
D.I. over 5' = 6'x6'x1'x1.5 x 1/27 = 2.0 c.y.
Total Trench Earth = 22.1 c.y.
S.G.N. 7-22-91

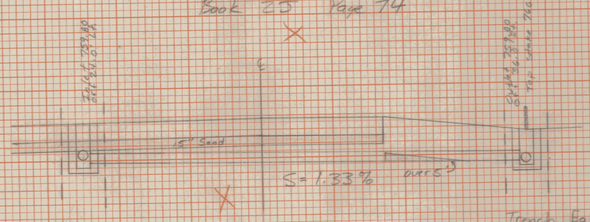

111+28 Rt. ~ 111+98 Lt.
18" x 60" RCP Cl. III
W/RCDI @ Inlet (DS191)
Drawn Askew
Book 25 Page 66

Trench Earth
Pipe 0'-5' = 172# x 3.9' x 1/27 = 24.8 c.y.
Pipe over 5' = 5# x 3.9' x 1.5 x 1/27 = 1.1 c.y.
D.I. 0'-5' = 6'x6'x3' x 1/27 = 4.0 c.y.
Total Trench Earth = 29.9 c.y.
S.G.N. 7-22-91

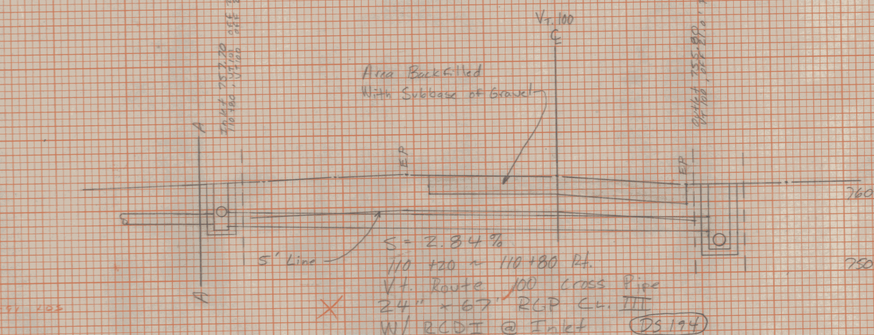

110+20 ~ 110+80 Rt.
V.t. Route 100 Cross Pipe
24" x 67' RCP Cl. III
W/ RCDI @ Inlet (DS194)
Book 25 Page 78

Gravel
36'x 2.5'x 6' x 1/27 = 20.0 c.y.
SEE BK. 1 PG. 76

Trench Earth
Pipe 0'-5' = 315# x 4.5' x 1/27 = 52.5 c.y.
Pipe over 5' = 142# x 4.5' x 1.5 x 1/27 = 35.5 c.y.
D.I. 0'-5' = 6'-6' x 5' x 1/27 = 6.7 c.y.
D.I. over 5' = 6' x 6' x 2' x 1.5 x 1/27 = 4.0 c.y.
Total Trench Earth = 98.7 c.y.
S.G.N. 7-23-91

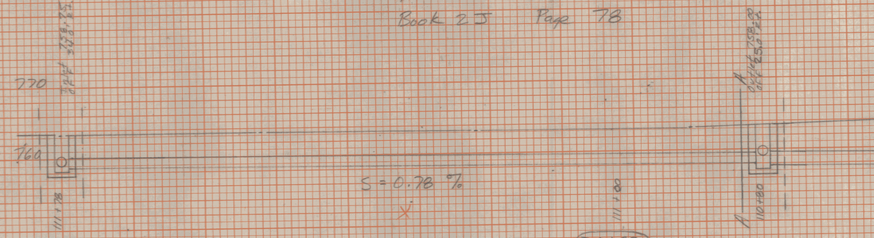

110+81 ~ 111+77 Rt. (DS192)
18" x 96' RCP Cl. II w/RCDI @ Inlet
Book 25 Page 70

Trench Earth
Pipe 0'-5' = 460# x 3.7' x 1/27 = 66.4 c.y.
D.I. 0'-5' = 6'x6'x5' x 1/27 = 6.7 c.y.
D.I. over 5' = 6'-6'x1'x1.5 x 1/27 = 2.0 c.y.
Total Trench Earth = 75.1 c.y.
S.G.N. 7-22-91

Village Stormwater System

Troy 25 (R.I.C.D.)
Drainage Sheet #38

PLATE 3 CROSS SECTION O. P. R. & R. E. STANDARD
DIETZGEN CORPORATION

378 DRAIN