1983
(2003)

Traffic Data
Junction Vt. Rte. 118, Vt Rte. 58 & TH 26.

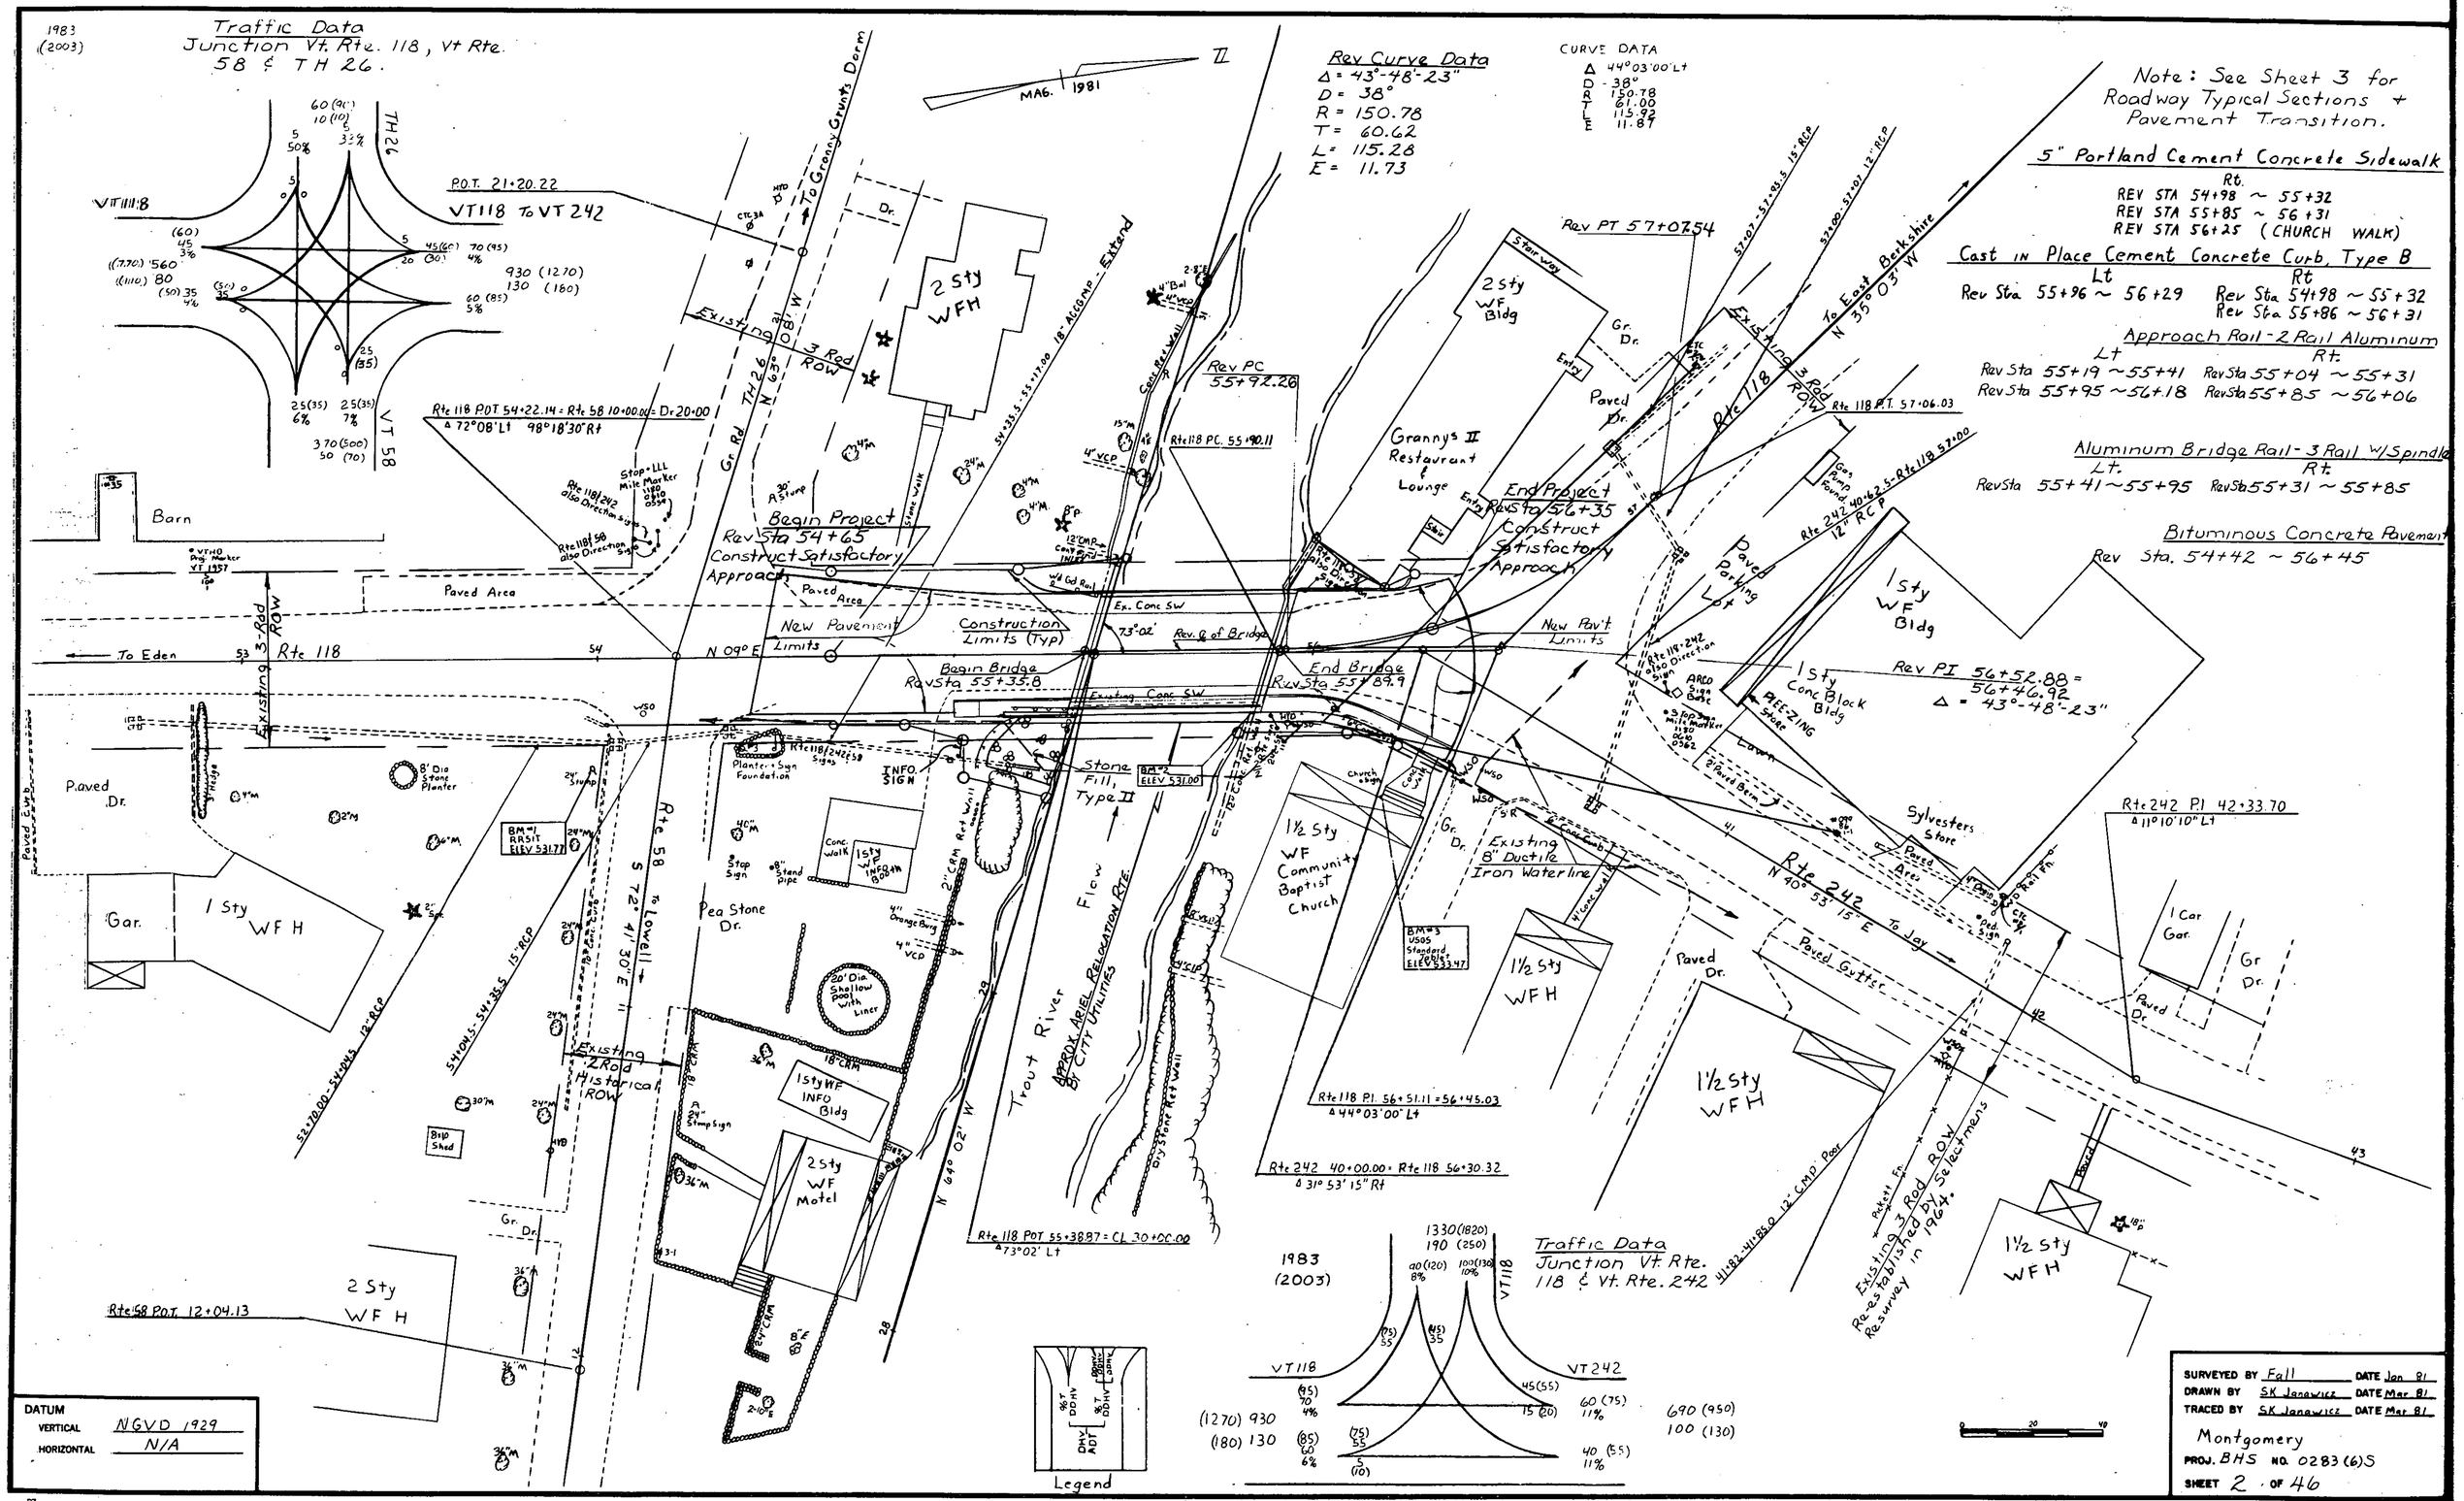

DATUM
VERTICAL NGVD 1929
HORIZONTAL N/A

SURVEYED BY Fall DATE Jan 81
DRAWN BY SK Janowicz DATE Mar 81
TRACED BY SK Janowicz DATE Mar 81
Montgomery
PROJ. BHS NO. 0283 (6) S
SHEET 2 OF 46