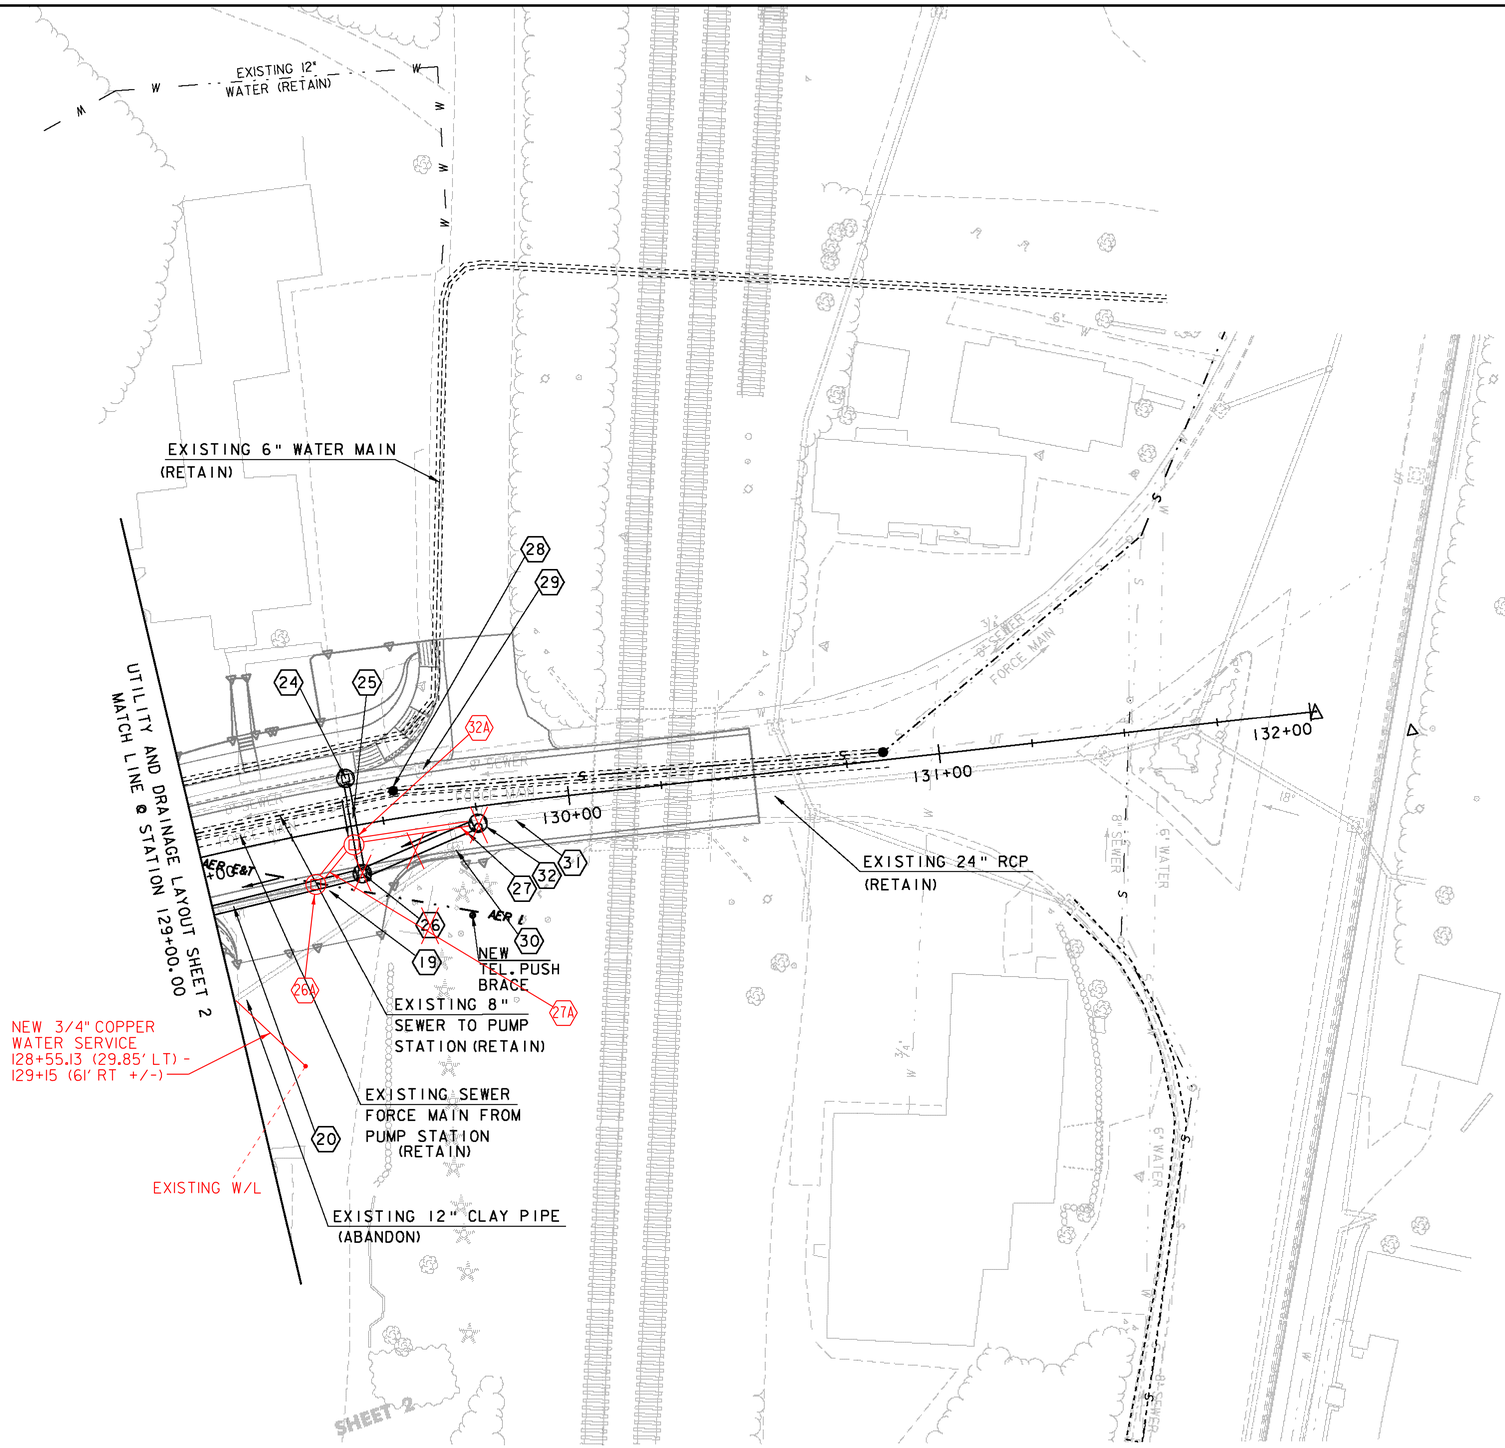

NOTE : SEE PIPE PROFILE SHEET 2, MAINLINE CROSS SECTIONS, AND DRAINAGE DETAIL SHEET FOR ADDITIONAL INFORMATION ON STORMWATER CATCH BASINS, MANHOLE, AND PIPES.

N

VT STATE PLANE GRID

27A VT 107 STA 129+33 RT~129+42 RT
NEW 24" x 5' CPEP

DRAINAGE

19 VT 107 STA 129+00.00 RT ~ 129+68.00 RT
REMOVE 24" LENGTH 123'-6" RCP

20 VT 107 STA 129+00.00 RT ~ 129+~~42~~ 33.00 RT
NEW 24" LENGTH 96'-6" CPEP/CAAP/PCCSP

24 NEW CB AT 129+42.00 LT

25 VT 107 STA 129+42.00 LT ~ 129+42.00 RT
NEW 12" LENGTH ~~23'-0"~~ 16'-0" CPEP/CAAP/PCCSP

26A 26 NEW CB AT 129+~~42~~ 33.00 RT
OFFSET 13'-0"

27 VT 107 STA 129+42.00 RT ~ 129+~~75~~ 74.00 RT
NEW 24" LENGTH ~~32'-5"~~ 30'-0" CPEP/CAAP/PCCSP
W/FURNCO SLEEVE CONNECTING CPEP TO EXISTING RCP

28 ADJUST SEWER MANHOLE COVER ELEVATION AT
VT 107 STA 129+54.00 LT

29 VT 107 STA 129+63.00 LT
REMOVE EXISTING CAST IN PLACE DI

30 VT 107 STA 129+68.00 RT
REMOVE EXISTING CAST IN PLACE DI

31 VT 107 STA 129+68.00 RT ~ 129+~~75~~ 74.00 RT
REMOVE 24" (CUT) LENGTH 7'-0" RCP

32A 32 NEW MH AT 129+~~75~~ 42.00 RT
OFFSET 4'-6"

CB = DENOTES PRECAST REINFORCED CONCRETE CATCH BASIN
DI = DENOTES DROP INLET
MH = PRECAST REINFORCED CONCRETE MAN HOLE WITH CAST IRON COVER

SCALE 1" = 20'-0"
20 0 20

UTILITIES AND DRAINAGE LAYOUT SHEET 3

PROJECT NAME:	BETHEL
PROJECT NUMBER:	BRF 022-1(14)
FILE NAME: s78f161ut11bdr.dgn	PLOT DATE: 20-MAY-2011
PROJECT LEADER: M. EVANS-MONGEON	DRAWN BY: G. ROKES
DESIGNED BY: G. ROKES	CHECKED BY: S. SCRIBNER
UTILITIES AND DRAINAGE LAYOUT SHEET 3	SHEET 24 OF 148