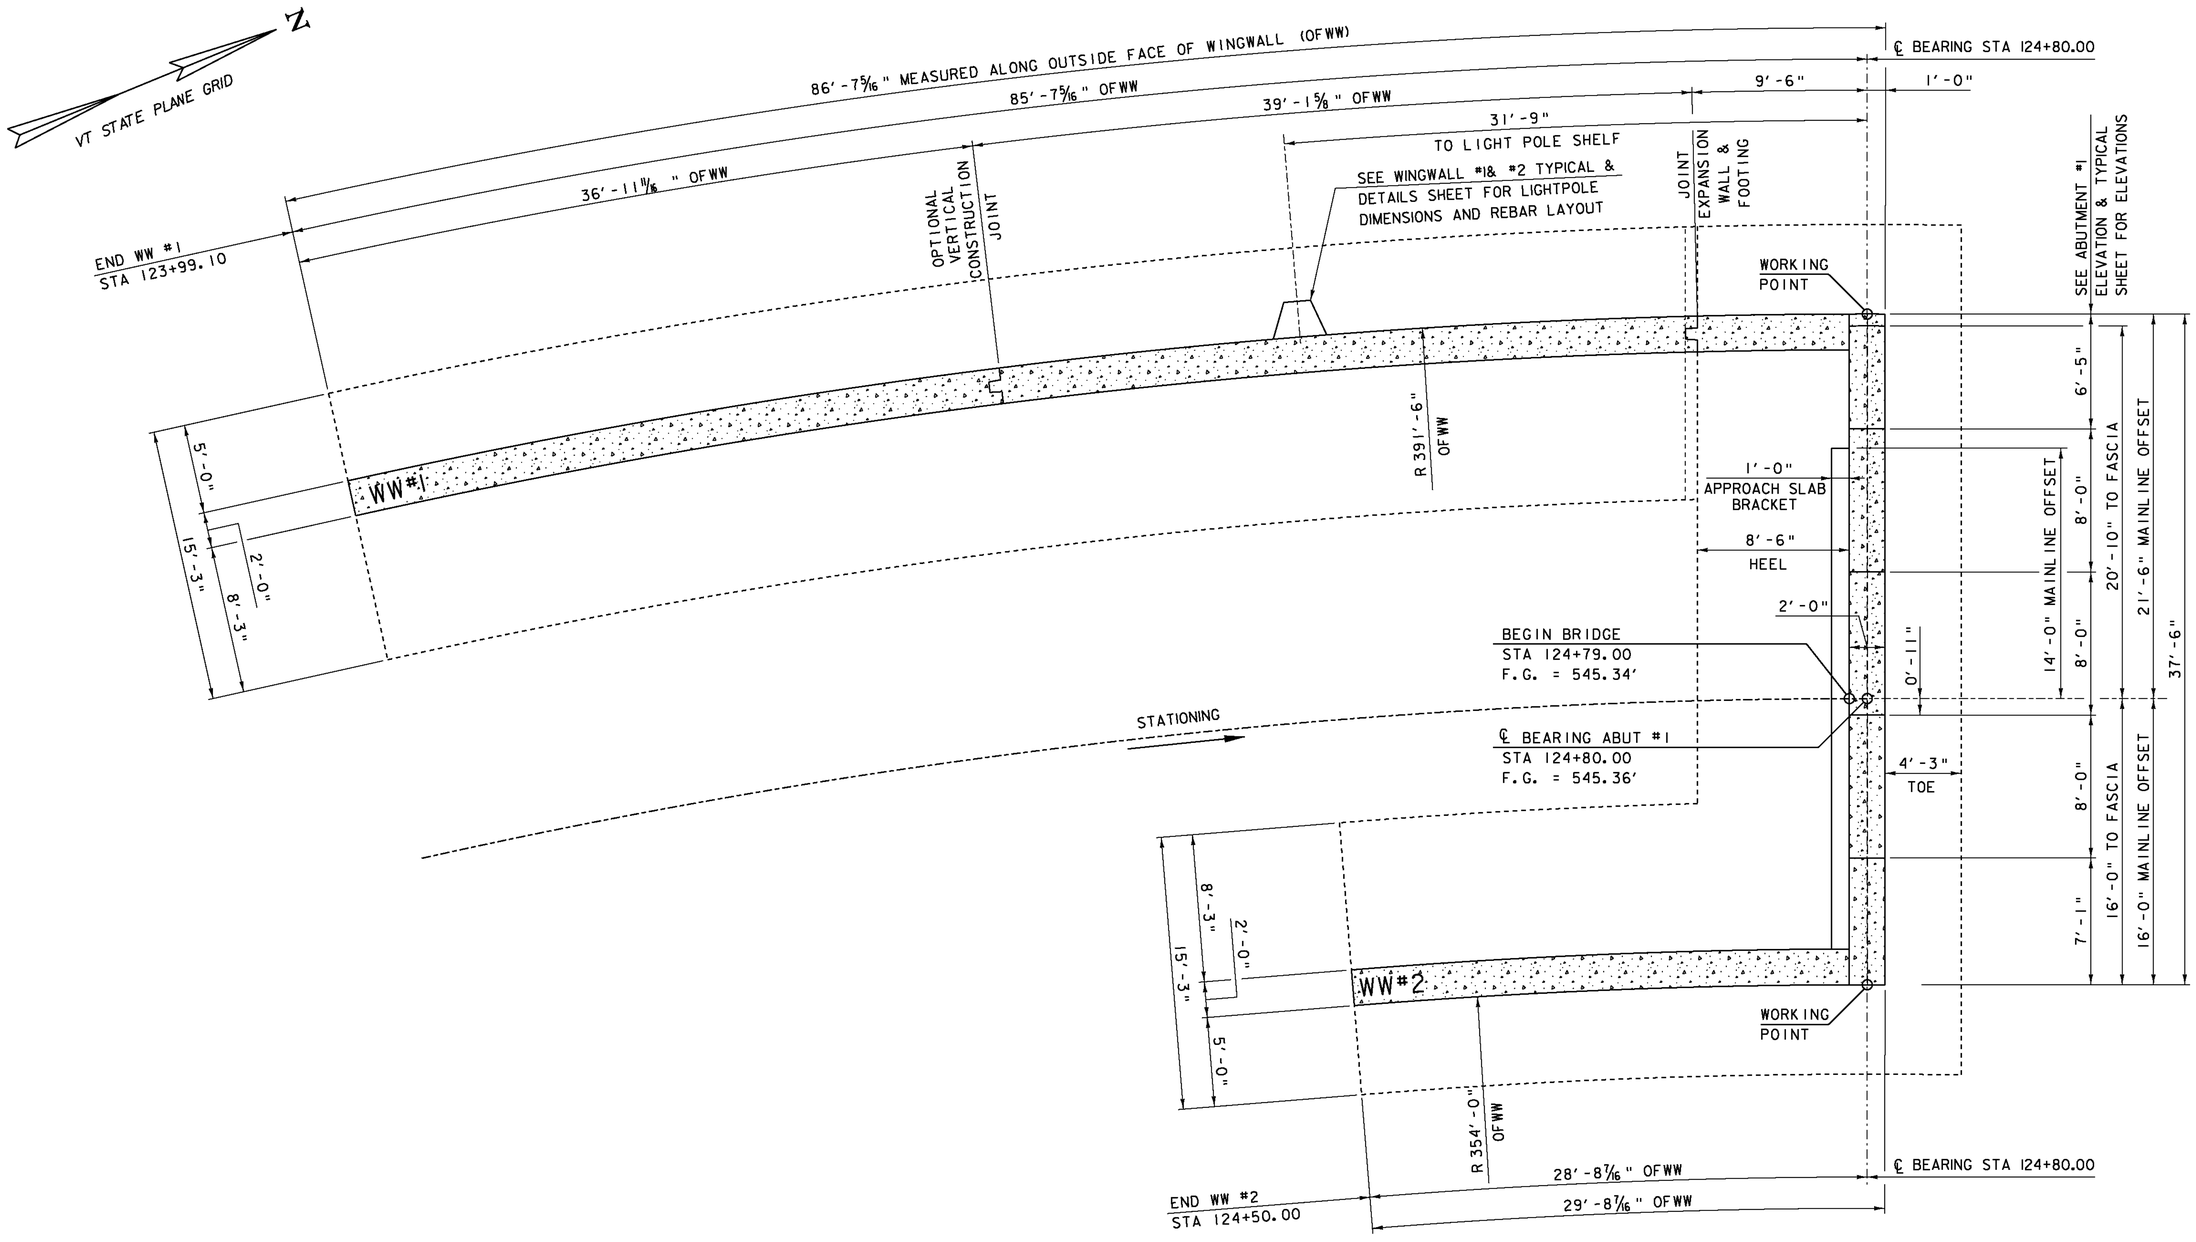

ABUTMENT #1 PLAN VIEW

SCALE 1/4" = 1'-0"

PROJECT NAME: BETHEL	
PROJECT NUMBER: BRF 022-1(14)	
FILE NAME: s78f161subl.dgn	PLOT DATE: 20-MAY-2011
PROJECT LEADER: M. EVANS-MONGEON	DRAWN BY: M. LONGSTREET
DESIGNED BY: N. VANDENBERG	CHECKED BY: S. SCRIBNER
ABUTMENT #1 PLAN	SHEET 59 OF 148