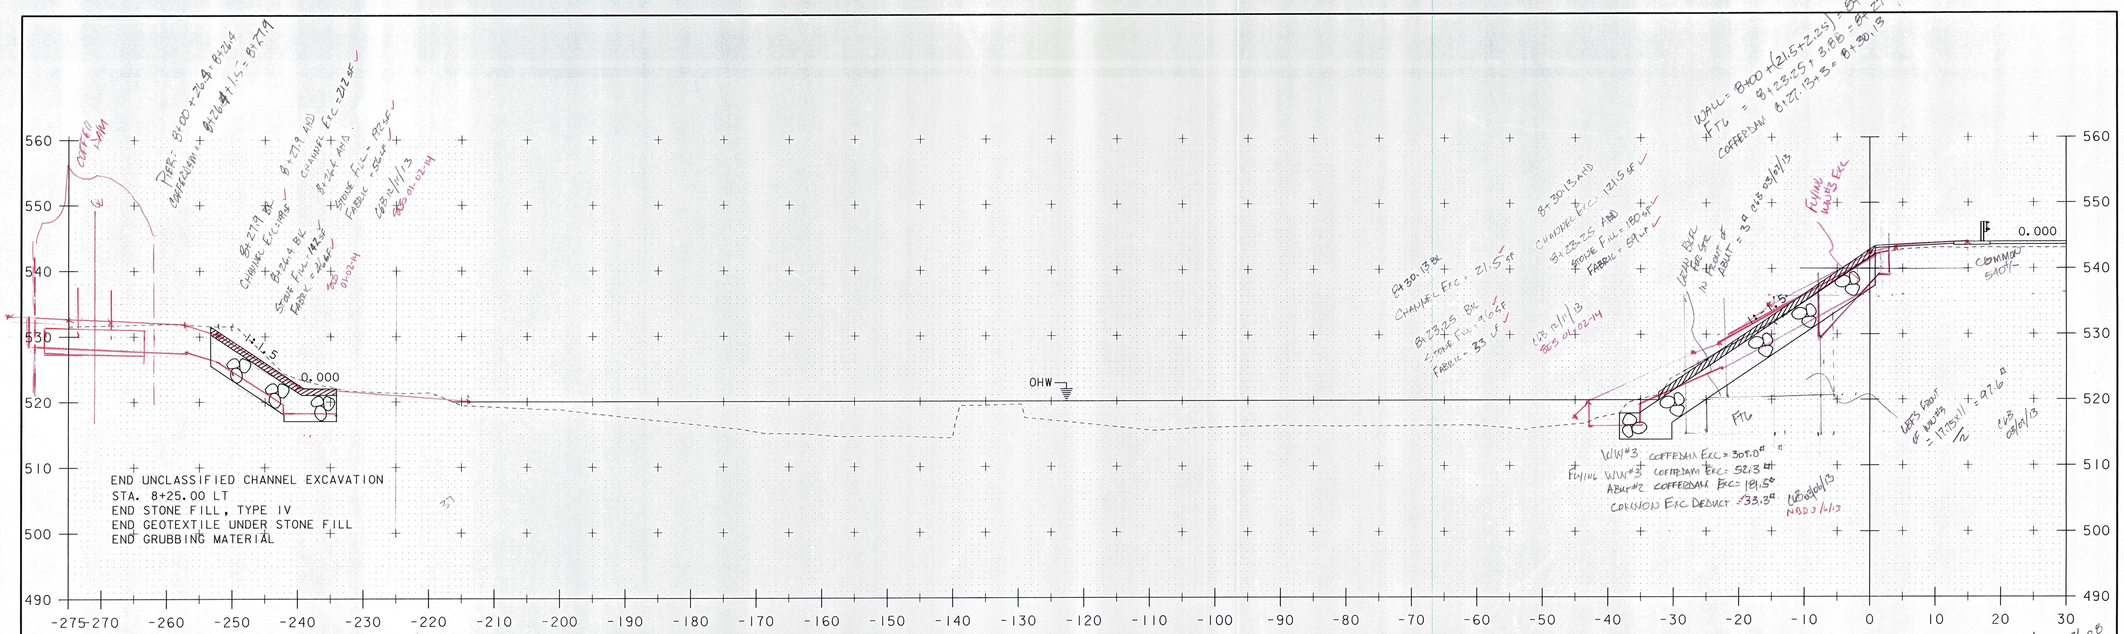

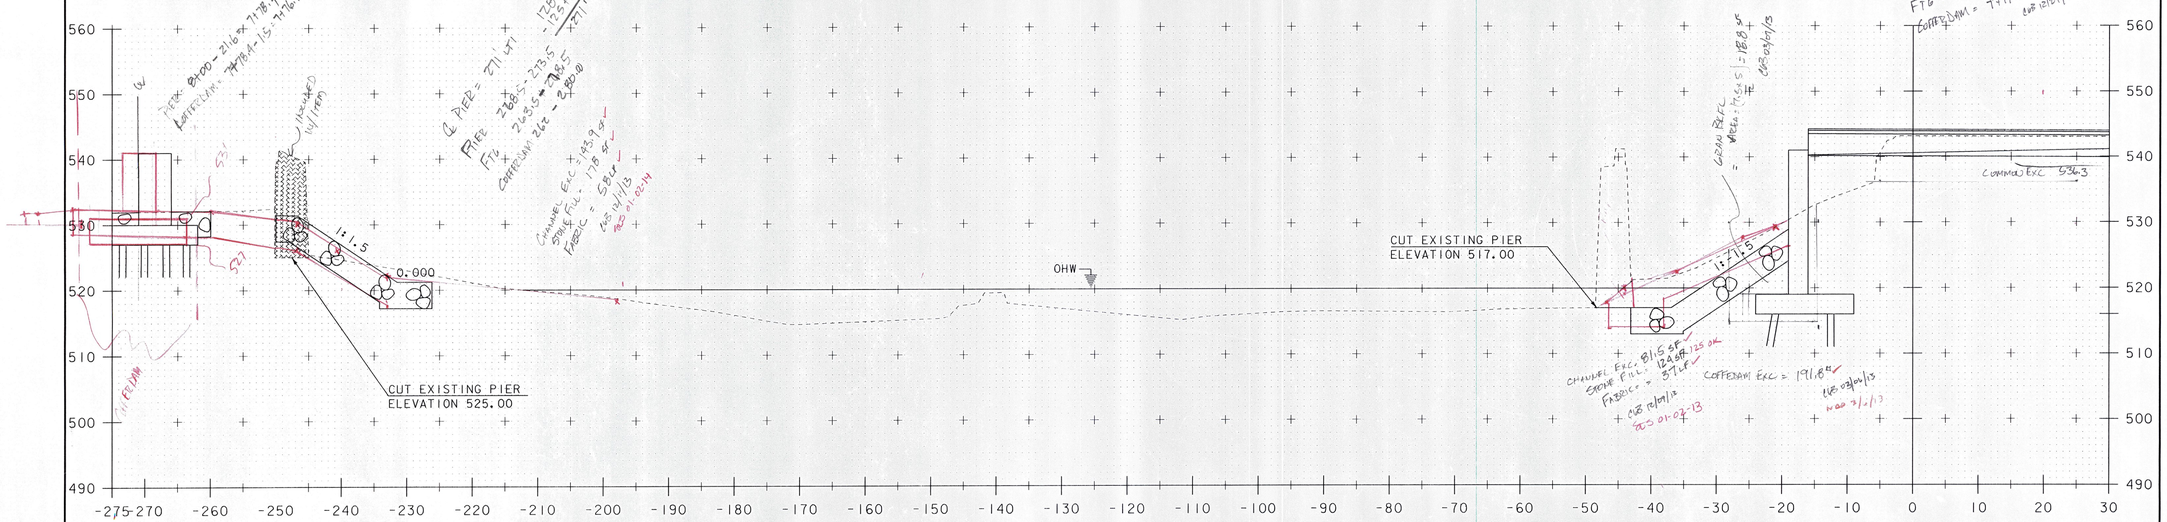

SCALE 1" = 10'-0

CHANNEL CROSS SECTIONS SHEET 3

PROJECT NAME: BETHEL	
PROJECT NUMBER: BRF 022-1(14)	
FILE NAME: 78f161\STR\sf161xs.dgn	PLOT DATE: 26-MAY-2011
PROJECT LEADER: M. EVANS-MONGEON	DRAWN BY: G. ROKES
DESIGNED BY: S. SCRIBNER	CHECKED BY: S. SCRIBNER
CHANNEL CROSS SECTIONS SHEET 3	SHEET 120 OF 148