



8+50

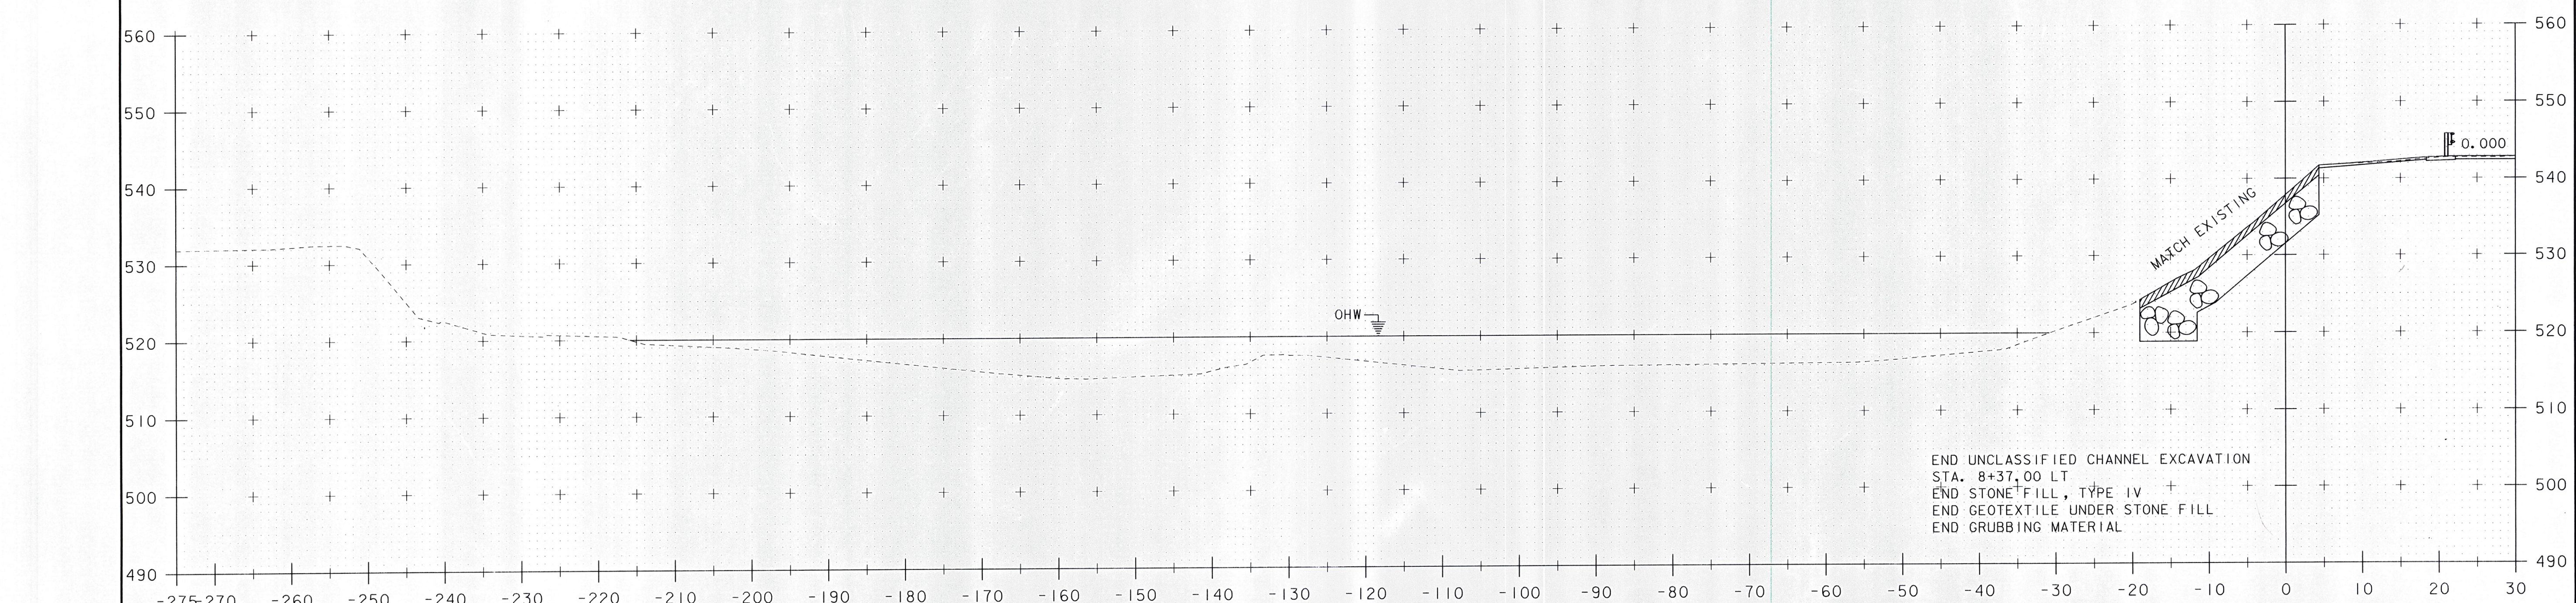

8+37

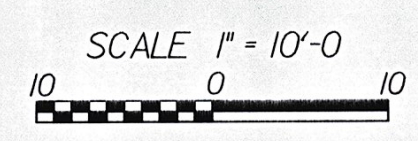

CHANNEL CROSS SECTIONS SHEET 4

PROJECT NAME:	BETHEL
PROJECT NUMBER:	BRF 022-1(14)
FILE NAME:	78f161\STR\sf161xs.dgn
PROJECT LEADER:	M. EVANS-MONGEON
DESIGNED BY:	S. SCRIBNER
CHANNEL CROSS SECTIONS SHEET 4	
PLOT DATE:	26-MAY-2011
DRAWN BY:	G. ROKES
CHECKED BY:	S. SCRIBNER
SHEET	121 OF 148